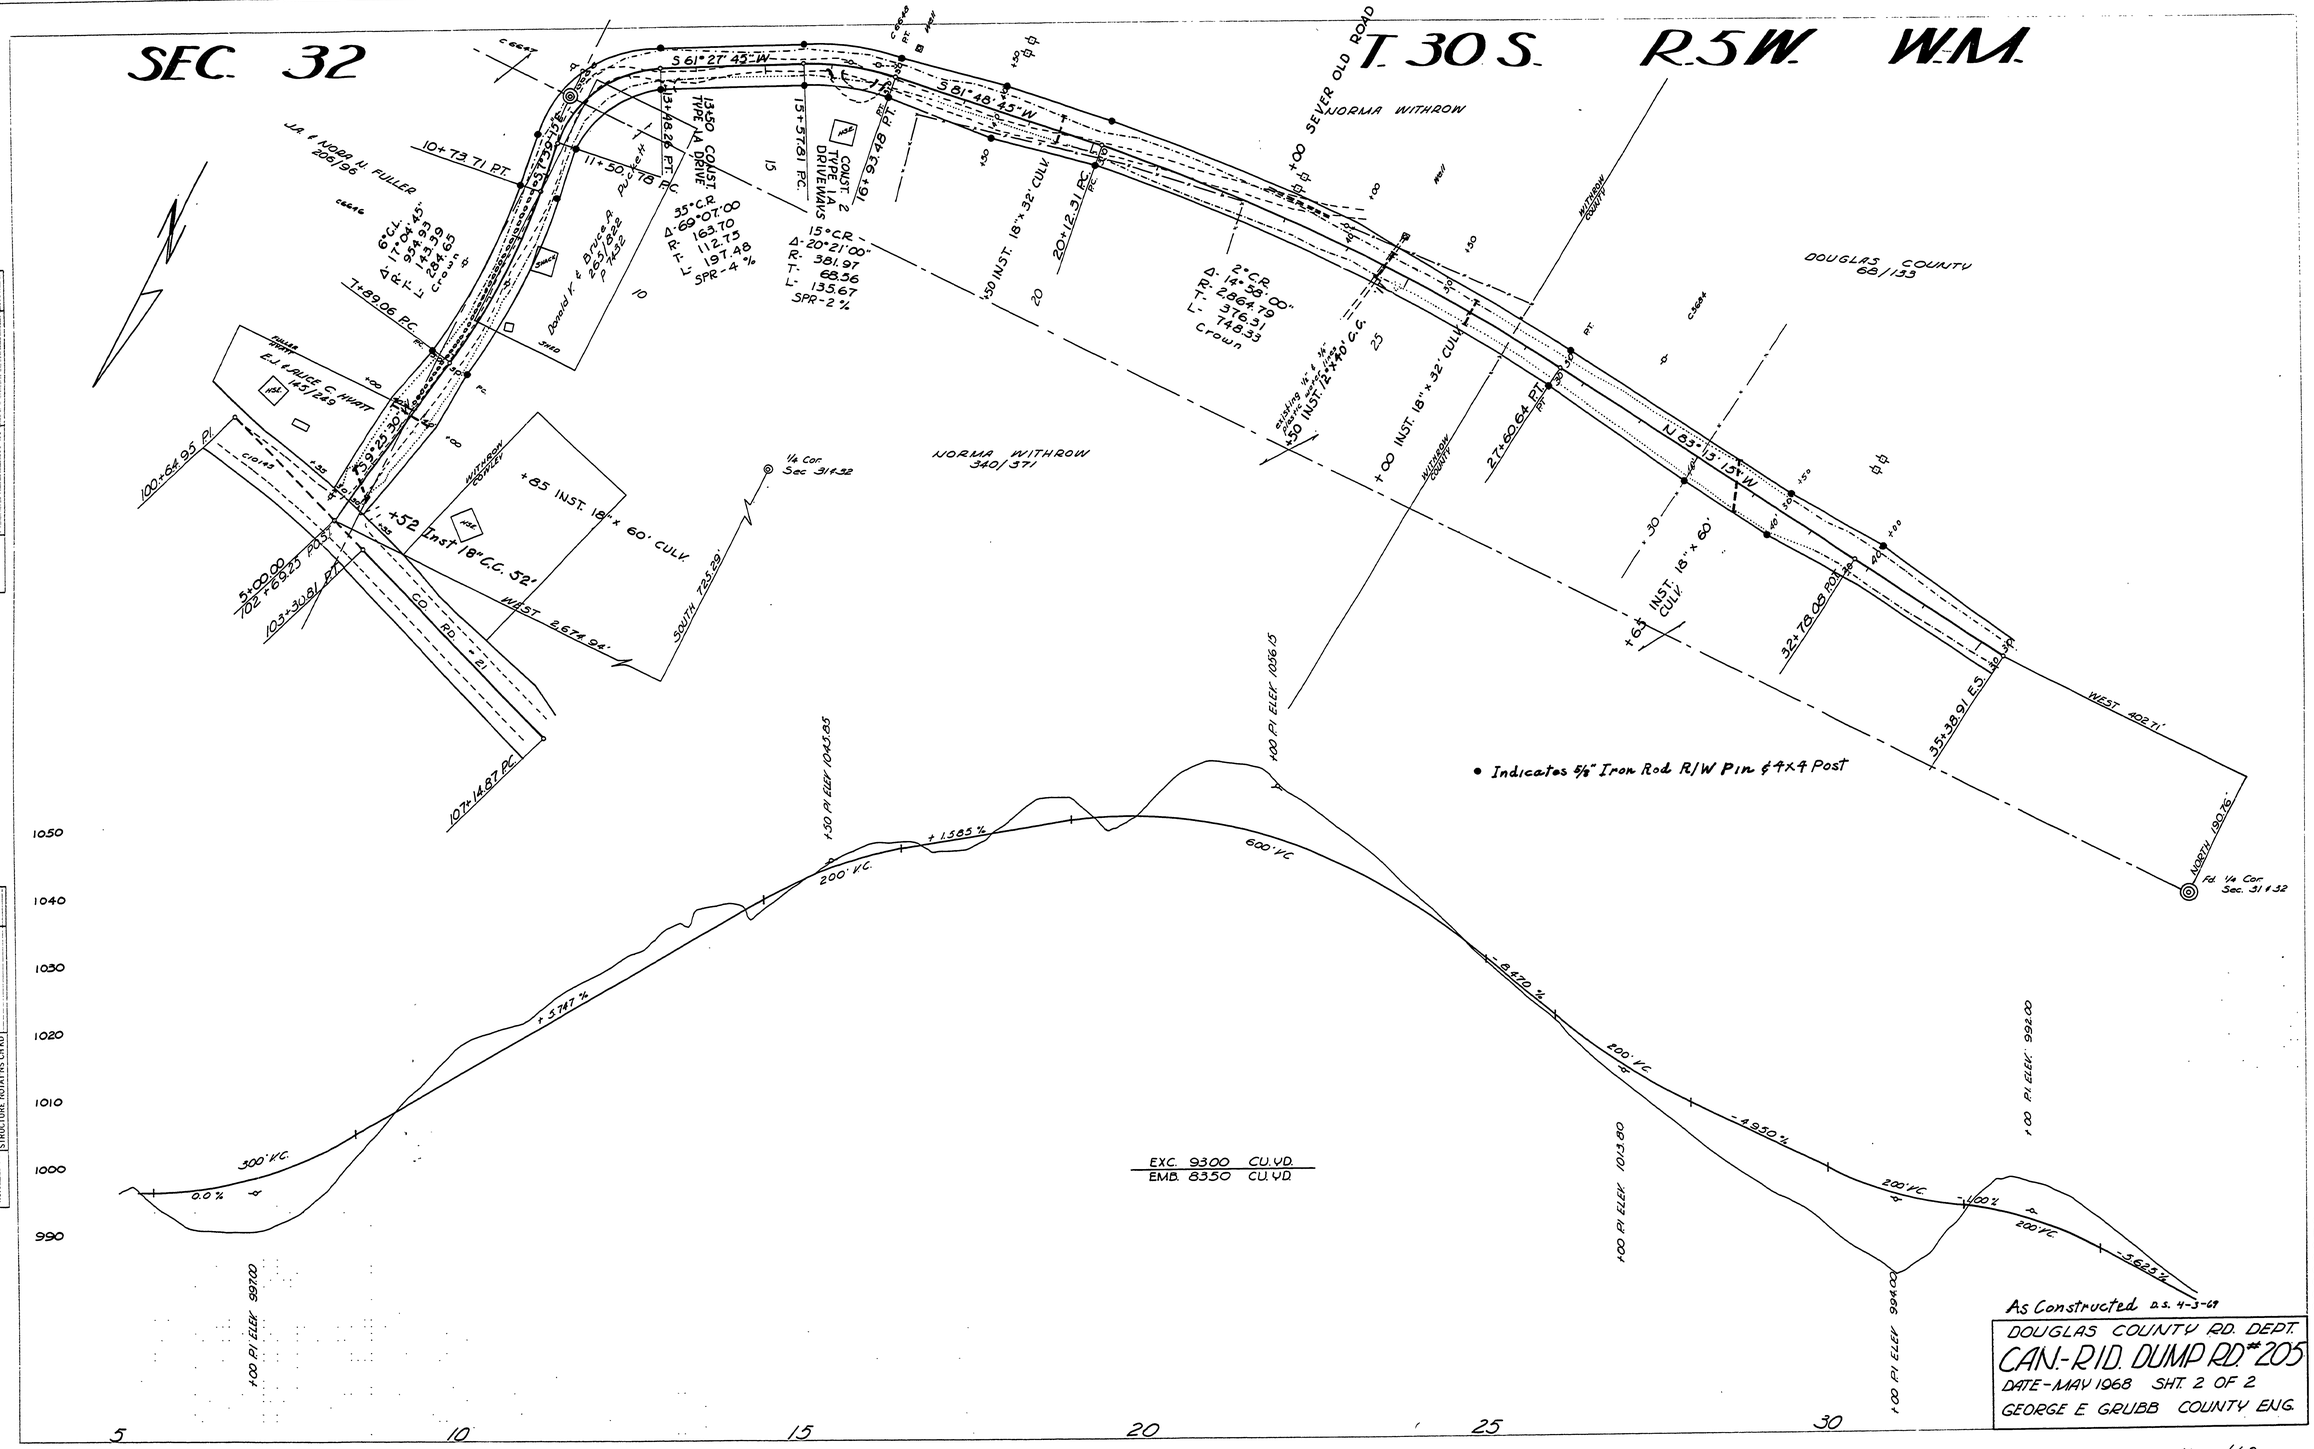

As Constructed D.S. 4-3-69

DOUGLAS COUNTY RD. DEPT.

CAN-RID. DUMP RD. #205

DATE-MAY 1968 SHT. 2 OF 2

GEORGE E. GRUBB COUNTY ENG.

PLAN — SURVEYED / PLOTTED / RED-VERN CHECKED / RED-VERN CHECKED — NOTE BOOK NO. — DATE — BY

PROFILE — SURVEYED / PLOTTED / GRADES CHECKED / BY / STRUCTURE NOTATIONS CHKD — NOTE BOOK NO. — DATE — BY

00000058

M.P. 0.00 - 0.58

Co. Rd. #205 sht. 2 of 2 — May, '68

38