



HORIZ. SCALE: 1" = 50' VERT. SCALE: 1" = 5'


NOTE
Construct 20 foot wide driveways to within 50 feet of houses on Lots 2 and 3.

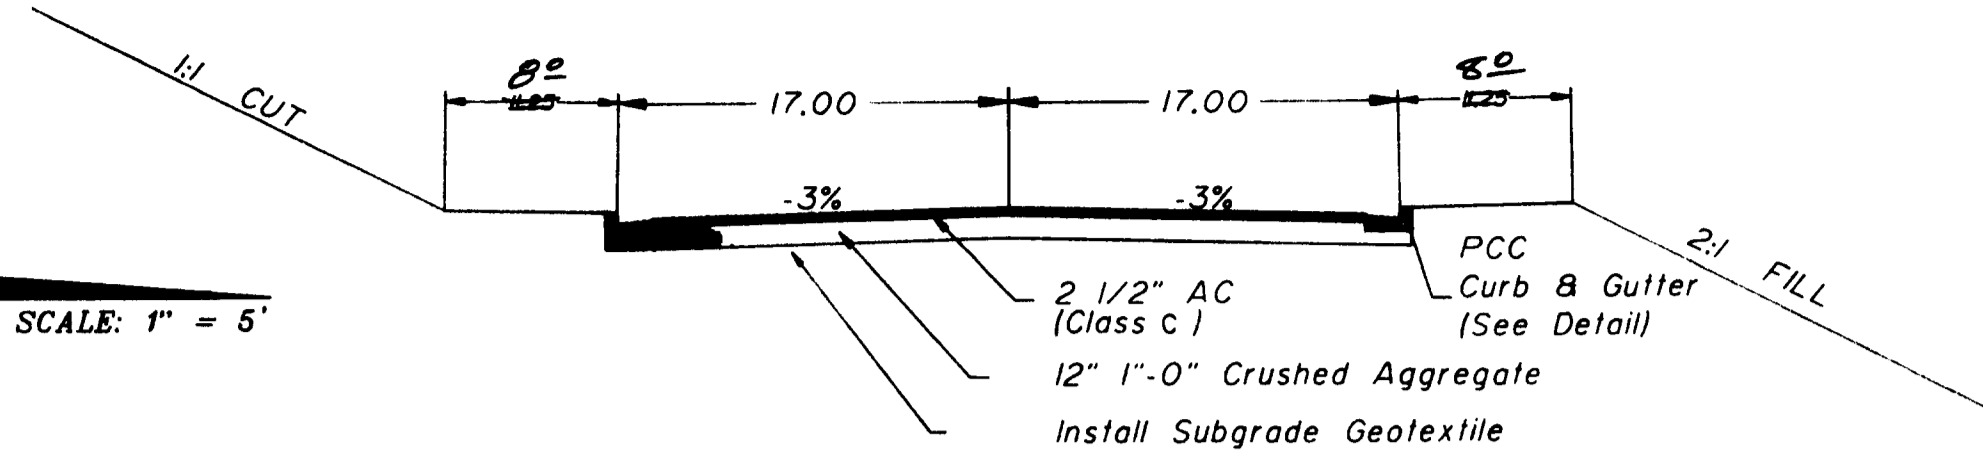


TYPICAL STREET SECTION
NTS

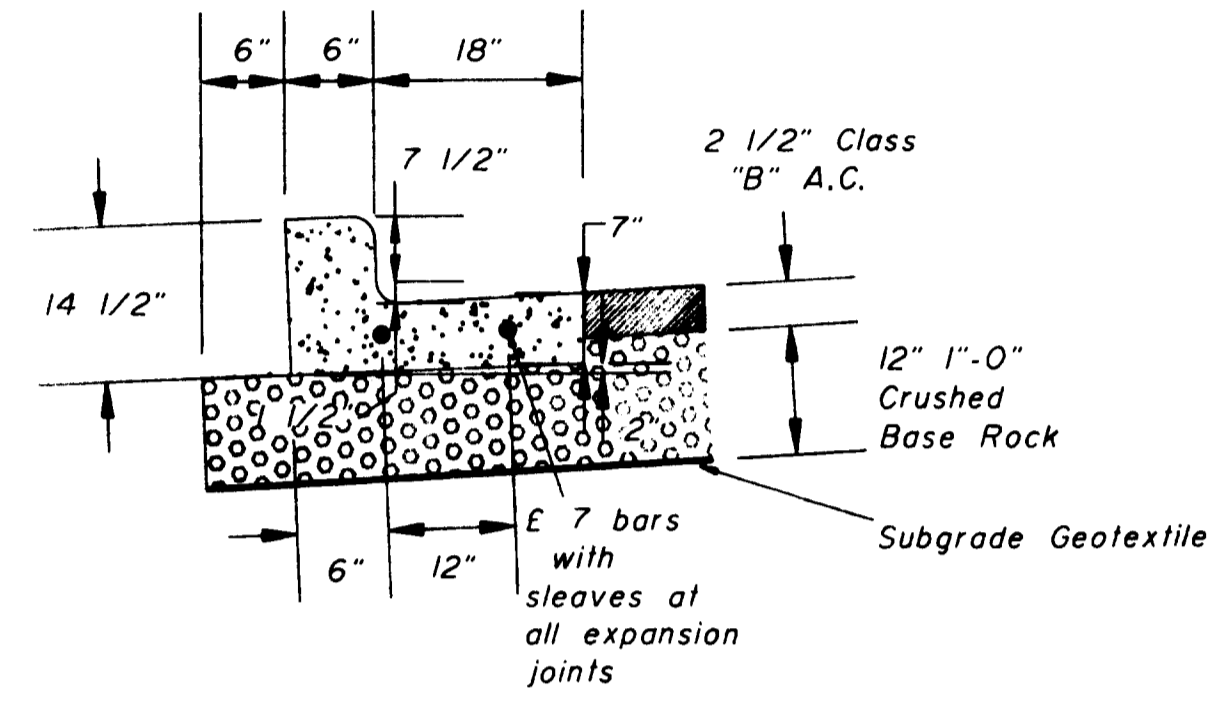

DOUGLAS COUNTY TYPE CURB SECTION
NTS

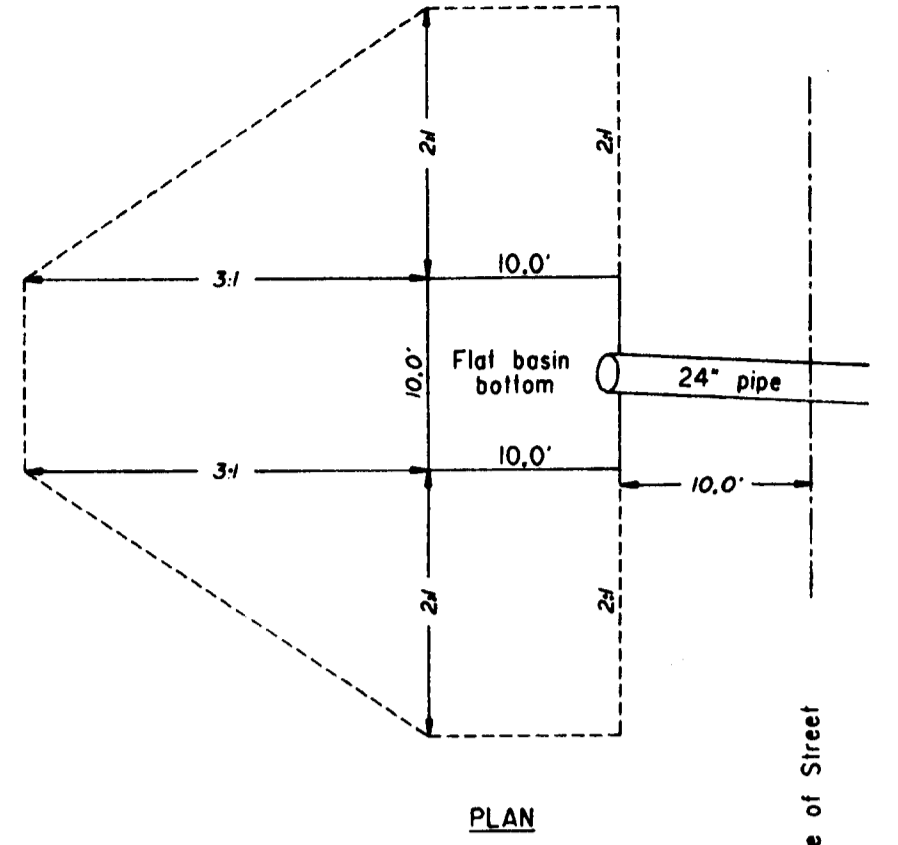


PLAN

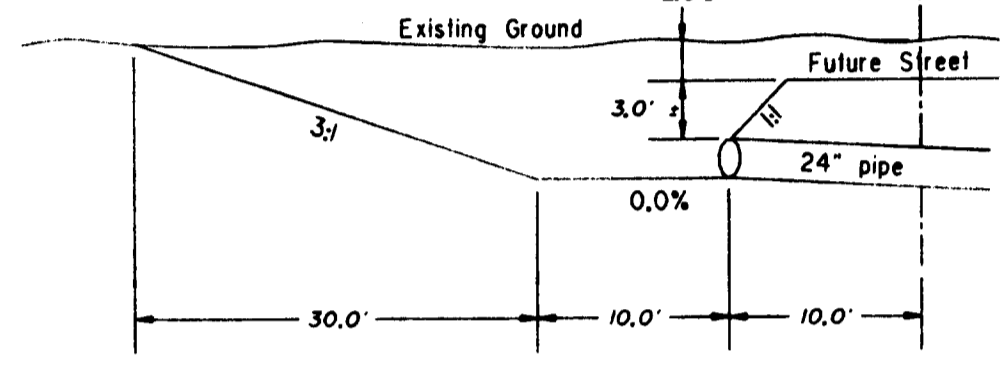




PROFILE

TYPICAL STORM DRAIN ENTRY BASIN
NTS

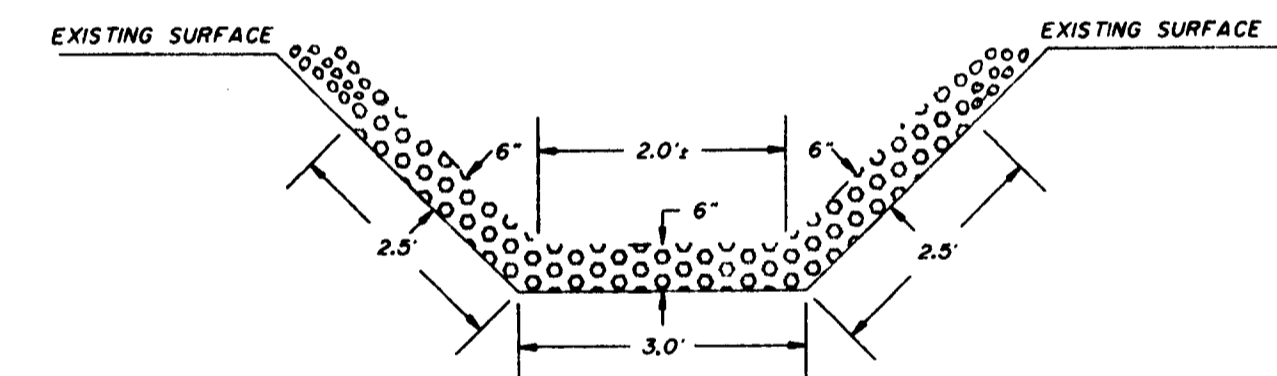

TYPICAL DRAIN DITCH
NTS

- STREET CONSTRUCTION NOTES**
- All work shall be in conformance with Douglas County Public Works Department specifications, which are generally those of the Oregon Department of Transportation.
 - Douglas County Public Works will inspect construction and the contractor will furnish ample notice to the County prior to commencing various construction phases.
 - Street subgrade and base shall be compacted to 95% relative compaction. Unstable or unsuitable material shall be removed and replaced with suitable selected material.
 - Concrete shall be class 5 1 1/2" max. aggregate size with 6 sacks cement per cubic yard of concrete, with a minimum compressive strength not less than 3000 p.s.i at 28 days, when tested in accordance with ASTM C-39-66.
 - Contractor will coordinate with Pacific Power & Light and U.S. West Communications (telephone) for underground utility installation.

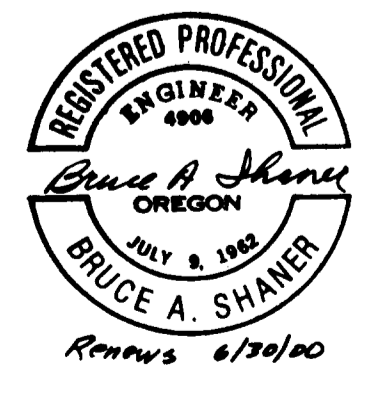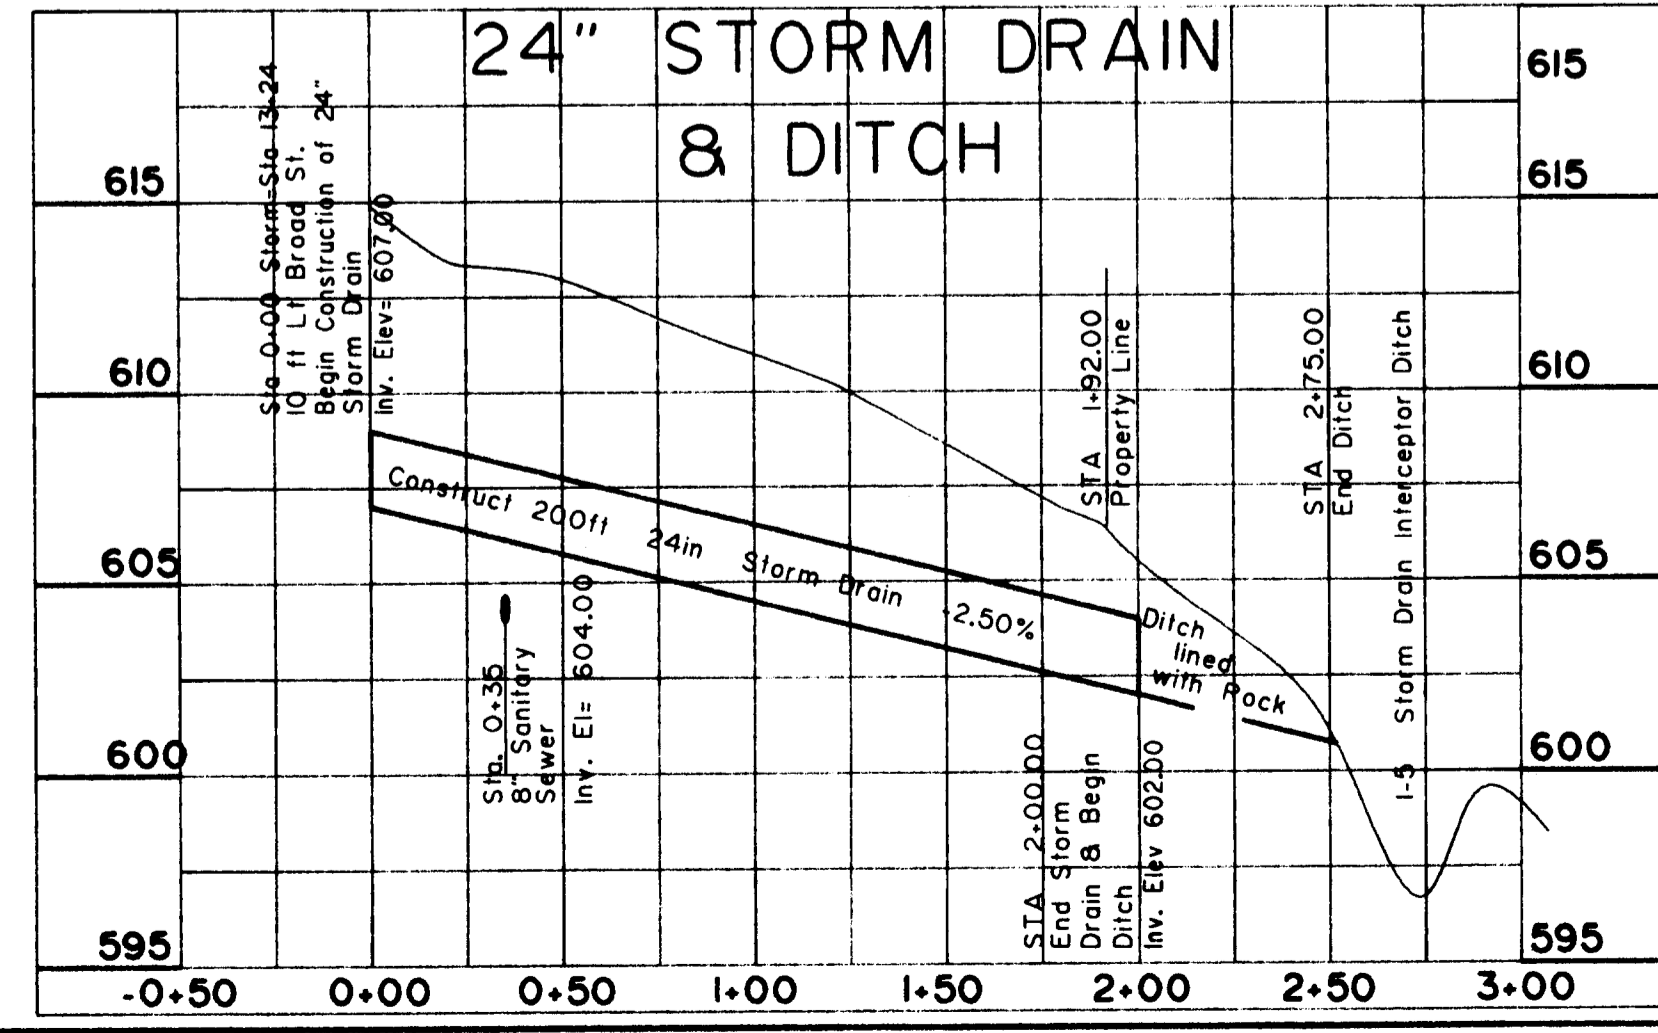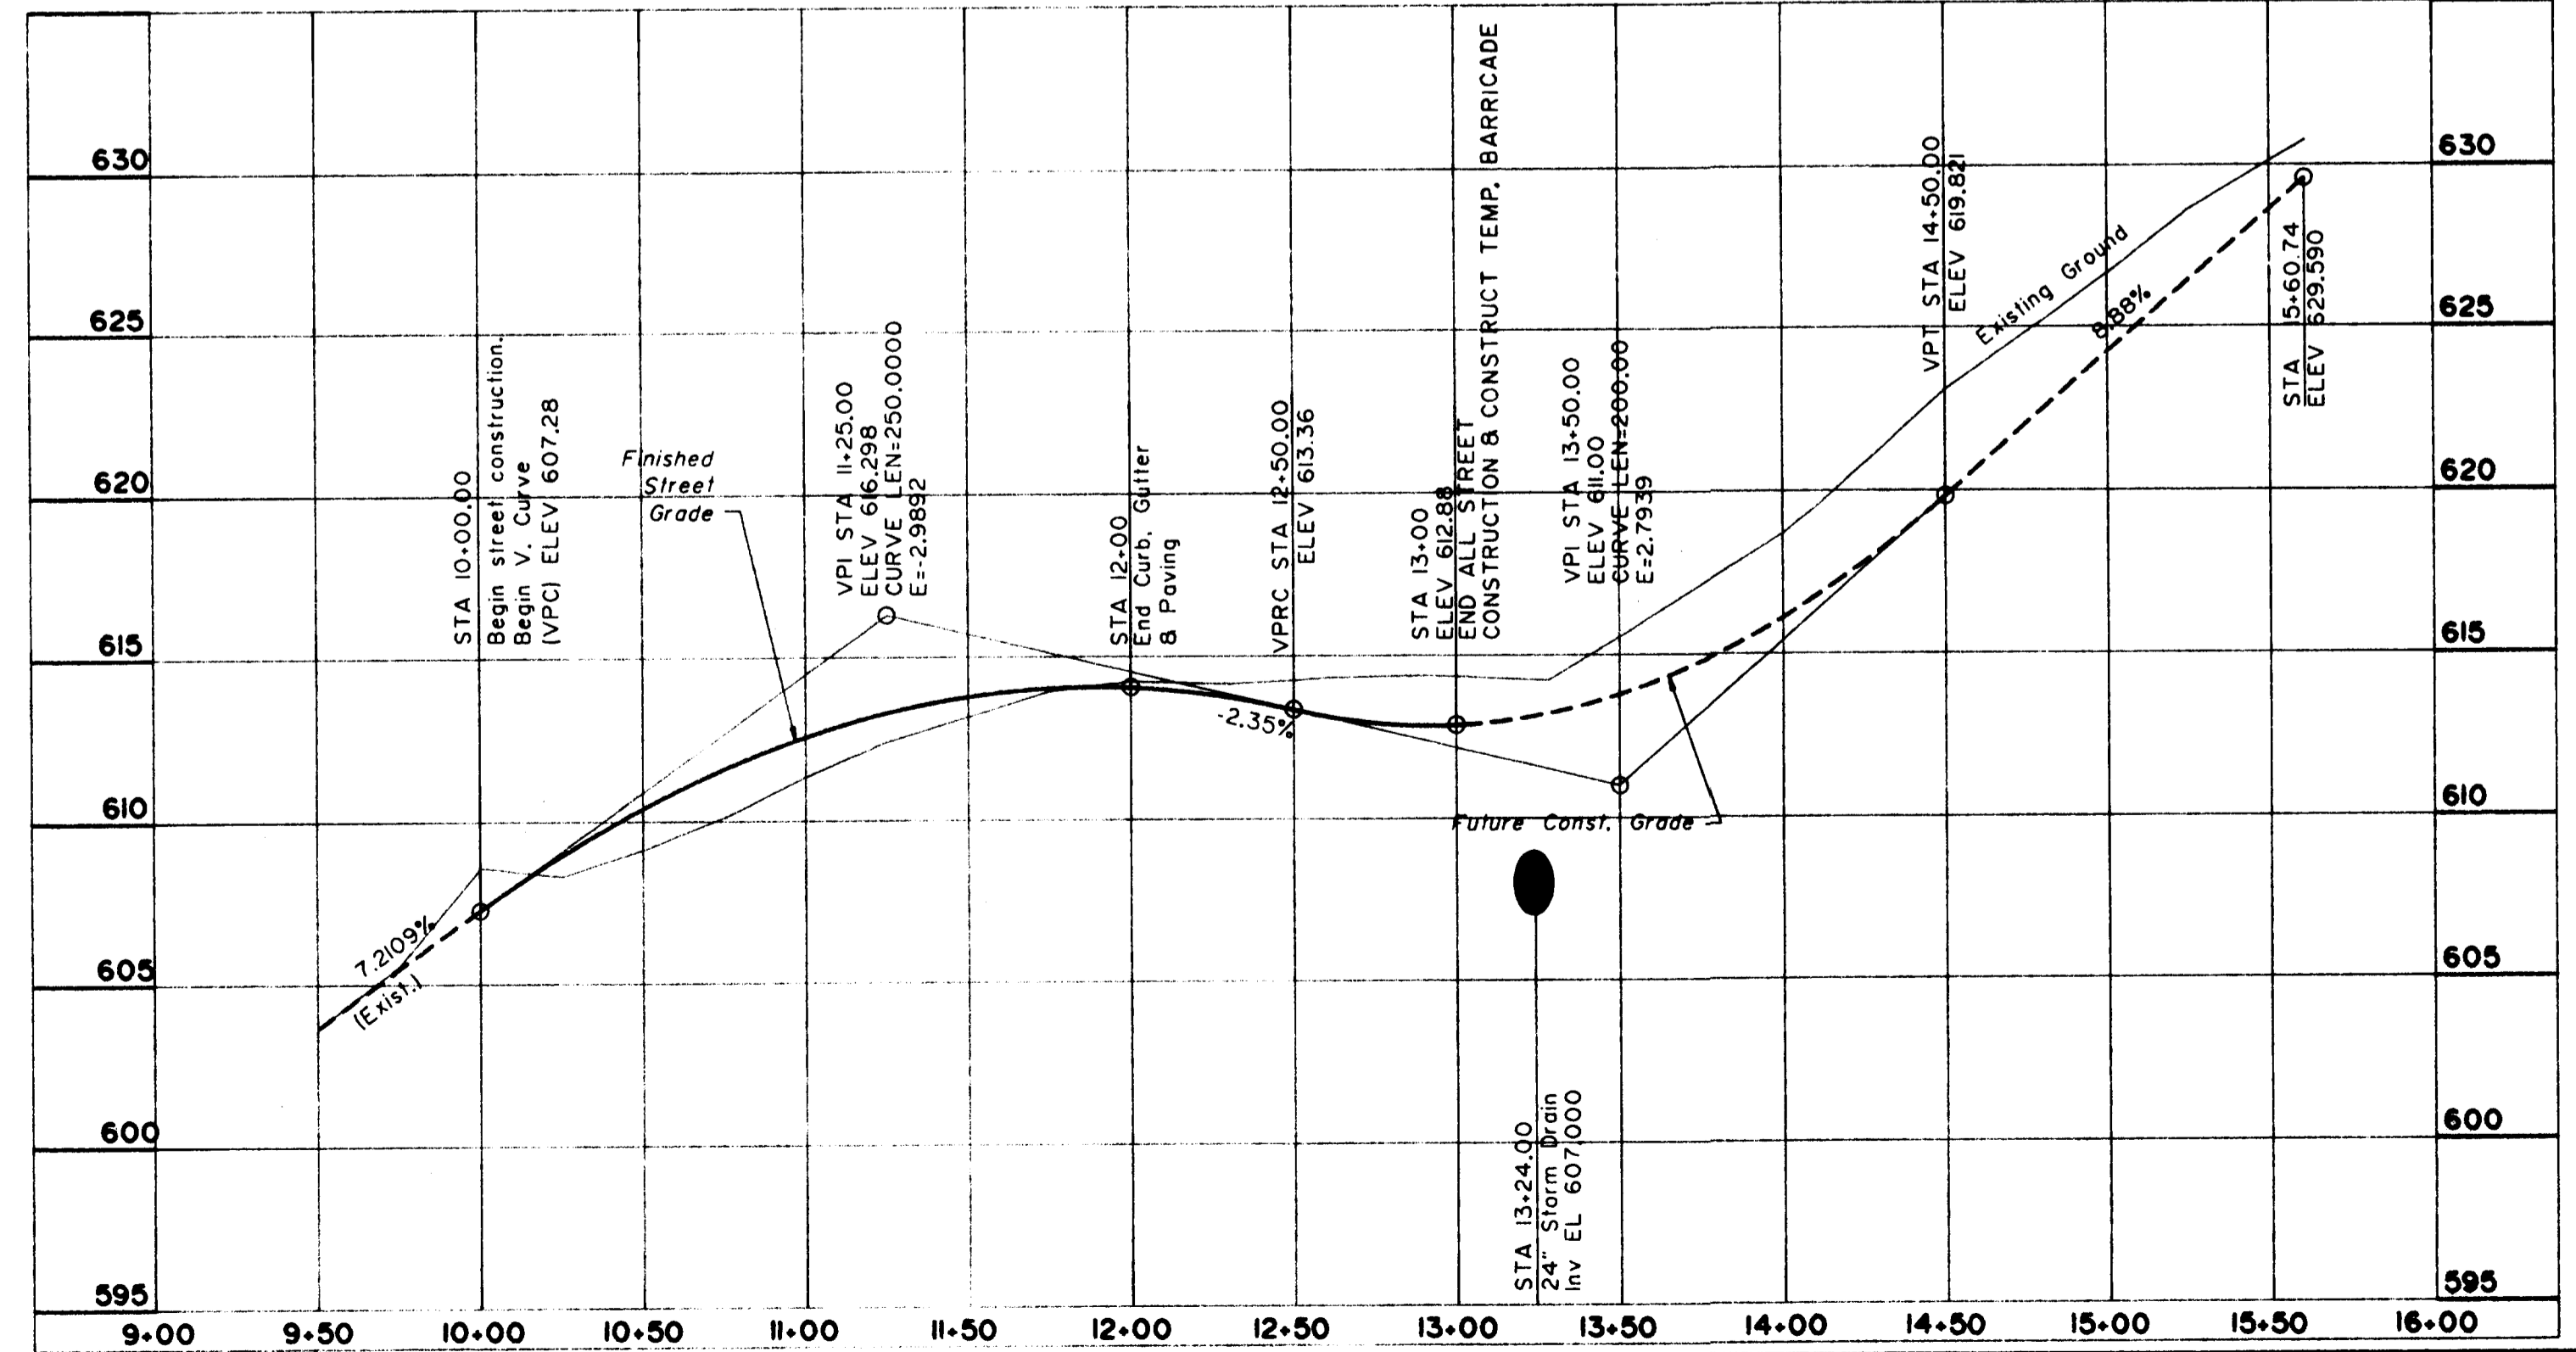

FILED
Date: 7-5-2000 By: JP
This survey consists of:
Map:
Narrative:
Corner Rpt:
DOUGLAS COUNTY SURVEYOR

SHT. NAME Douglas County Dept. of Public Works
Broad Street Extension
Approved: Douglas County Dept. of Public Works Date

PROJECT GRACE SUBDIVISION
Owner: Roseburg Assembly of God
518 N.E. Nash Street
Roseburg, Oregon 97470
By: Shaner Engineering, Inc.
P.O. Box 1430
Roseburg, Oregon 97470
AS
CONSTRUCTED
September 30, 1999

SHT. NO. 1 of 3
217A0104