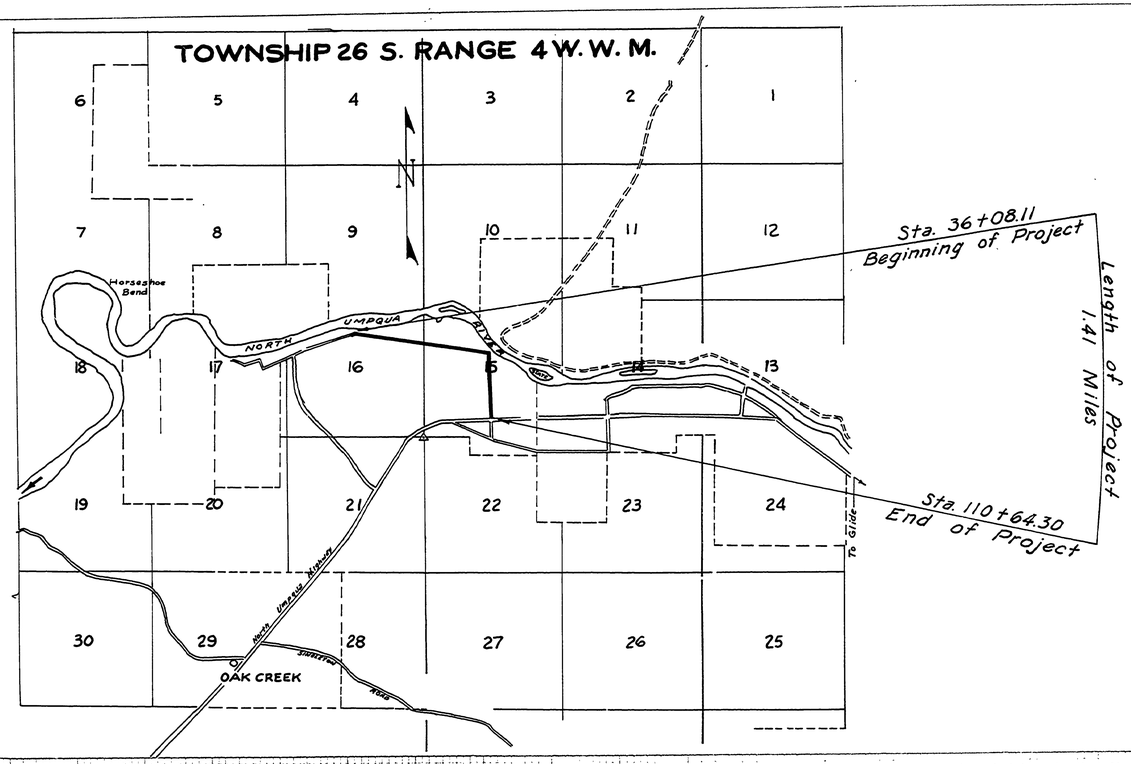

FILED
RECEIVED
FEB 1 1965
COUNTY SURVEYOR
DOUGLAS COUNTY, ORE.

DOUGLAS COUNTY, OREGON

PLANS FOR CONSTRUCTED PROJECT

GRADING AND SURFACING

WHISTLER'S BEND

COUNTY ROAD NO. 223

SEPTEMBER 1958

REGISTERED PROFESSIONAL ENGINEER 4250 OREGON MAY 2, 1958 GEORGE E. GRUBB

Approved by [signature] Nov. 24, 1964
Judge

Approved by the County Court Nov. 25, 1964
[signature]
Commr.
[signature]
Commr.
[signature]
Commr.

FINAL SURVEY				
NOTE BOOK	SURVEYED			DATE
	PLOTTED			
	TEMPLATE			
	AREAS			
NO	AREAS CHECKED			

ORIGINAL SURVEY				
NOTE BOOK	SURVEYED			DATE
	PLOTTED			
	TEMPLATE			
	AREAS			
NO	AREAS CHECKED			

0210035C

Sheet 1 of 4

PLATE 4 CROSS SECTION B. P. R. & R. E. STANDARD
DREW DETZER 27 CHICAGO NEW YORK

G. Rd. #223 Sept. '58 sheet 1 of 4 (60)