AS-BUILT PLANS 11/2002

FILED
Date: 3/6/2003 By: JP
This survey consists of:
Map: _____
Notes: _____
Corner Rept: _____
DOUGLAS COUNTY SURVEYOR

Subdivision consists of 7 lots
5 on west side of Rolling Hills
2 on east side of Rolling Hills

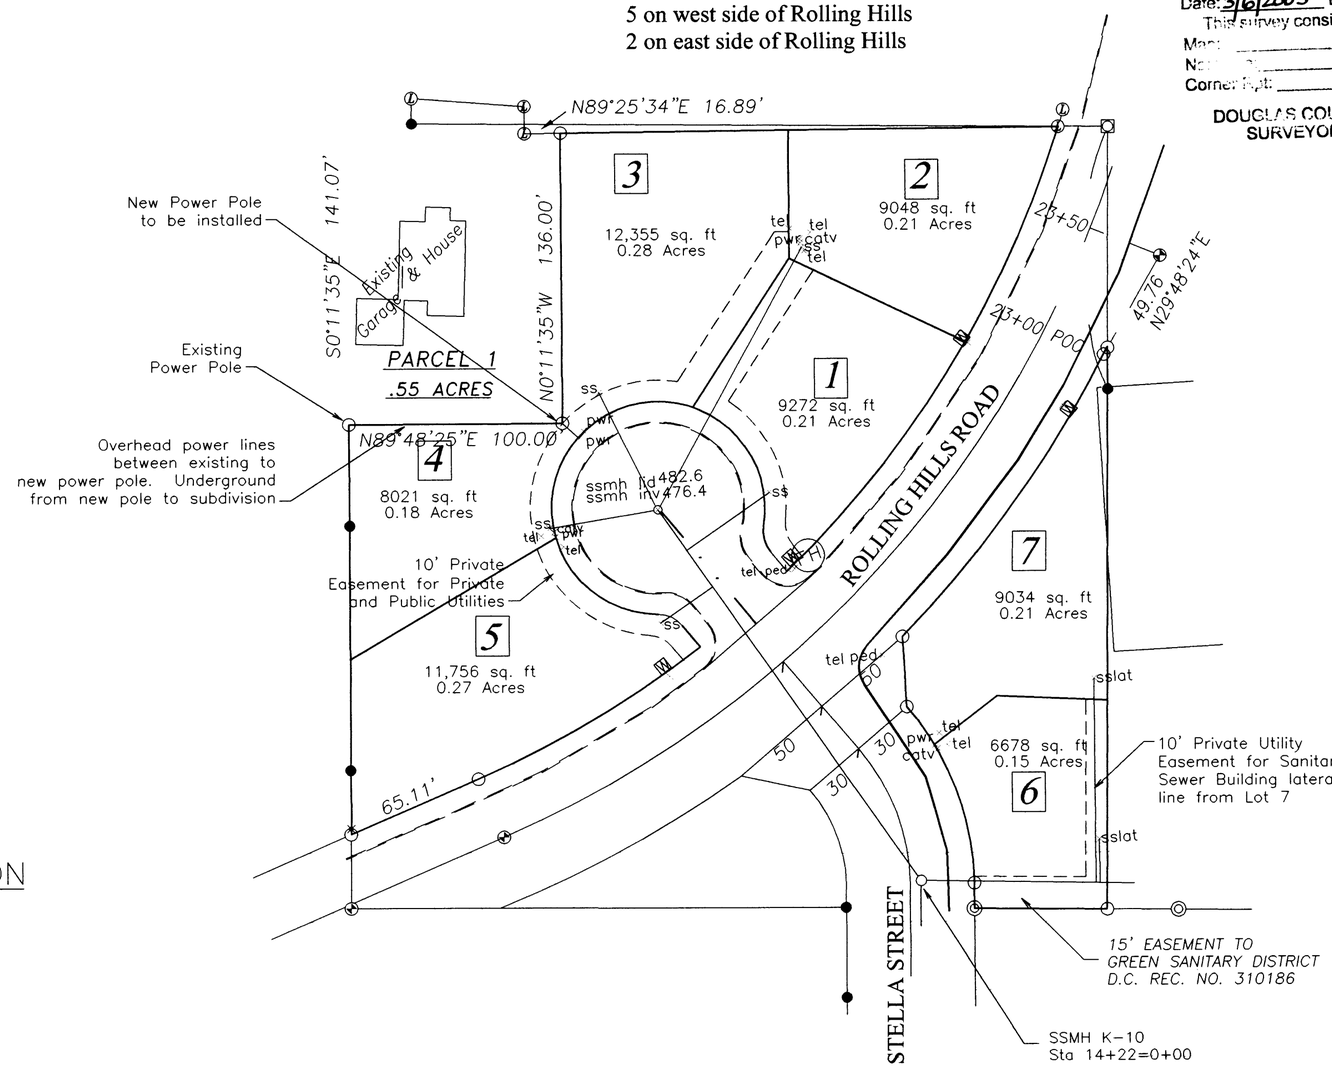

TYPICAL COMBINED TRENCH SECTION

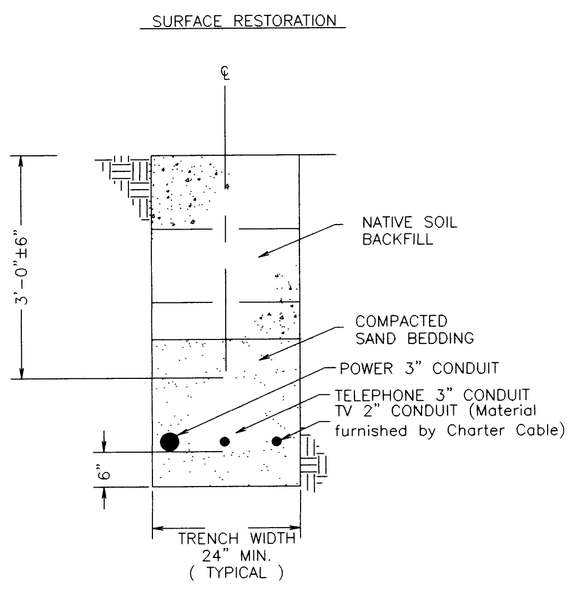

PLANS PREPARED BY
MAURICE E FARR
PROFESSIONAL ENGINEER
395 NE KIRBY AVENUE
ROSEBURG, OR 97470
Ph (541) 957 9442

REGISTERED PROFESSIONAL ENGINEER 5188 OREGON JULY 10, 1984 MAURICE E FARR
12-02
EXPIRES 12-31-03

STELLA COURT SUBDIVISION

TONY KUHN
579 FISHER ROAD
ROSEBURG, OREGON

UTILITIES
POWER, PHONE,
CATV, NATURAL GAS

SHEET
6 OF 6

R246AUTL

Co. Rd. #246A M.P 0.00 - 0.16