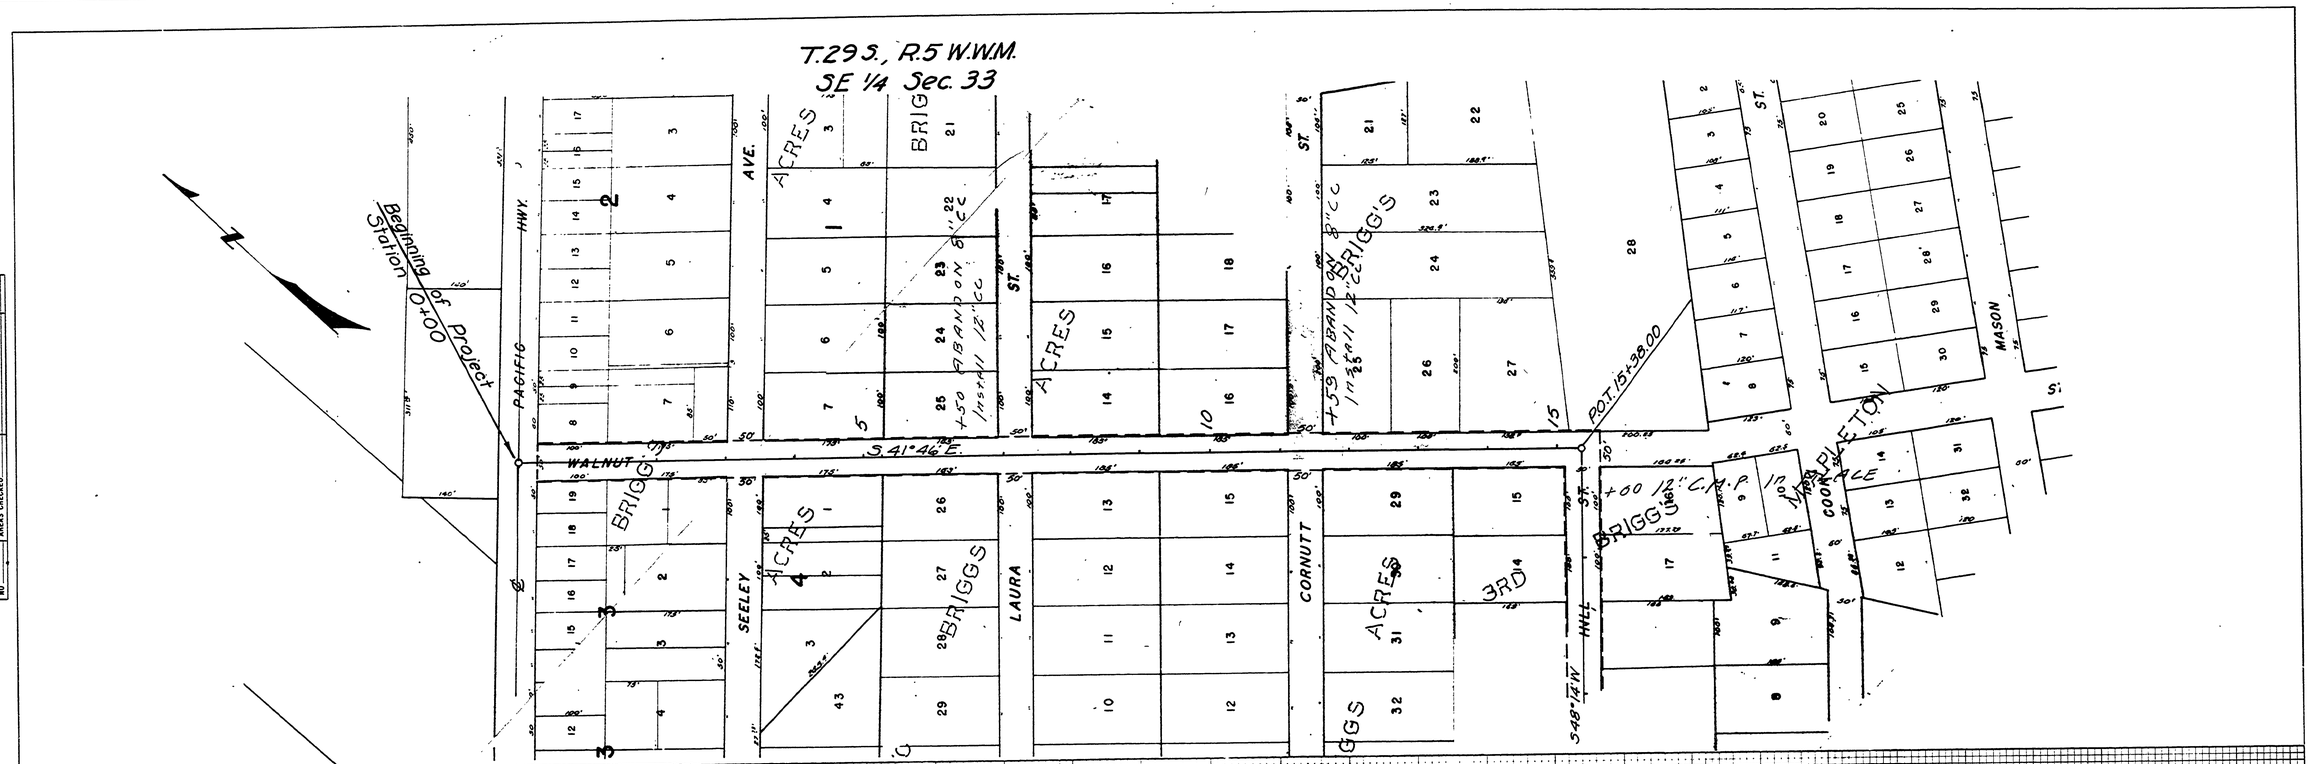

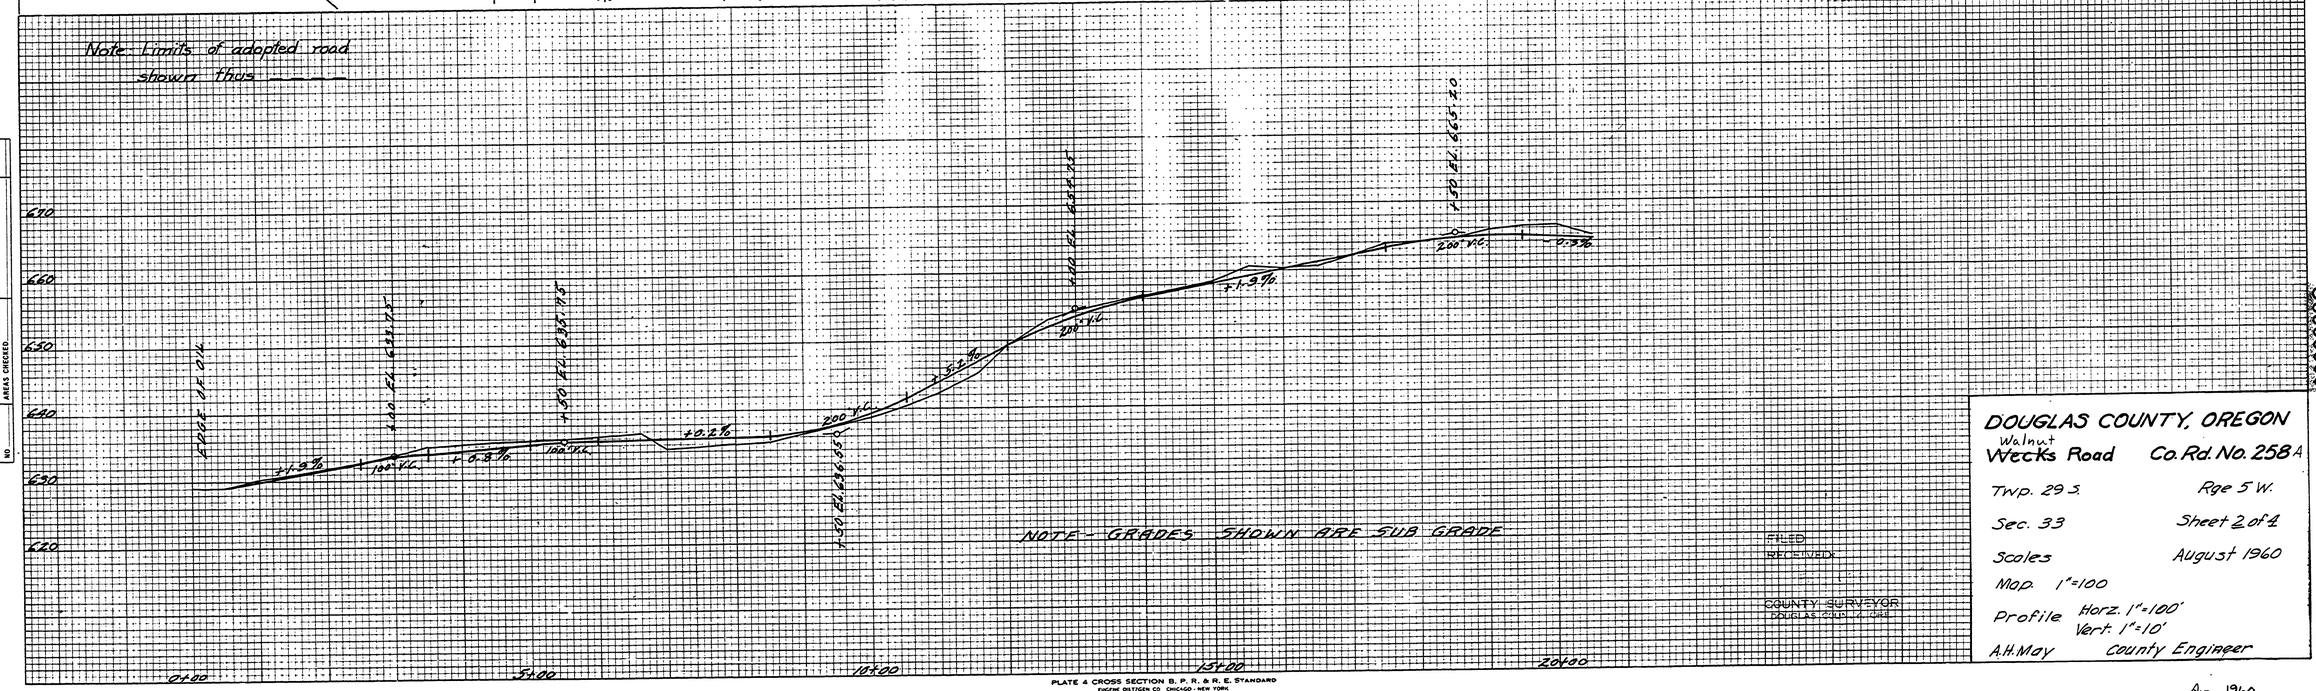

DOUGLAS COUNTY, OREGON

Walnut
Wecks Road — Co. Rd. No. 258 A

Twp. 29 S. — Rge 5 W.

Sec. 33 — Sheet 2 of 4

Scales — August 1960

Map 1"=100

Profile Horz. 1"=100'
Vert. 1"=10'

A.H. May — County Engineer

FILED
RECEIVED

COUNTY SURVEYOR
DOUGLAS COUNTY, OREGON

PLATE 4 CROSS SECTION B. P. R. & R. E. STANDARD
EUGENE DIETZGEN CO. CHICAGO - NEW YORK

FINAL SURVEY		BY	DATE
NOTE BOOK	SURVEYED		
	PLOTTED		
	TEMPLATE		
	AREAS		
NO.	AREAS CHECKED		

ORIGINAL SURVEY		BY	DATE
NOTE BOOK	SURVEYED		
	PLOTTED		
	TEMPLATE		
	AREAS		
NO.	AREAS CHECKED		

00000029C

M.P. 0.00- 0.29 / Co. Rd. # 258 A

Aug. 1960

sht. 2 of 4

20