

BEARING AREA OF THRUST BLOCKS (SQ. FT.)




FITTING SIZE	TEE-TEE PLUG OR GAP	90° BEAD PLUGGED CROSS		45° BEAD PLUGGED ON RUN		22 1/2° BEAD PLUGGED		11 1/4° BEAD PLUGGED	
		A ₁	A ₂	A ₁	A ₂	A ₁	A ₂	A ₁	A ₂
4	1-0	1-4	1-9	1-4	1-0	-	-	-	-
6	2-1	3-0	4-3	3-0	1-5	1-0	1-0	1-0	1-0
8	3-3	5-3	7-6	5-4	2-5	1-3	1-3	1-3	1-3

PLAN

DATE	BY
NO.	NO.
NO.	NO.
NO.	NO.

PROFILE

DATE	BY
NO.	NO.
NO.	NO.
NO.	NO.

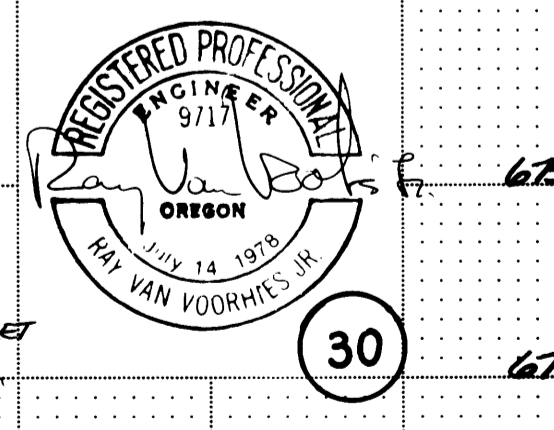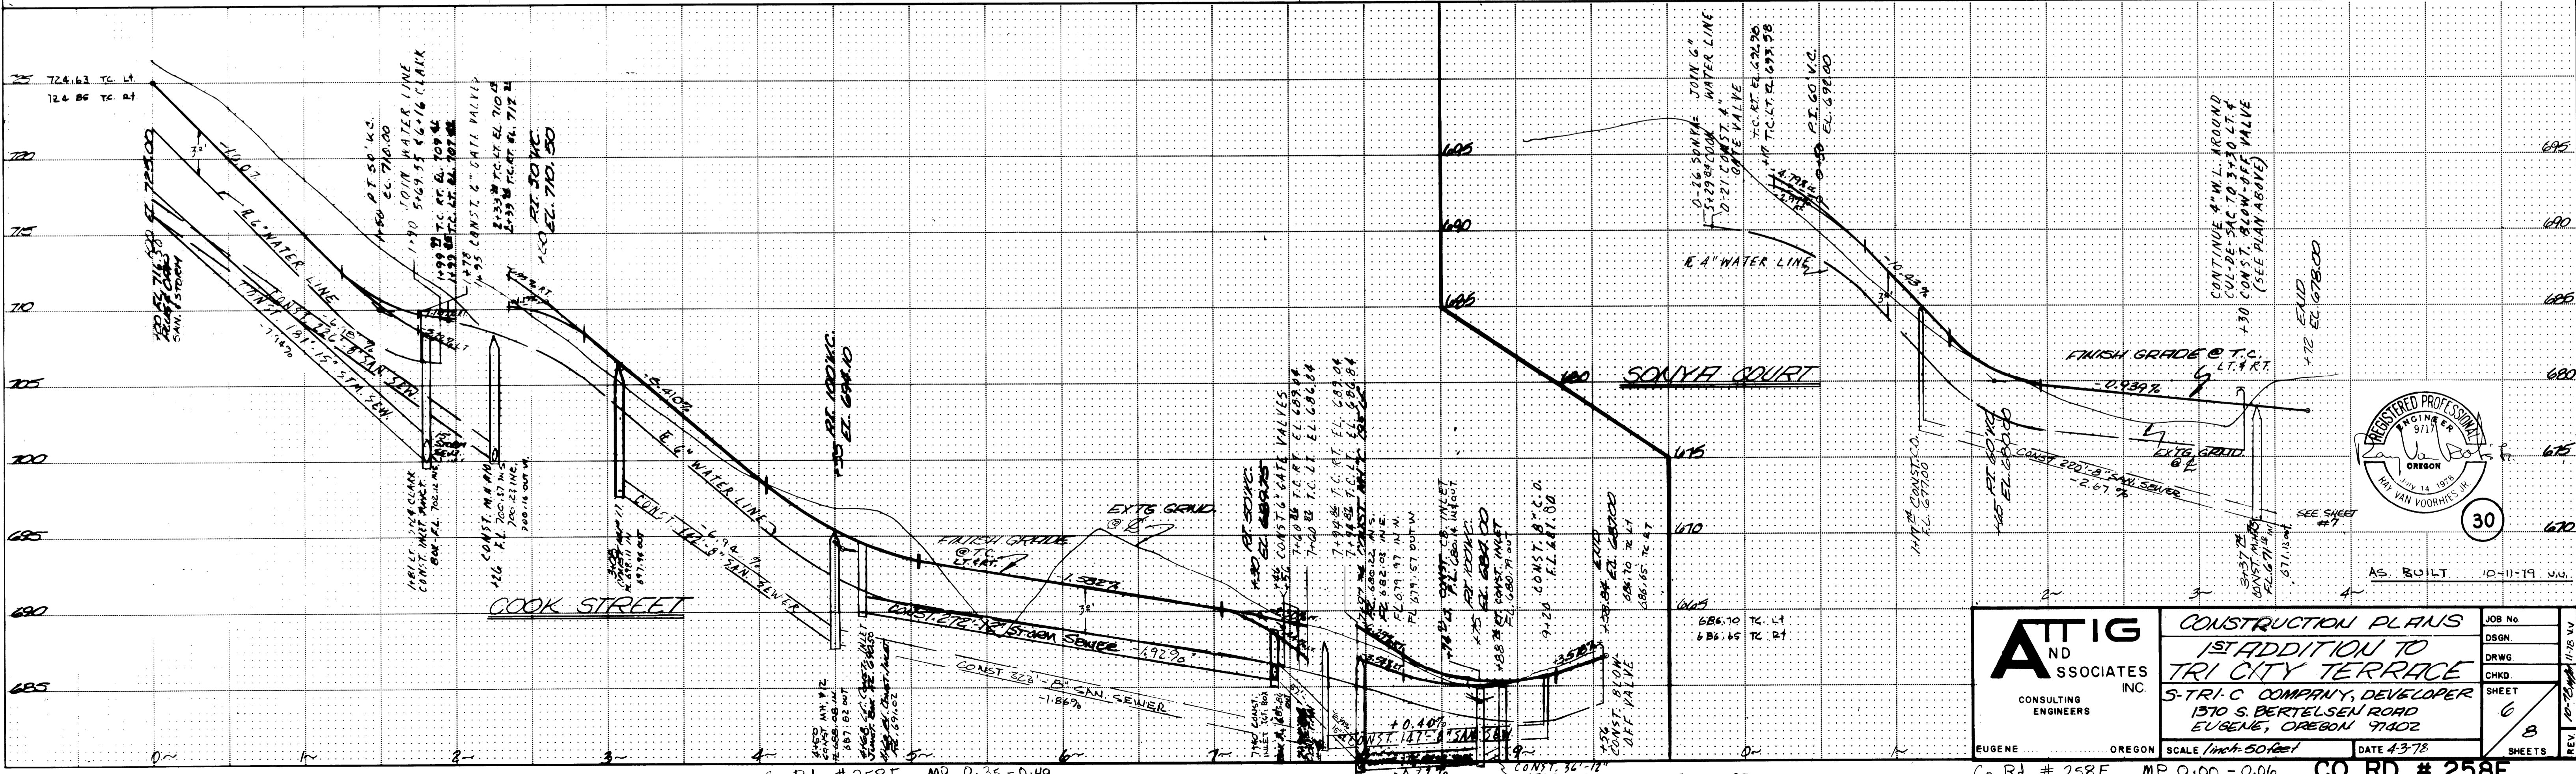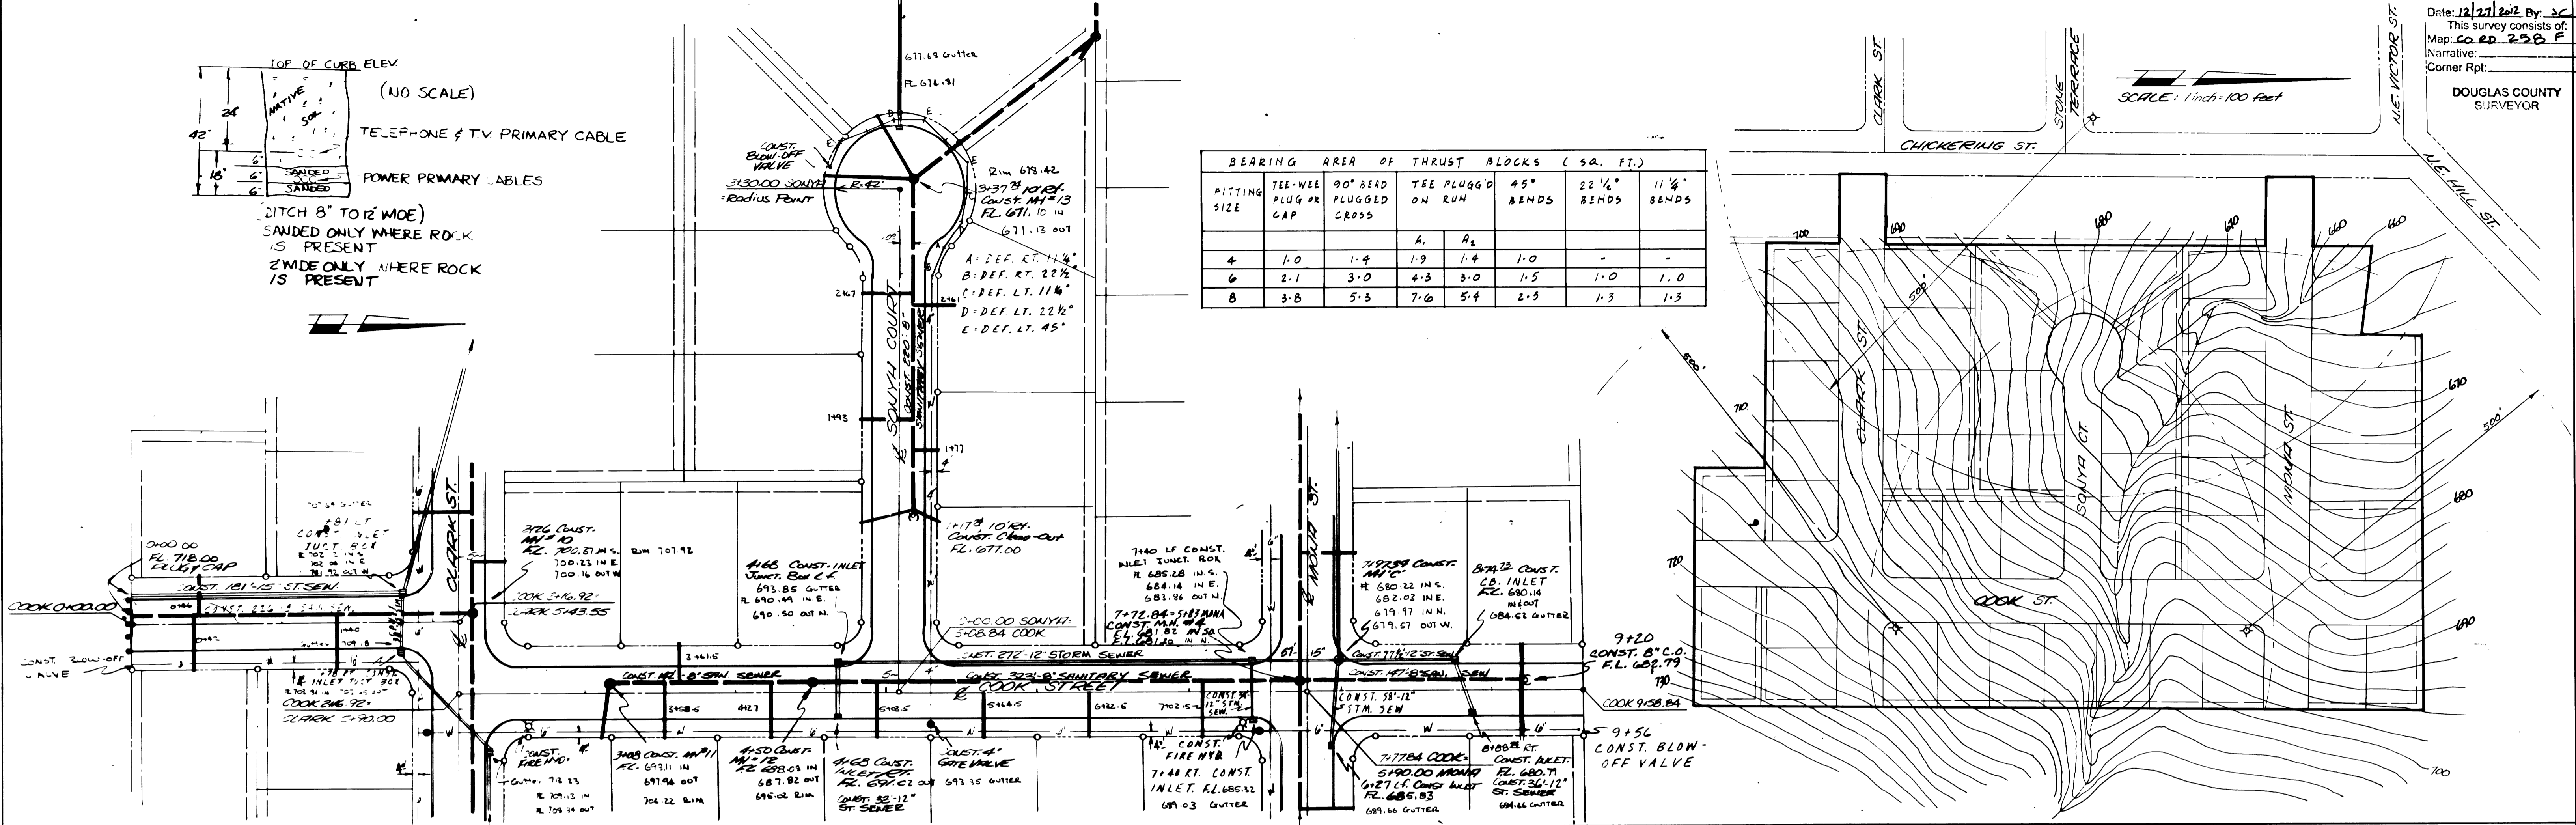

ATTIG AND ASSOCIATES INC.
 CONSULTING ENGINEERS
 EUGENE OREGON

CONSTRUCTION PLANS
 1ST ADDITION TO TRI CITY TERRACE
 S-TRI-C COMPANY, DEVELOPER
 1370 S. BERTELSEN ROAD
 EUGENE, OREGON 97402

Job No. _____
 DSGN. _____
 DRWG. _____
 CHKD. _____
 SHEET 6
 SHEETS 8

SCALE 1/4"=1'-0"
 DATE 4-3-78
 CO. RD. # 258F MP 0.00 - 0.06 CO. RD. # 258F

Co. Rd. # 258F MP 0.35 - 0.49

Sonya Ct

Co. Rd. # 258F MP 0.00 - 0.06

CO. RD. # 258F

00350049