FILED
Date: 12/27/2012 By: JC
This survey consists of:
Map: CO. RD 258 G
Narrative:
Corner Rpt:
DOUGLAS COUNTY SURVEYOR

NOTE: INSTALL WATER MAINS @ 4.5' FROM PROPERTY LINES, MIN. DEPTH IS 30". THRUST BLOCKS TO BE CONST. @ ALL ANGLE POINTS & JUNCTIONS OF WATER LINES.

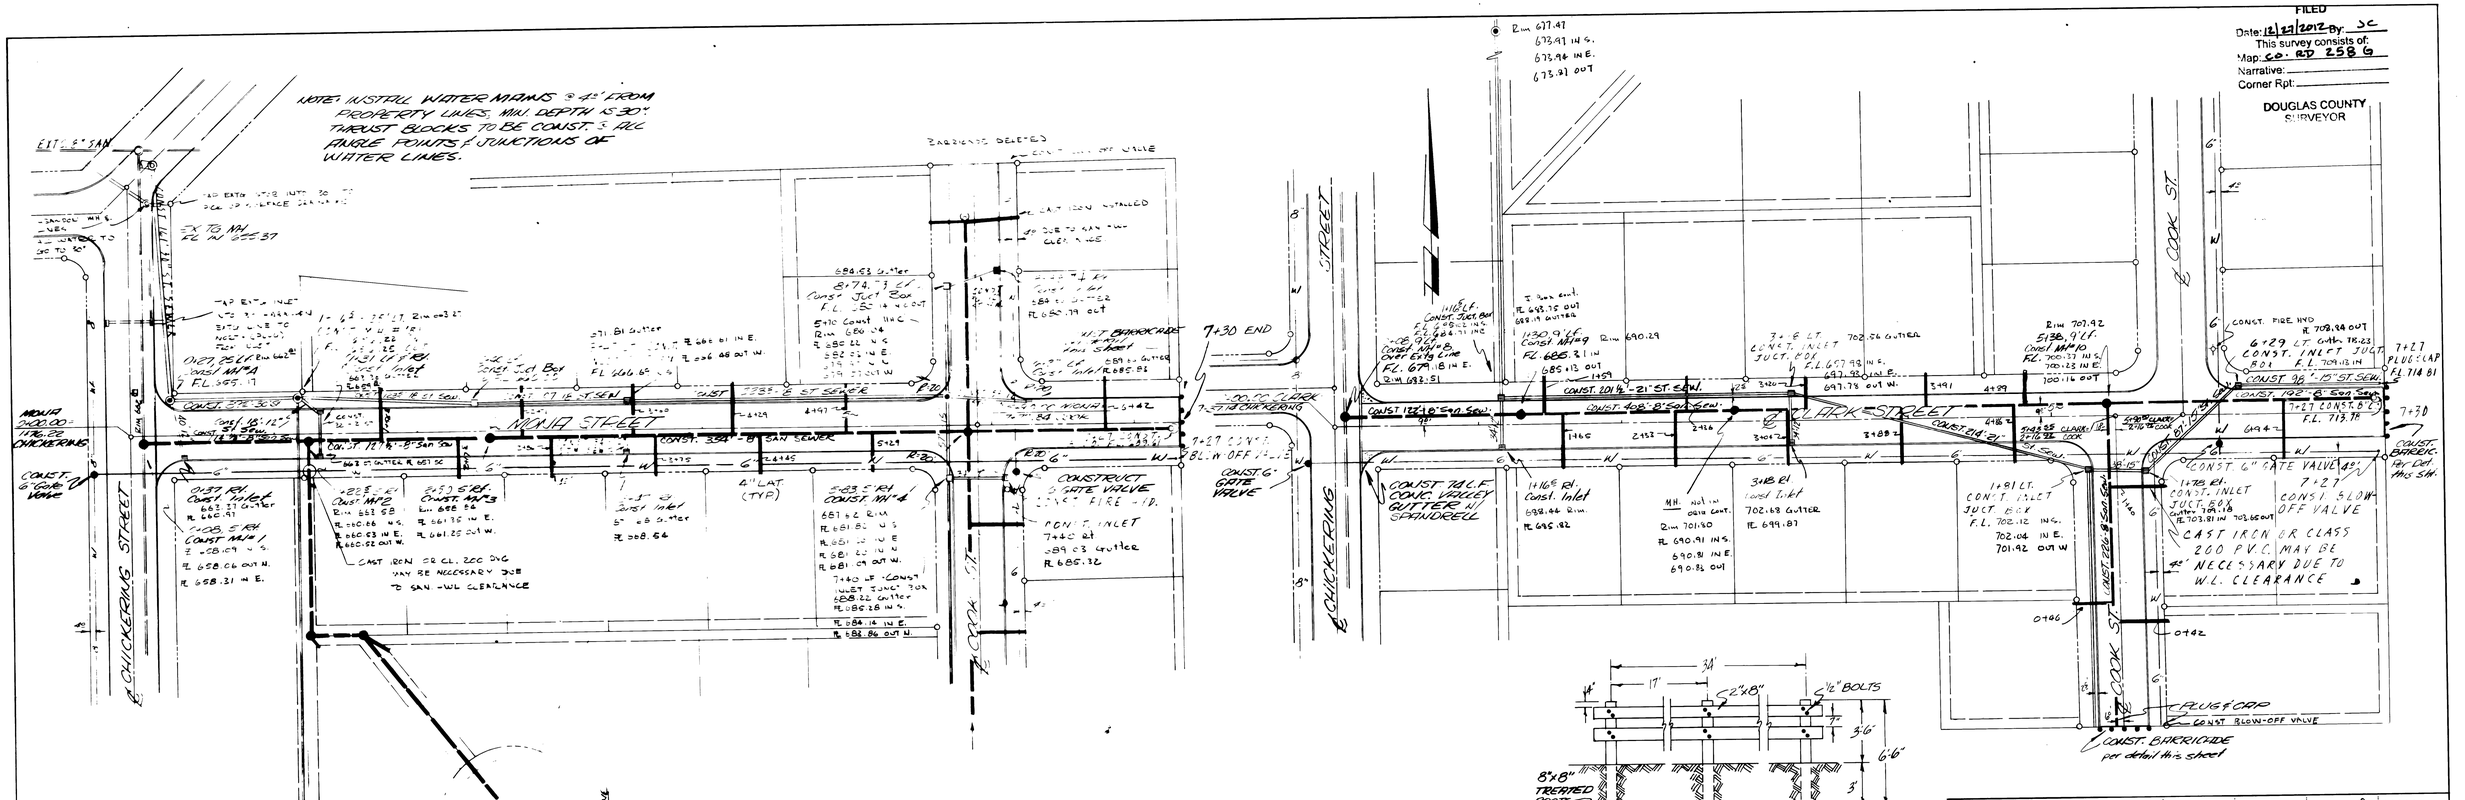

PROFILE	BY	DATE
SURVEYED		
PLOTTED		
DESIGN CHECKED		
R.W. NOTED		
STRUCTURE NOTE NO GW NO.		
NOTE BOOK		
NO.		

PLAN	BY	DATE
SURVEYED		
PLOTTED		
ALIGNMENT CHECKED		
ST. RW NOTED		
NOTE BOOK		
NO.		

ATTIG AND ASSOCIATES INC
CONSULTING ENGINEERS
EUGENE OREGON

CONSTRUCTION PLANS
1ST ADDITION TO TRI CITY TERRACE
S-TRI-C COMPANY, DEVELOPER
1370 S. BERTELSEN ROAD
EUGENE, OREGON 97402

SCALE 1" = 20' DATE 4-3-78

JOB No	
DSGN	
DRWG	
CHKD	
SHEET	5
SHEETS	5
REV.	

Co.Rd. # 258D MP 0.00 - 0.13
Clark ST
Co.Rd. # 258G MP 0.00 - 0.14
CO. RD. # 258G

R258DG00