
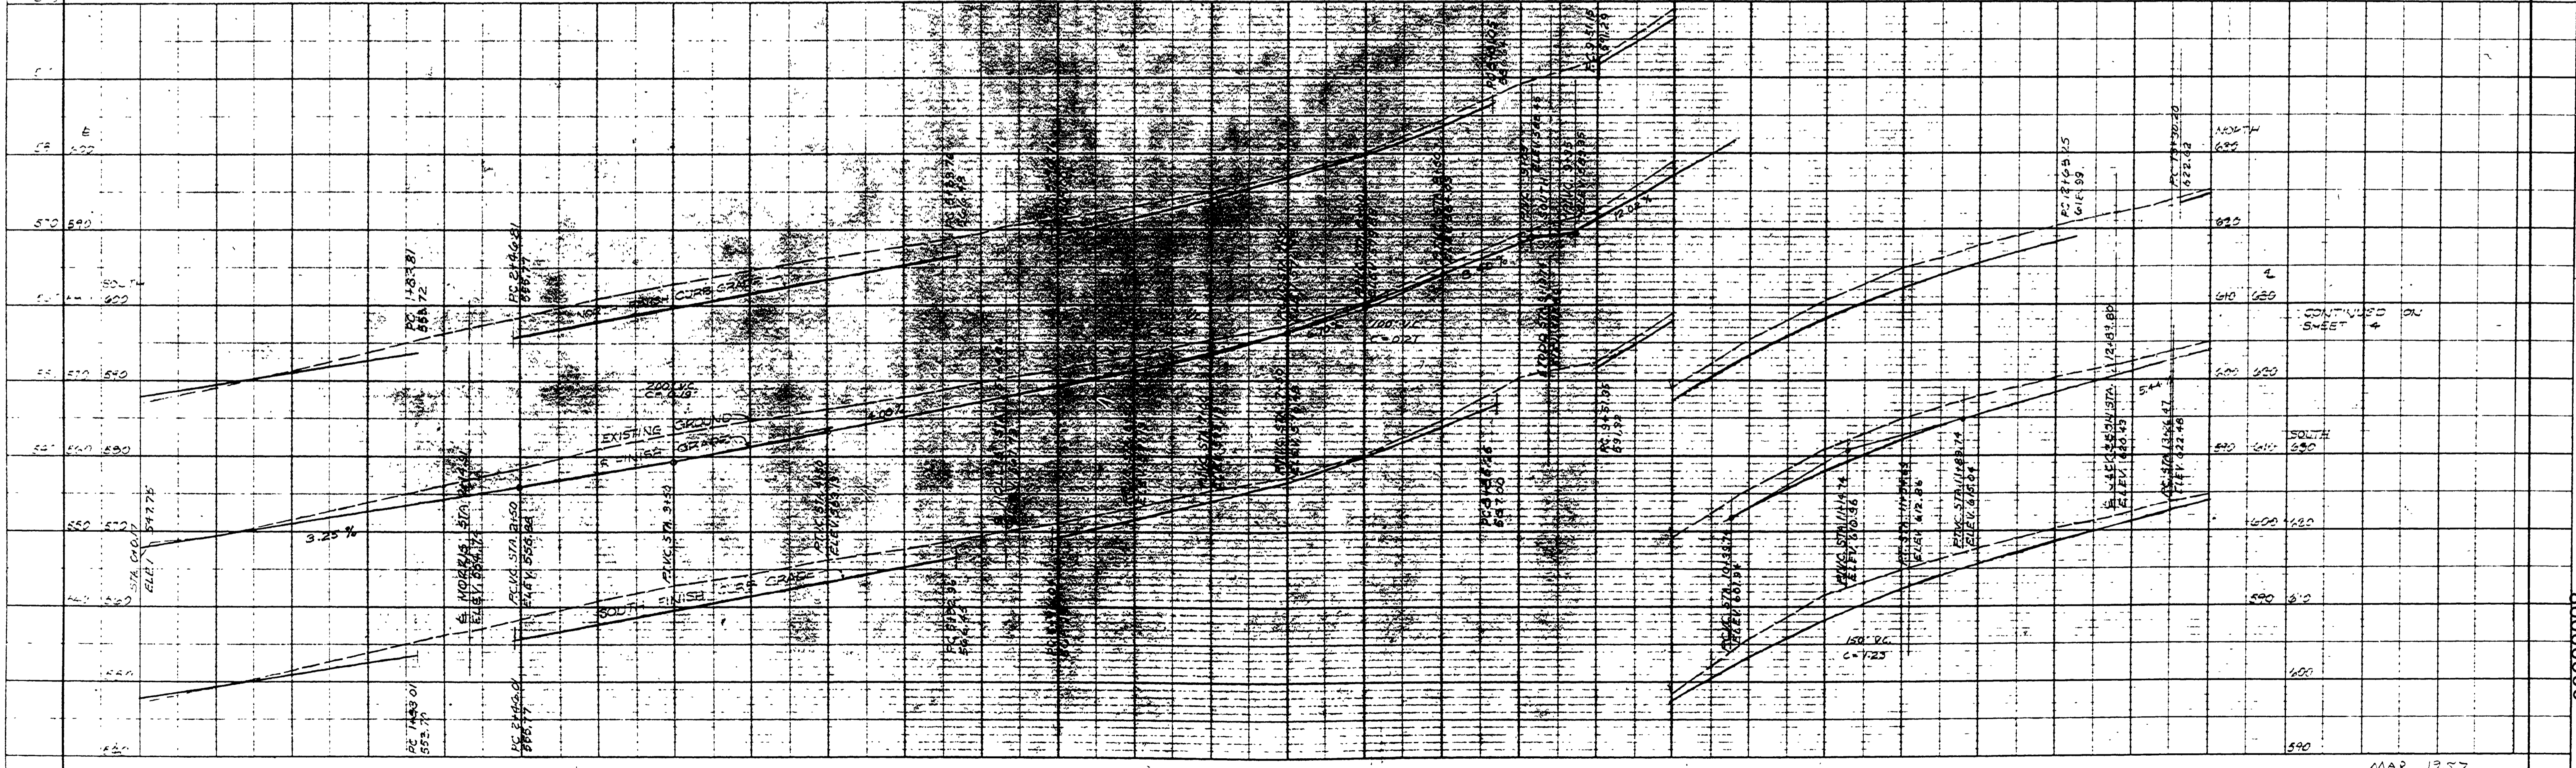


GENERAL SERVICES DIVISION
 FEDERAL HOUSING ADMINISTRATION
 CLOVERDALE ADDITION ROSEBURG, OREGON
 SCHEDULE 'P'
 BROOKLYN AVE.
 STA. 0+00 TO 12+50

SCALE: AS NOTED	DATE: MARCH 29, 1957	SHEET 3 OF 3
DR. DWG. DR. ALB	CORNELL, HOWLAND, HAYES & MERRYFIELD CORVALLIS, OREGON ENGINEERS	DWG. NO. C1371-3
1 2/2/60	TRC TRC GSW	
2 3/2/60		

FILED
 RECEIVED

CONT. COUNTY SURVEY
 SHEET 4 DOUGLAS COUNTY

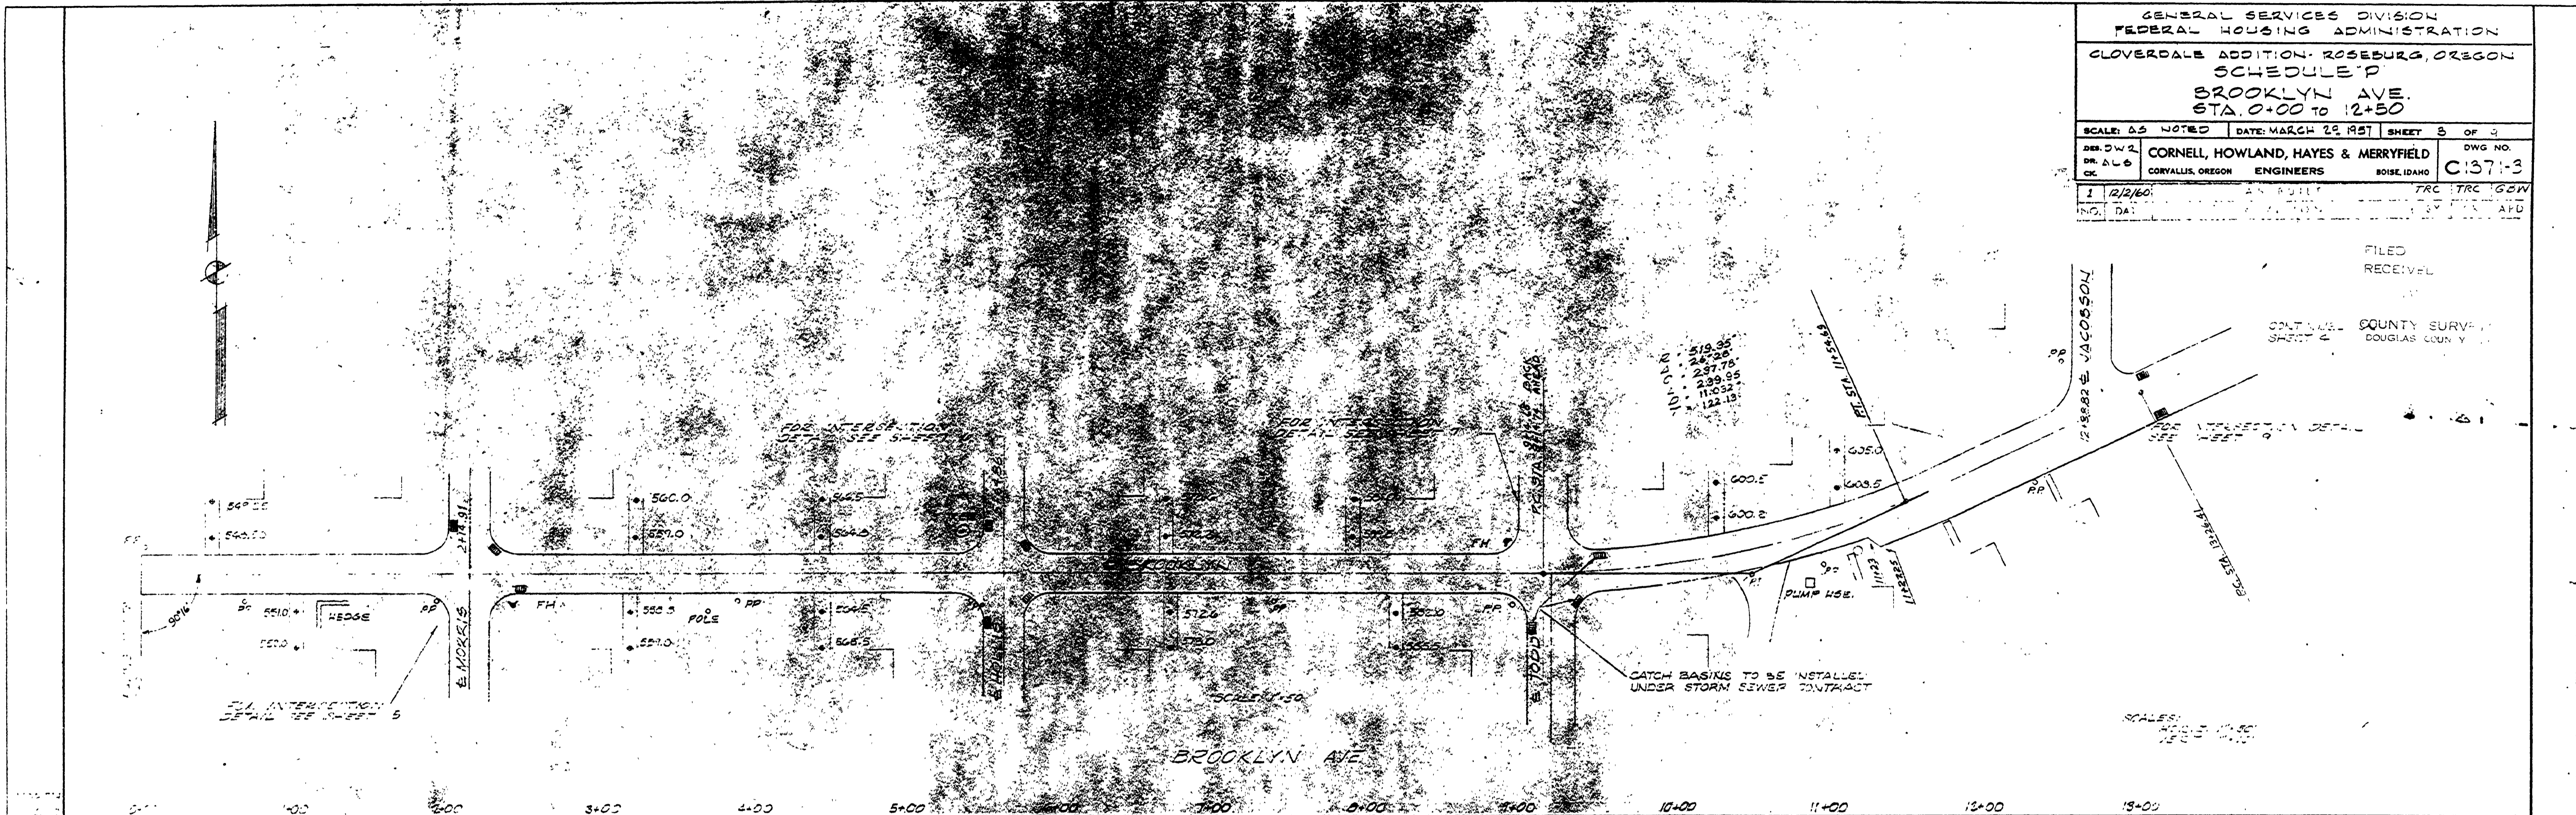

Rb No 262

ENGINEERS
 CORVALLIS, OREGON

M.P. 0.03 - 0.28

6 Rd = 262A Sheet 7 of 19

MAR 1957

00030028