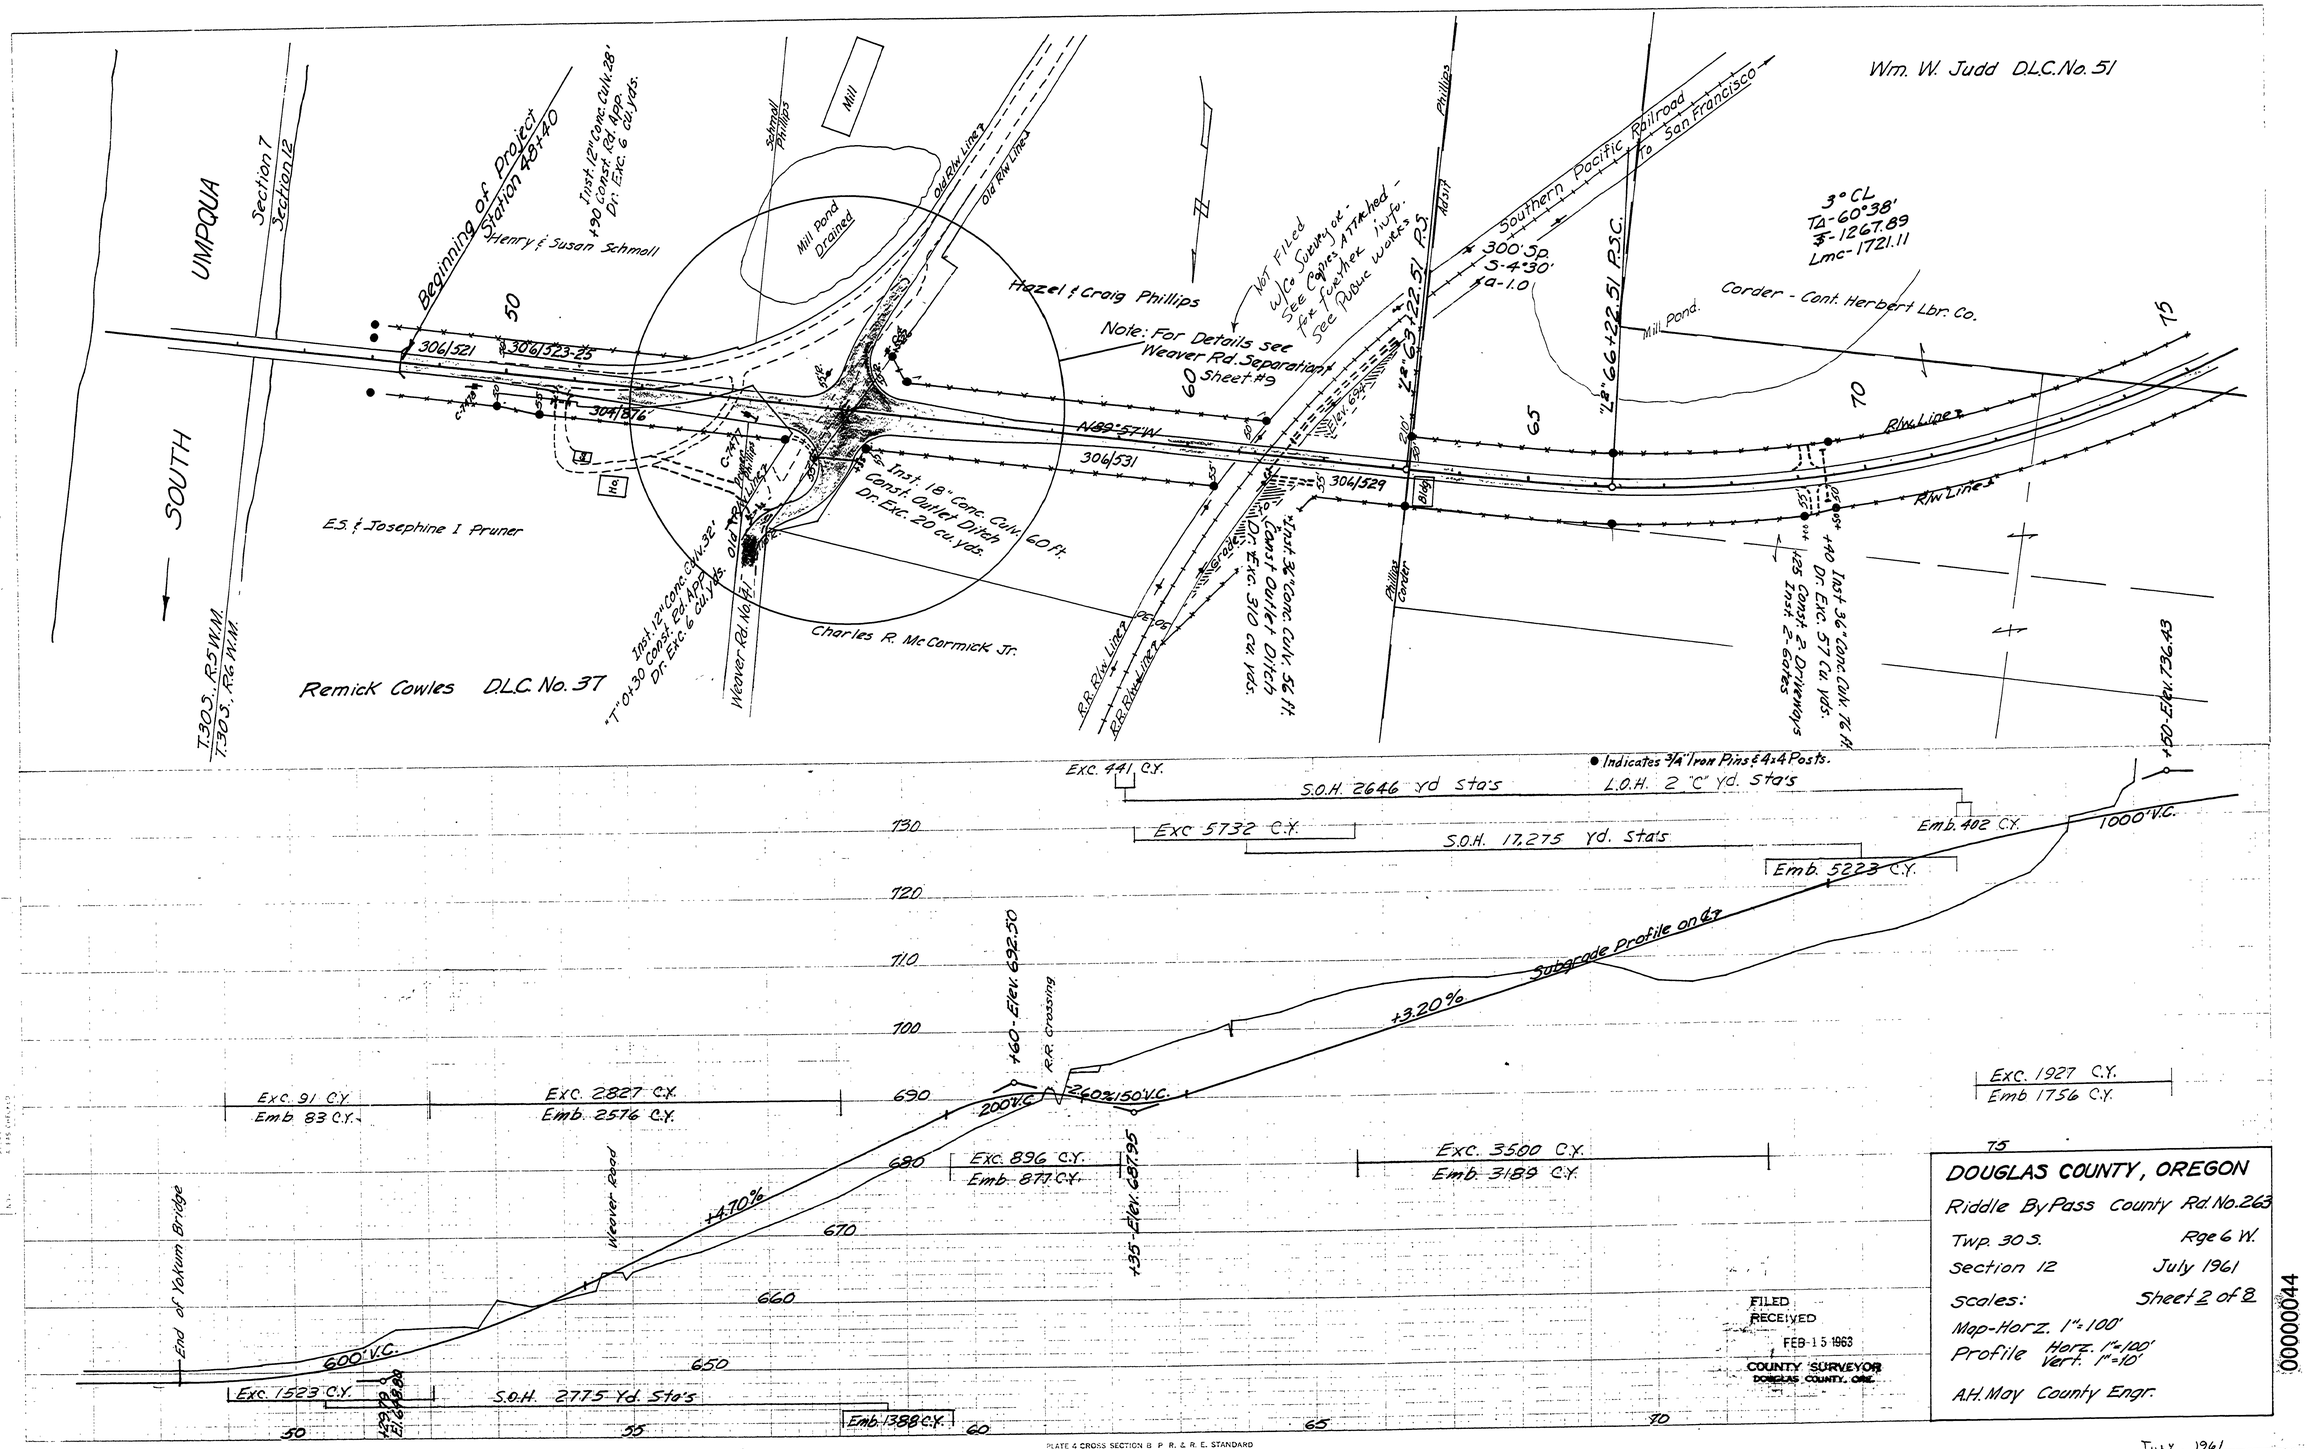
UMPQUA
Section 7
Section 12
SOUTH
T.30 S., R.5 W.M.
T.30 S., R.6 W.M.
Beginning of Project Station 48+40
+90 Const. Rd. App.
Dr. Exc. 6 cu. yds.
Henry & Susan Schmoll
50
306/521
306/523.25
304/876
Mill Pond Drained
Mill
School
Phillips
Old R/W Line
Hazel & Craig Phillips
Note: For Details see Weaver Rd. Separation Sheet #9
Not Filed w/Co. Survey - See Copies Attached - for further info. See Public Works
60
N89°57'W
306/531
306/529
Inst. 18" Conc. Culv.
Const. Outlet Ditch
Dr. Exc. 20 cu. yds.
60 ft.
E.S. & Josephine I. Pruner
Inst. 12" Conc. Culv. 32'
Const. Rd. App.
"T" 0+30
Dr. Exc. 6 cu. yds.
Charles R. McCormick Jr.
R.R. R/W Line
Inst. 36" Conc. Culv. 56 ft.
Const. Outlet Ditch
Dr. Exc. 310 cu. yds.
Phillips
Conder
Southern Pacific Railroad To San Francisco
300' Sp.
S-4°30'
a-1.0
"L8" 63+22.51 P.S.
"L8" 66+22.51 P.S.C.
Wm. W. Judd D.L.C. No. 51
3° CL
TA-60°38'
R-1267.89
Lmc-1721.11
Corder - Cont. Herbert Lbr. Co.
Mill Pond.
65
70
75
R/W Line
Inst. 36" Conc. Culv. 76 ft.
Dr. Exc. 57 cu. yds.
Inst. 2 Const. 2 Driveways
Remick Cowles D.L.C. No. 37
+50 - Elev. 736.43
Exc. 441 C.Y.
S.O.H. 2646 Yd Sta's
L.O.H. 2 "C" Yd. Sta's
● Indicates 3/4" Iron Pins & 4x4 Posts.
Exc. 5732 C.Y.
S.O.H. 17,275 Yd. Sta's
Emb. 402 C.Y.
Emb. 5223 C.Y.
1000' V.C.
Subgrade Profile on ℄
+3.20%
+60 - Elev. 692.50
R.R. Crossing
Exc. 91 C.Y.
Emb 83 C.Y.
Exc. 2827 C.Y.
Emb. 2576 C.Y.
200' V.C.
Exc. 896 C.Y.
Emb. 877 C.Y.
+35 - Elev. 687.95
Exc. 3500 C.Y.
Emb. 3189 C.Y.
Exc. 1927 C.Y.
Emb 1756 C.Y.
Weaver Road
+4.70%
End of Yakum Bridge
600' V.C.
Exc. 1523 C.Y.
S.O.H. 2775 Yd. Sta's
Emb. 1388 C.Y.
730
720
710
700
690
680
670
660
650
50
55
60
65
70
75
DOUGLAS COUNTY, OREGON
Riddle By Pass County Rd. No. 263
Twp. 30 S.
Rge 6 W.
Section 12
July 1961
Scales:
Sheet 2 of 8
Map-Horz. 1" = 100'
Profile Horz. 1" = 100' Vert. 1" = 10'
A.H. May County Engr.
FILED
RECEIVED
FEB 15 1963
COUNTY SURVEYOR
DOUGLAS COUNTY, ORE.
PLATE 4 CROSS SECTION B. P. R. & R. E. STANDARD
LUDENS GUTTMAN CO., CHICAGO - NEW YORK
M.P. 0.00 - 0.44
Co. Rd. #263
July, 1961
sht. 2 of 8
22
00000044