SEC.10 T28S R6W W.M.

FILED
RECEIVED
JUL 13 1971
COUNTY SURVEYOR
DOUGLAS COUNTY, ORE.

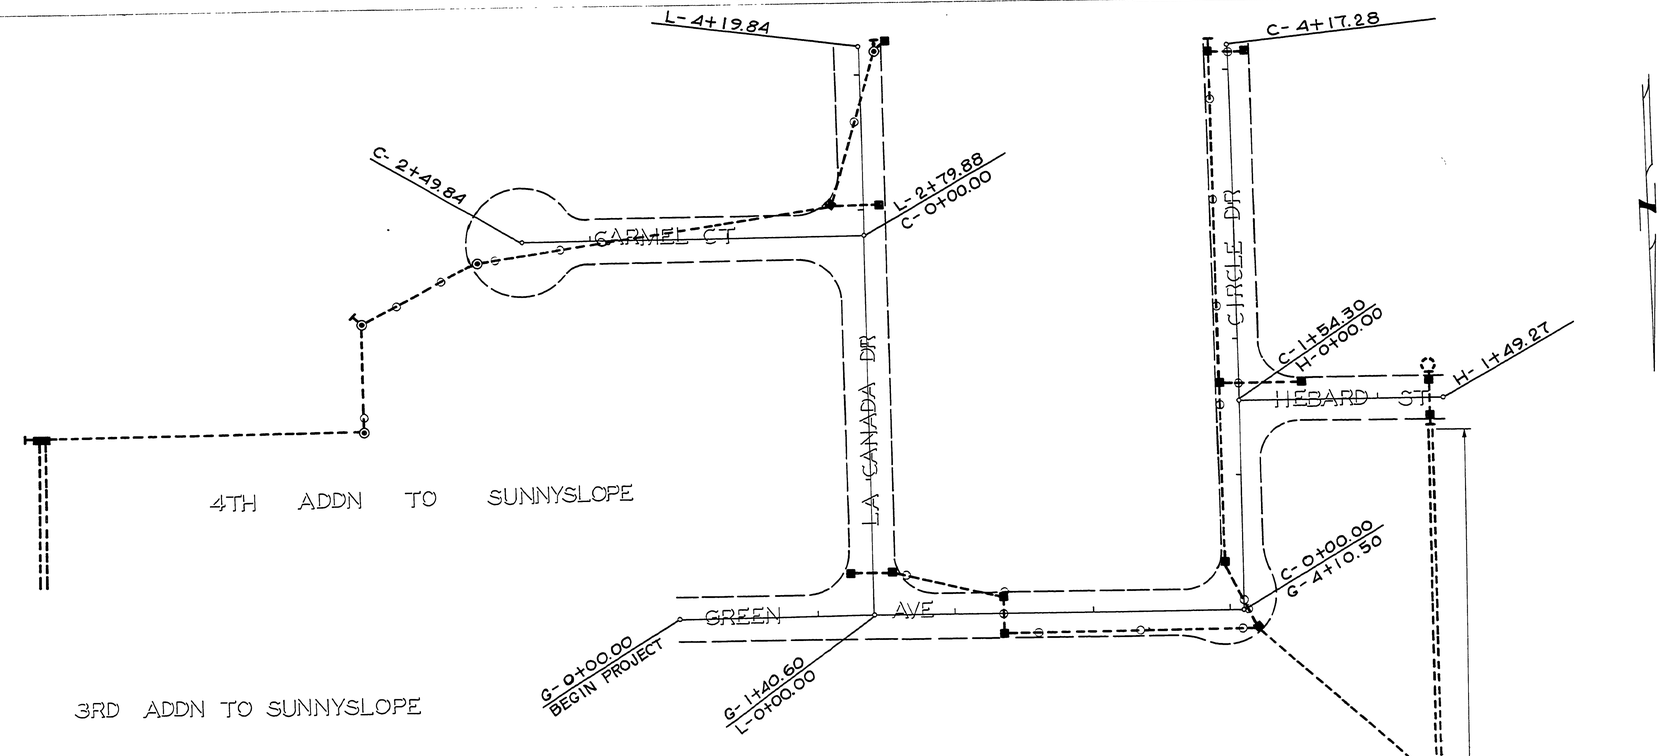

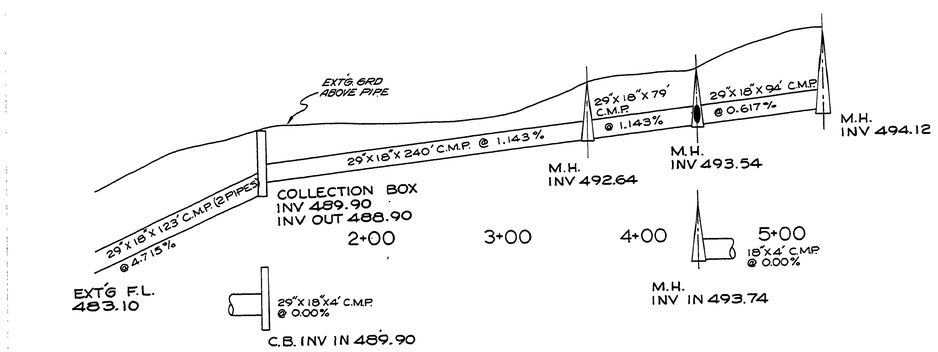

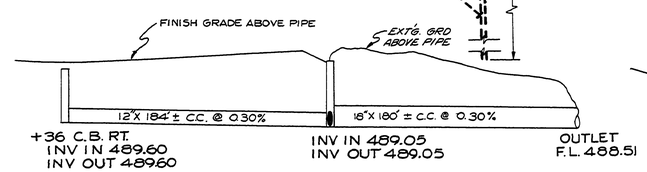

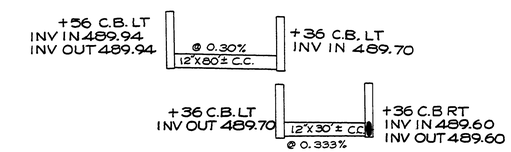

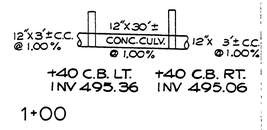

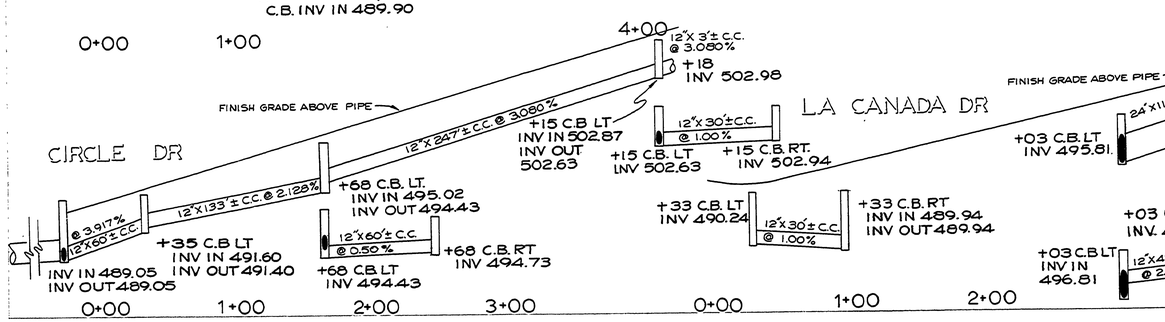

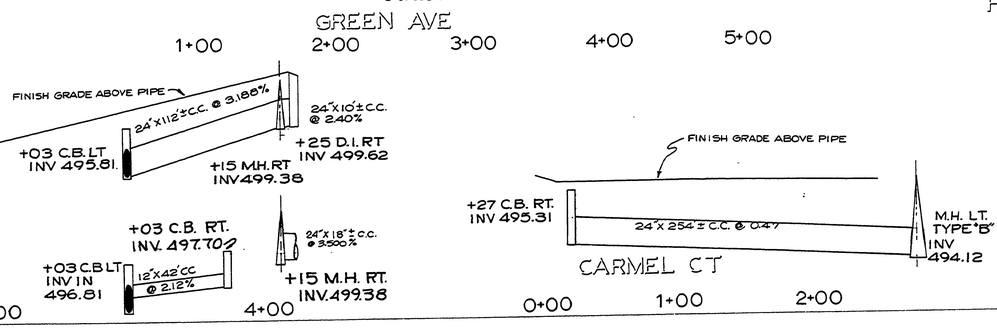

NOT REVISED
AS CONSTRUCTED

DOUGLAS COUNTY ROAD DEPT.
SUNNYSLOPE ST'S RD.# 278
MAY 1971 SHT. 2
GEORGE E. GRUBB COUNTY ENG.

00270035

MAY, 1971

M.P. 0.27-0.34 C.Rd.#278 sht. 2 (64)