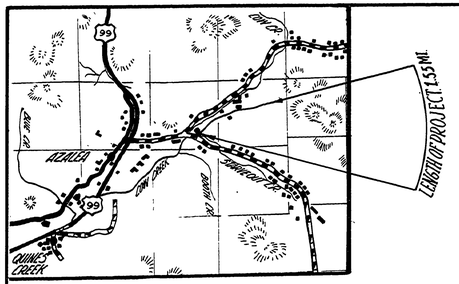

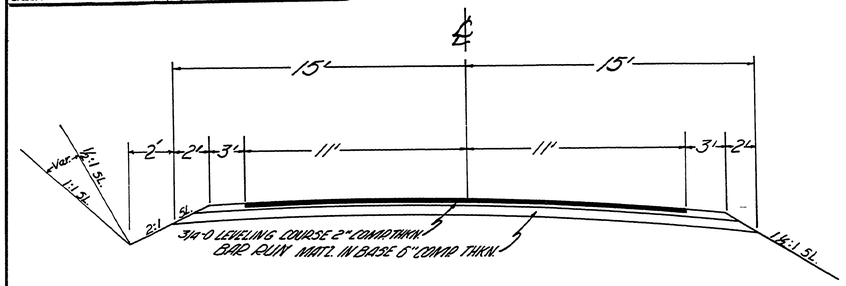

DOUGLAS COUNTY OREGON
AS CONSTRUCTED
YEUST ROAD NO. 287

APPROVED BY DOUGLAS COUNTY BOARD OF COMMISSIONERS THIS 6th DAY February 1967

Stanford Buell
COMMISSIONER

Ralph Sandstede
COMMISSIONER

Ray E. Doane
COMMISSIONER

Henry E. Scott
COUNTY ENGINEER

Date Feb. 8, 1967

REGISTERED PROFESSIONAL ENGINEER 4250 OREGON MAY 21, 1966 GEORGE E. CRUED

FILED
RECEIVED
MAR 27 1967
COUNTY SURVEYOR
DOUGLAS COUNTY, ORE.

0000014C

FINAL SURVEY		BY	DATE
NOTE BOOK	SURVEYED		
	PLOTTED		
	TEMPLATE		
	AREAS		
NO.	AREAS CHECKED		

ORIGINAL SURVEY		BY	DATE
NOTE BOOK	SURVEYED		
	PLOTTED		
	TEMPLATE		
	AREAS		
NO.	AREAS CHECKED		

Co. Rd. #287 1965 sht. 1 of 5 (13)