FILED
Date: 3/9/2006 By: JP
This survey consists of:
Map:
Narrative:
Corner Rpt:
DOUGLAS COUNTY SURVEYOR

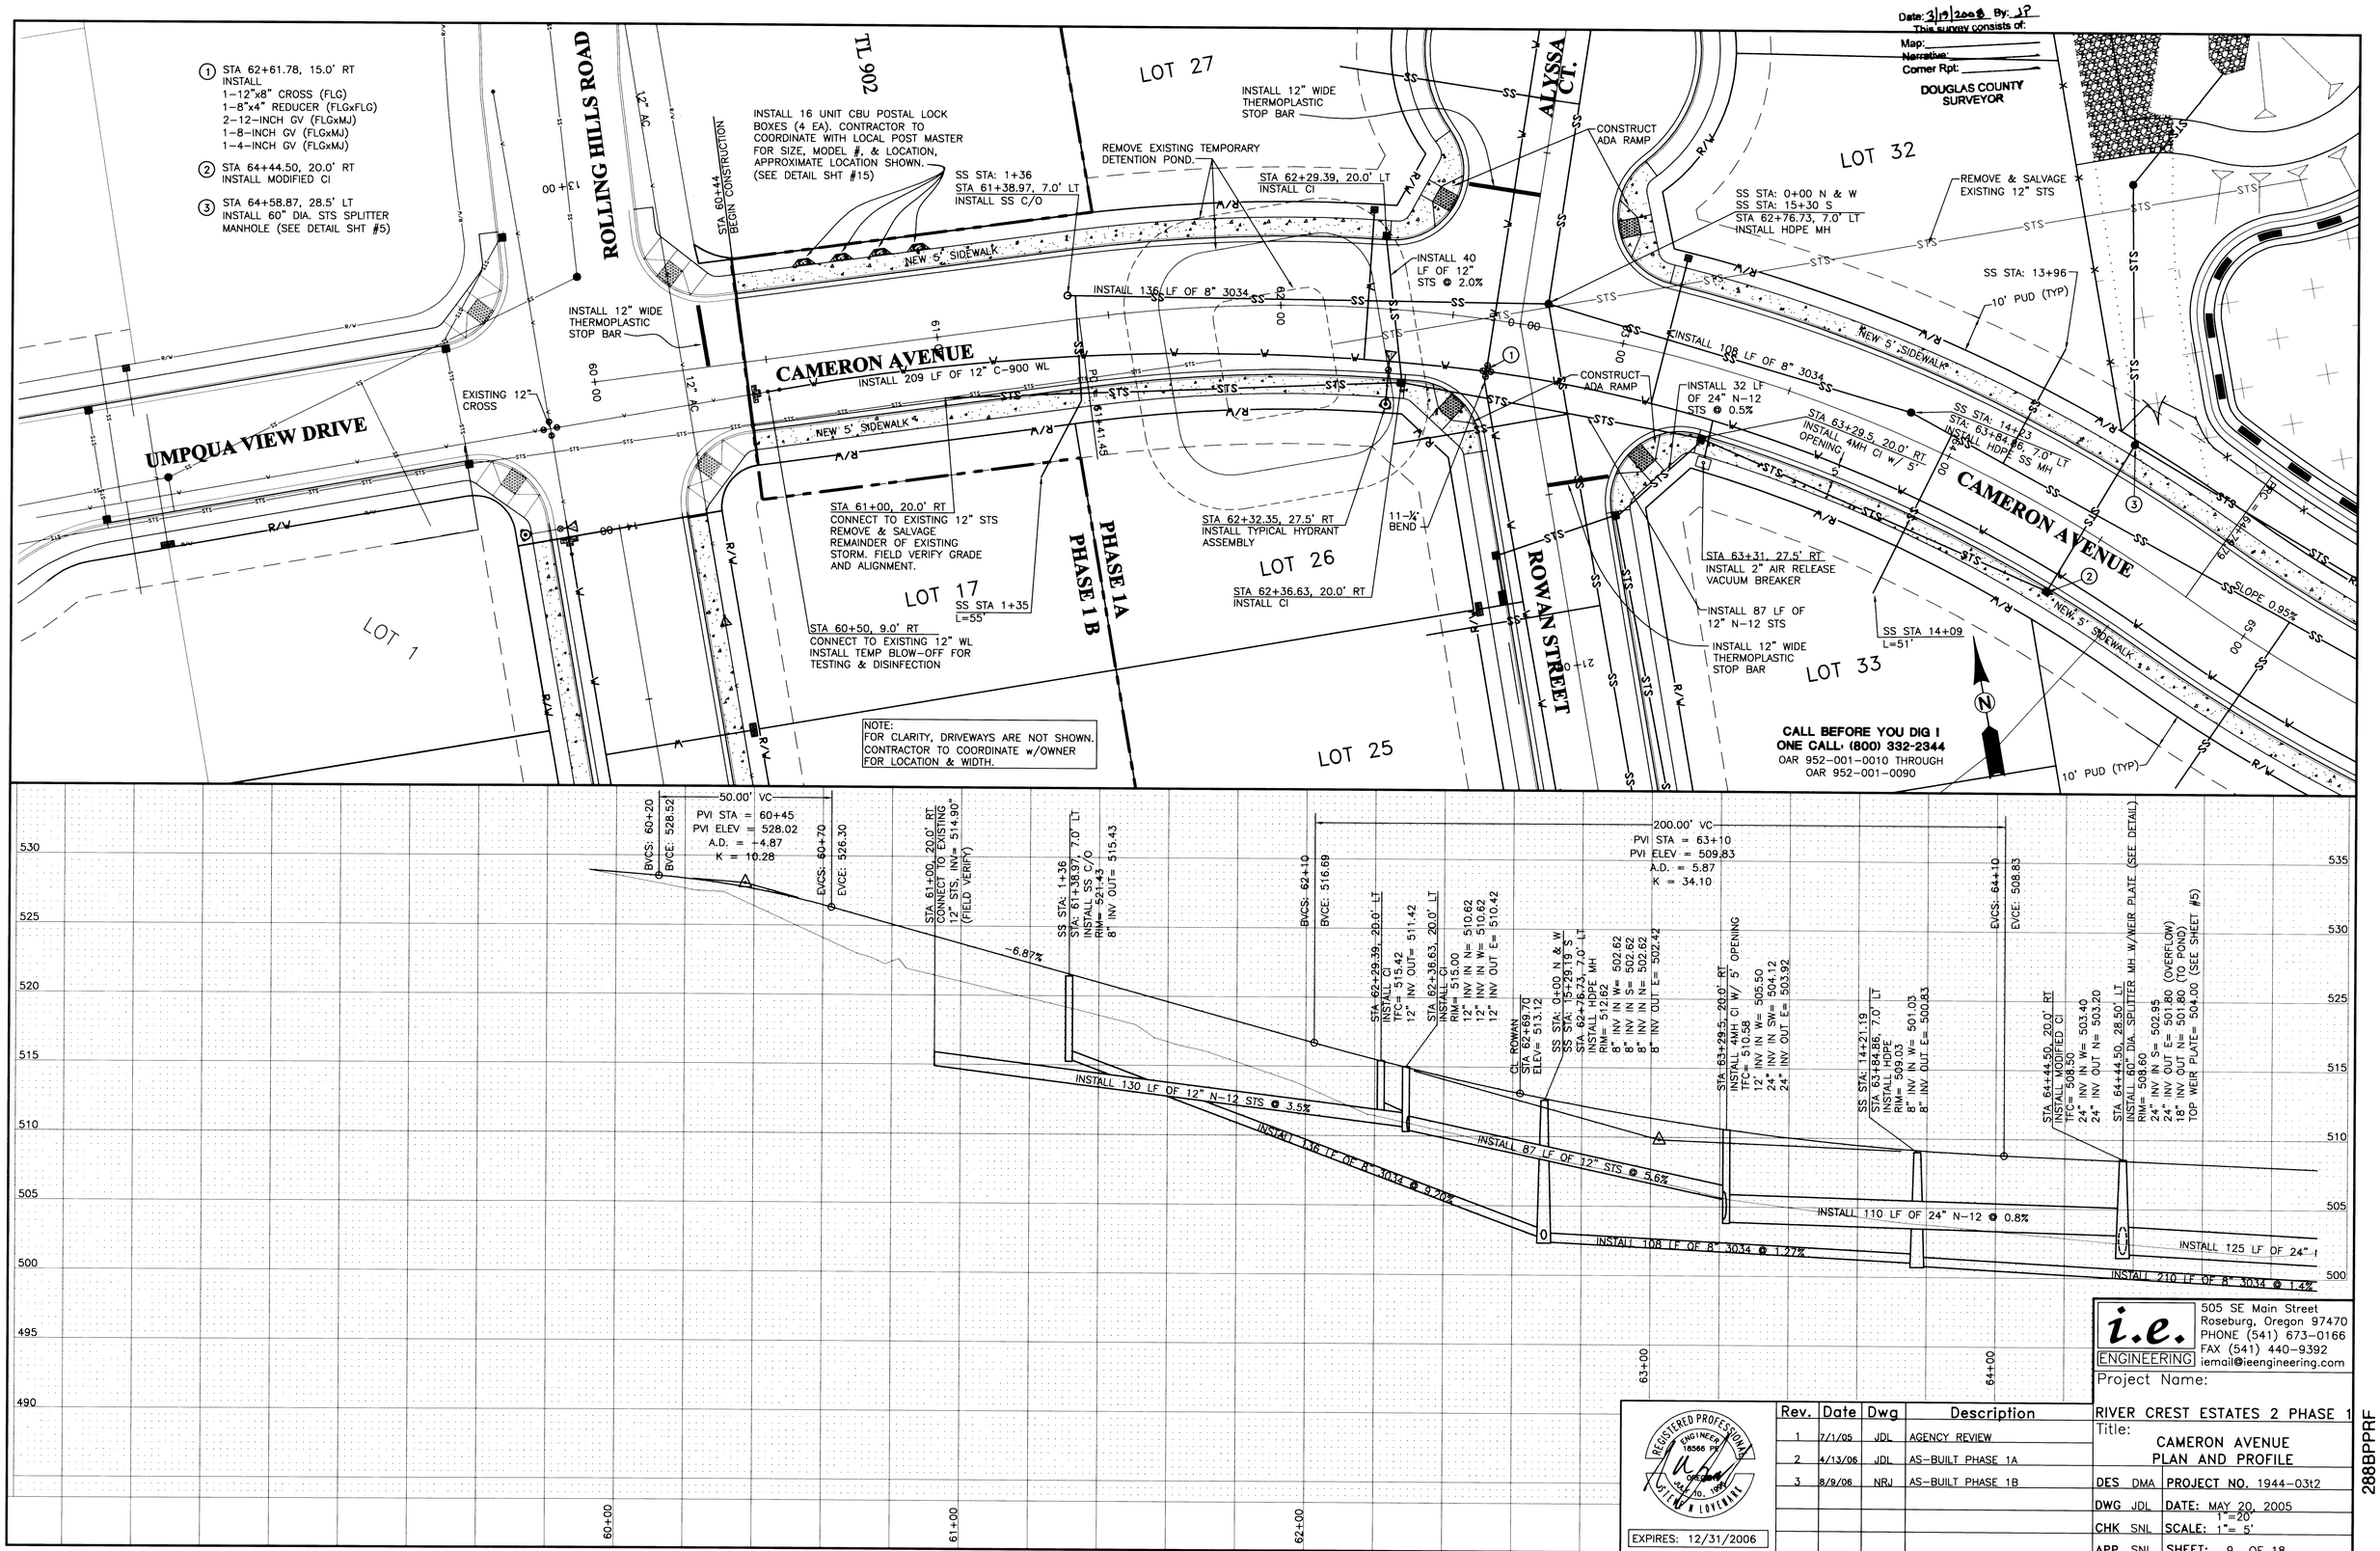

i.e. ENGINEERING
505 SE Main Street
Roseburg, Oregon 97470
PHONE (541) 673-0166
FAX (541) 440-9392
iemail@ieengineering.com

REGISTERED PROFESSIONAL ENGINEER 18566 PE
OREGON JULY 10, 1986
STEVEN N. LOVEMARK
EXPIRES: 12/31/2006

Rev.	Date	Dwg	Description
1	7/1/05	JDL	AGENCY REVIEW
2	4/13/06	JDL	AS-BUILT PHASE 1A
3	8/9/06	NRJ	AS-BUILT PHASE 1B

Project Name:
RIVER CREST ESTATES 2 PHASE 1
Title:
CAMERON AVENUE
PLAN AND PROFILE

DES	DMA	PROJECT NO.	1944-03t2
DWG	JDL	DATE:	MAY 20, 2005
CHK	SNL	SCALE:	1"=20' 1"= 5'
APP	SNL	SHEET:	9 OF 18

DO NOT DUPLICATE

288BPPRF

Co. Rd. #288B

MP 0.00 - 0.10

CO. RD. 288B PLAN & PROFILE