SCHMOLL PLAT "K"

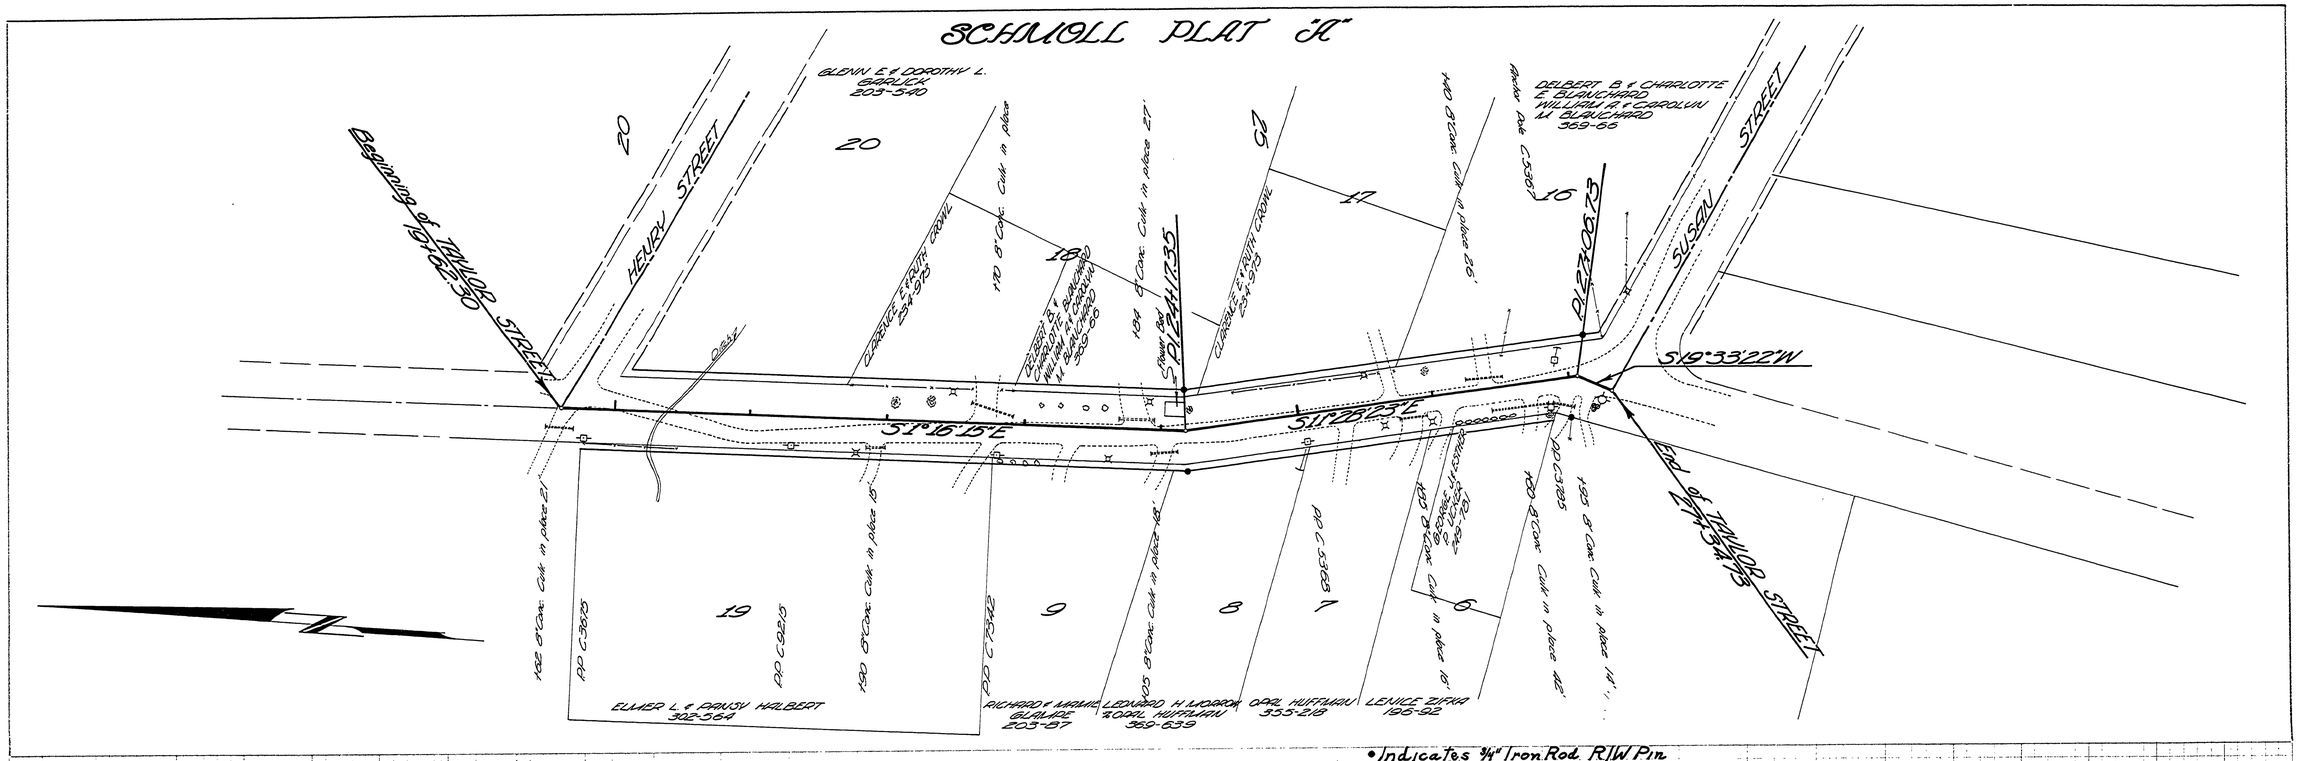

• Indicates 3/4" Iron Rod R/W Pin

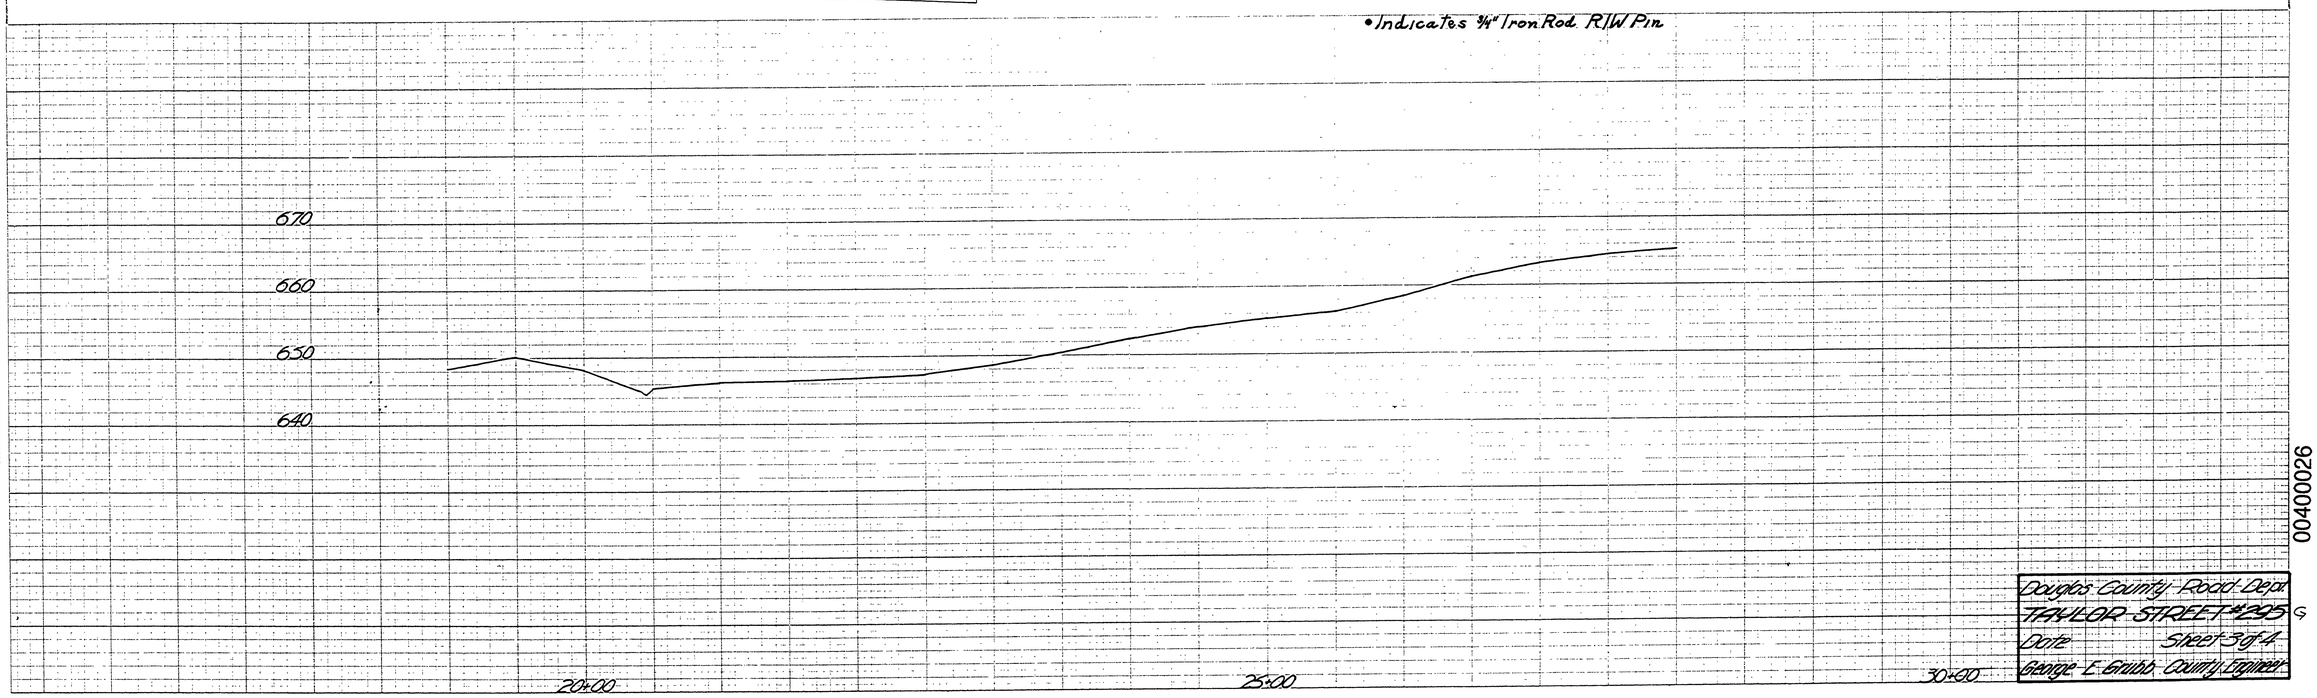

FINAL SURVEY	SURVEYED: PLOTTED: TEMPLATE: AREAS: AREAS CHECKED:
NOTE BOOK	
NO.	
DATE	BY

ORIGINAL SURVEY	SURVEYED: PLOTTED: TEMPLATE: AREAS: AREAS CHECKED:
NOTE BOOK	
NO.	
DATE	BY

Douglas County Road Dept.
TAYLOR STREET #295 G
Date: Sheet 3 of 4
George E. Gribb, County Engineer

00400026

M.P. 0.40 - 0.26 C.Rd. #295 G Sht. 3 of 4 no date (32)