SEC. 12 T27S R6W W.M.

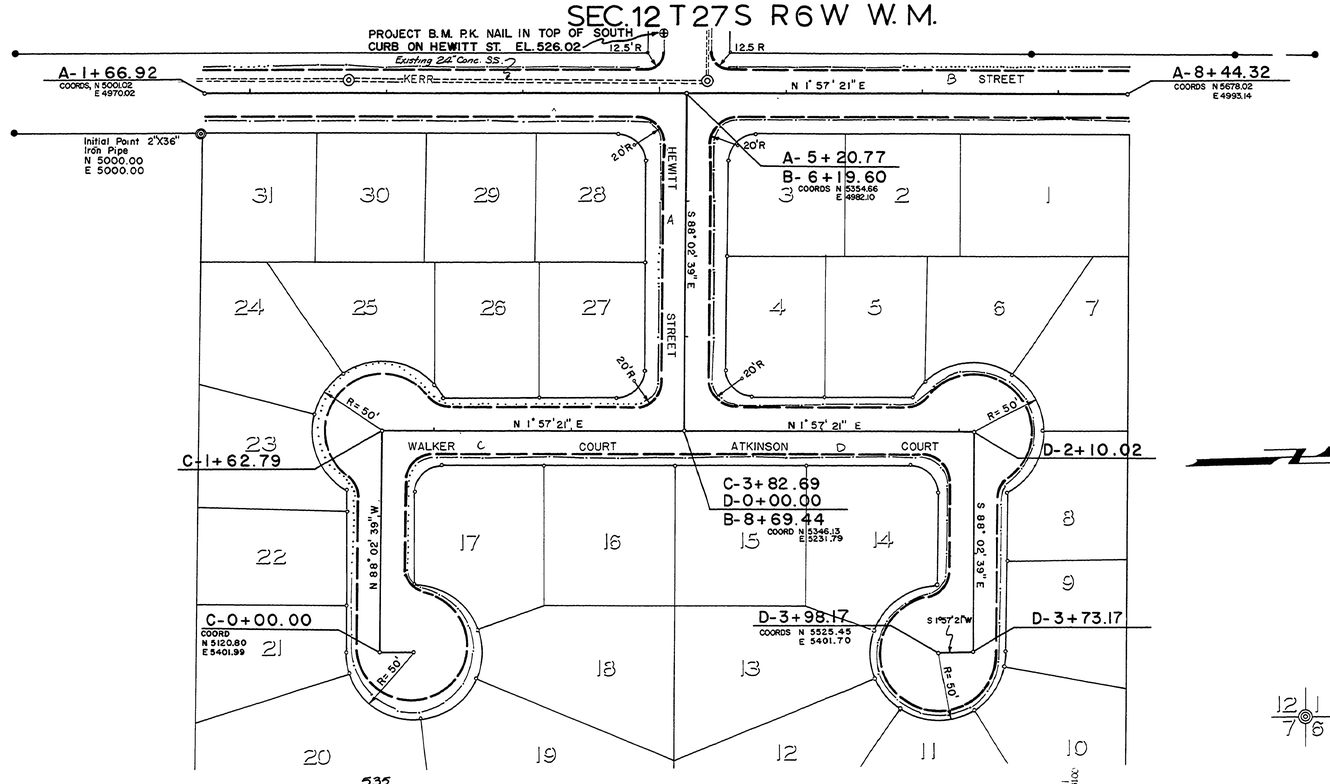

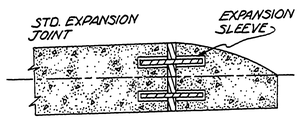

TYPICAL SECTION FOR CURB ENDS AT "A" 1+66.92 & "A" 8+44.32

W 5+00 RT
W 5+45 LT
R 22+75 LT-RT

Found Brass Cap
N 6753.63 SECS. 1 & 12 T27S R6W W.M.
E 5657.03 SECS. 6 & 7 T27S R5W W.M.

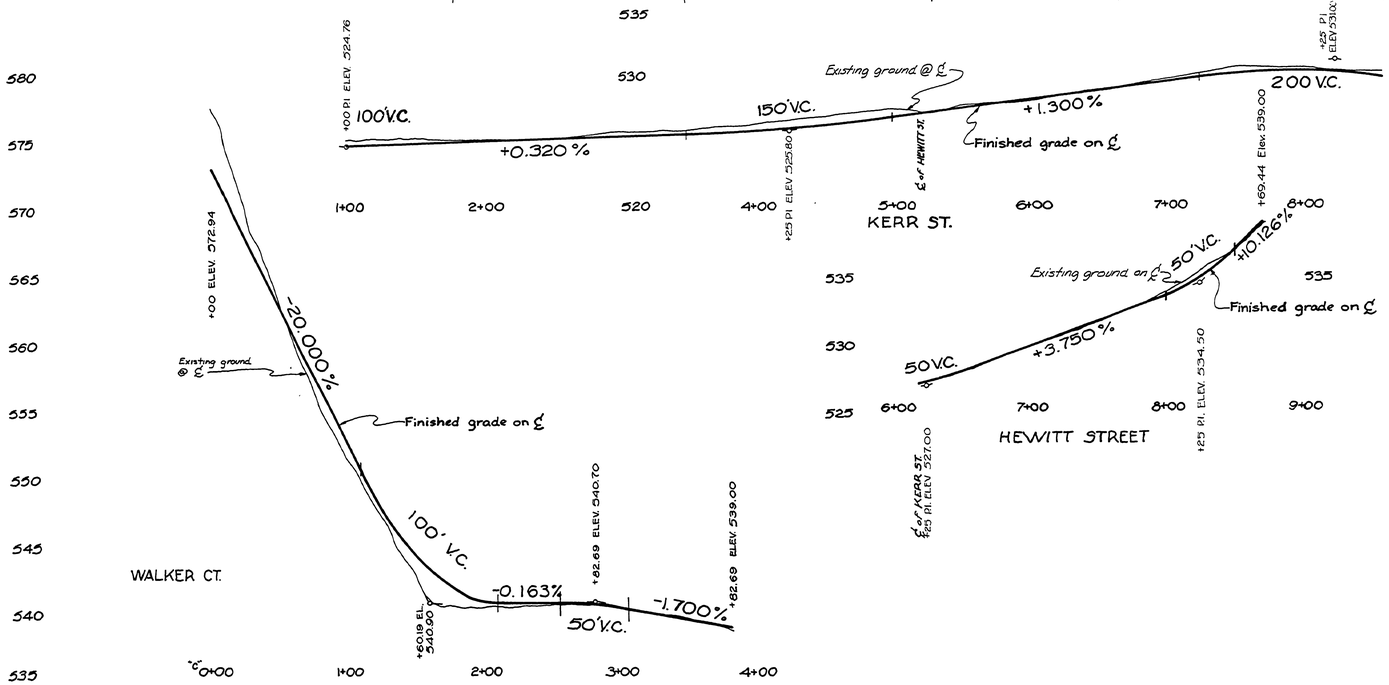

AS BUILT 6-27-75 R.J.

DOUGLAS COUNTY ROAD DEPT.
HEWITT HEIGHTS RD #297

1974 SHT. 3

GEORGE E. GRUBB COUNTY ENGR.

00160021

M.P. 0.16 - 0.21

Co. Rd. # 297 1974 sht. 3 (37)