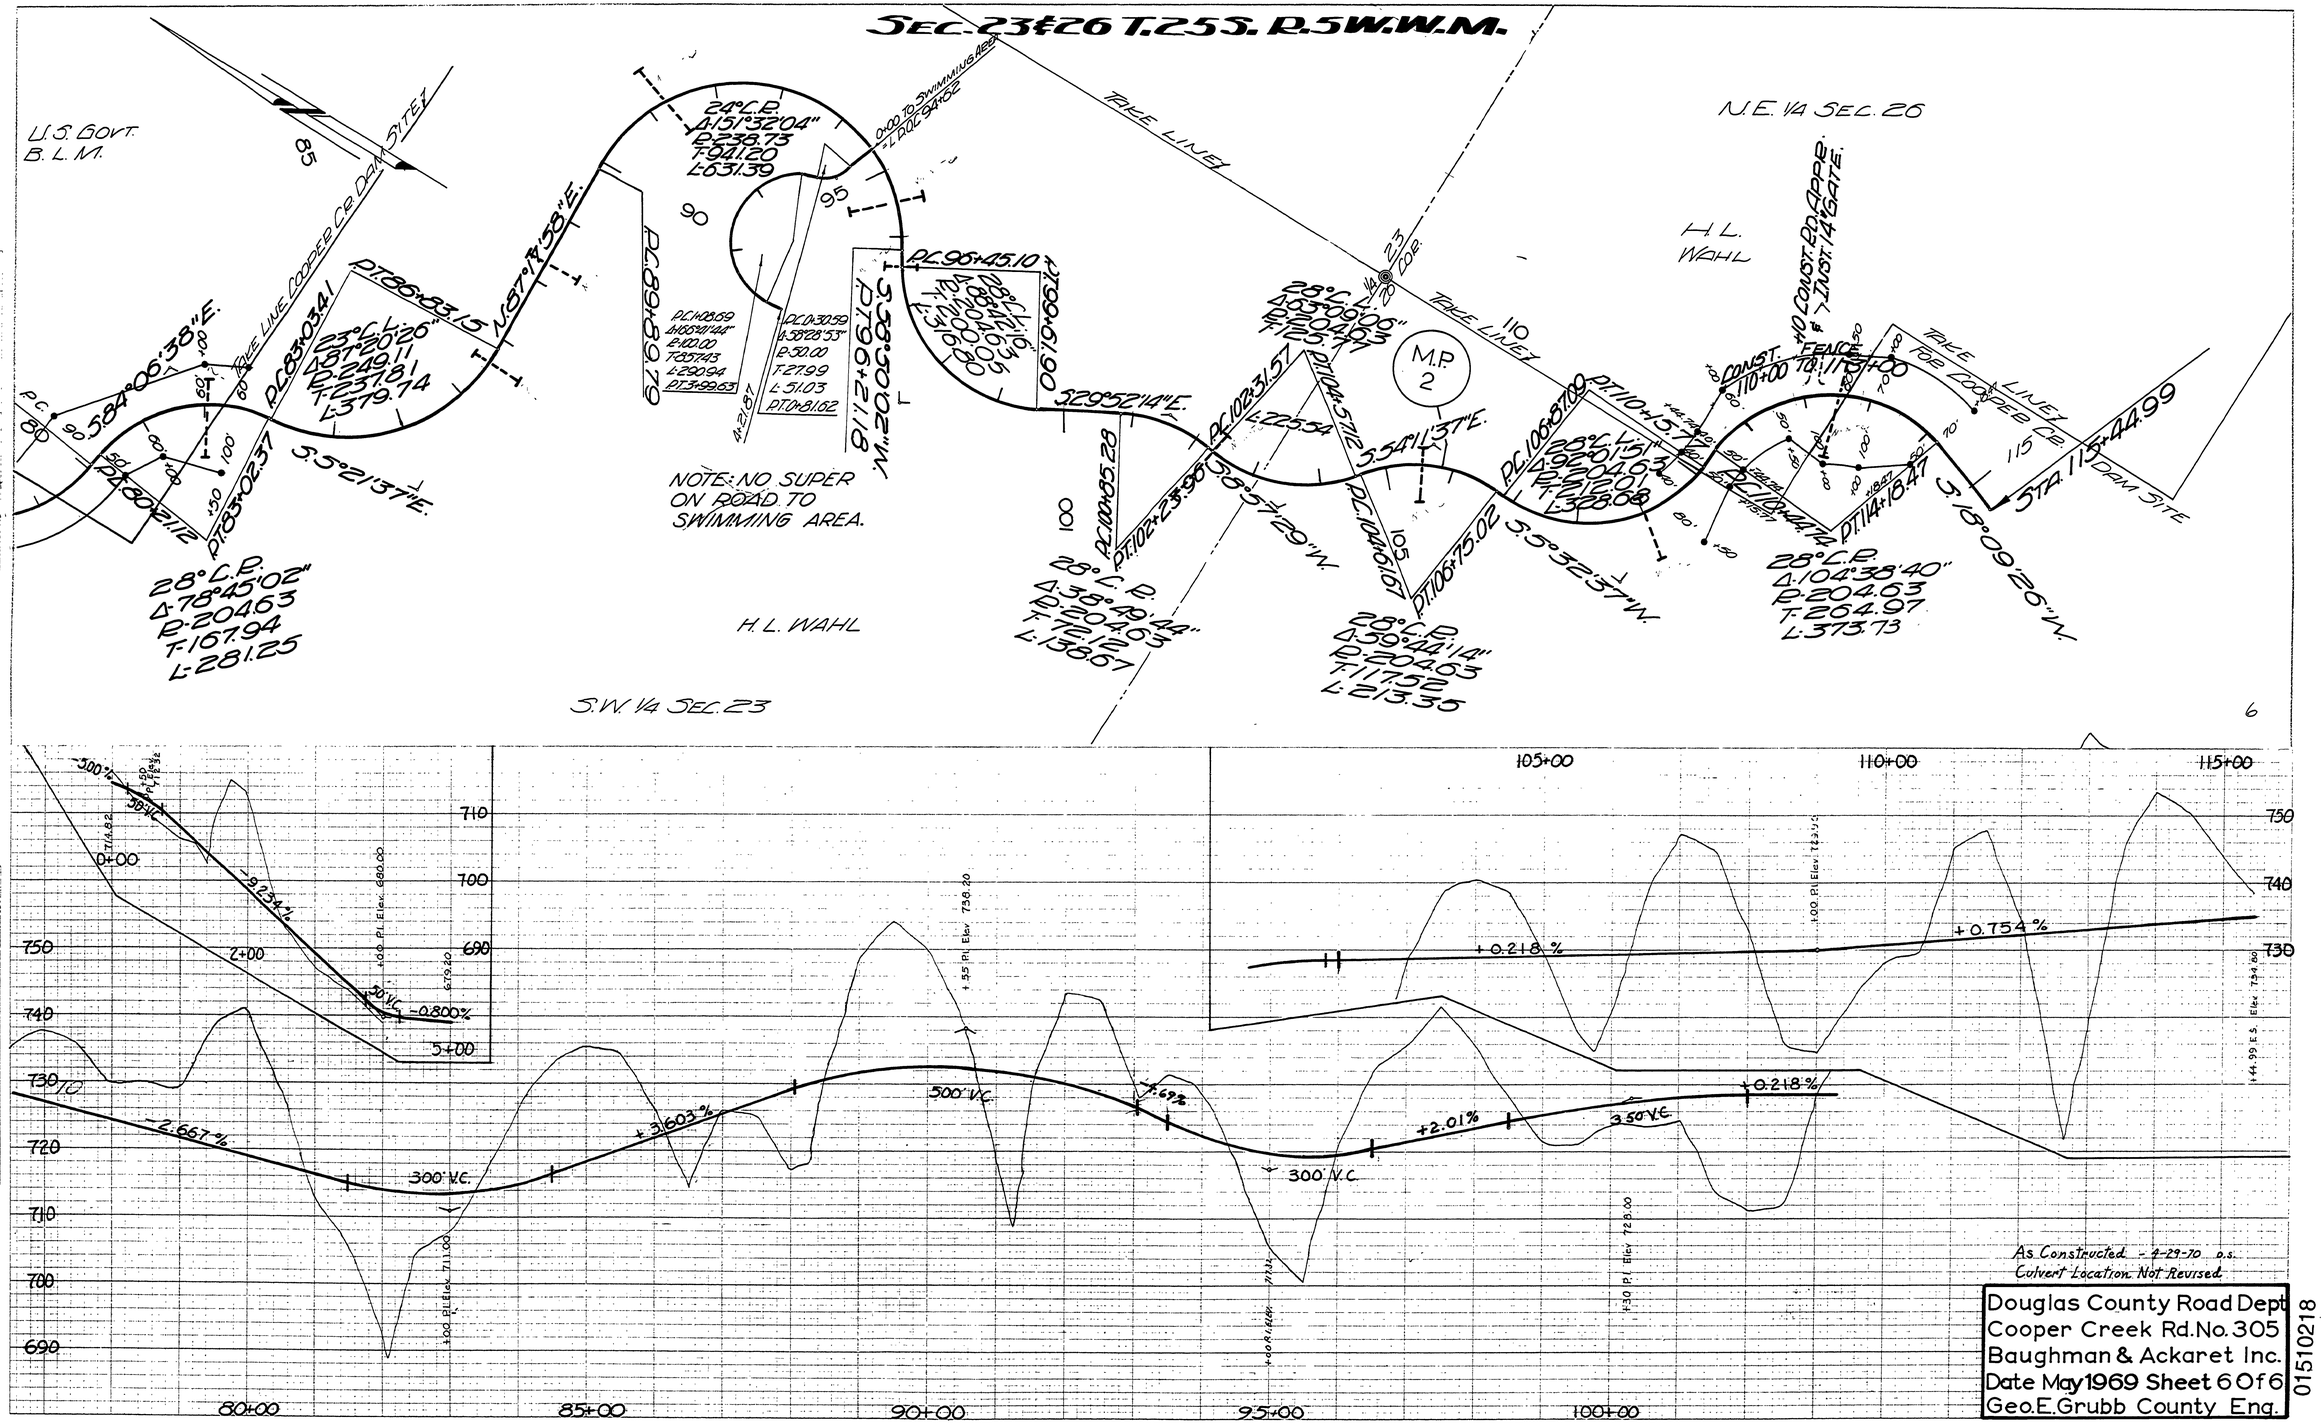

M.P. 1.51 - 2.18

Co. Rd. # 305

May, 1969

Sht. 6 of 6

(8)