RD. 308

FILED
RECEIVED
JAN 1 8 ...
COUNTY SURVEYOR
DOUGLAS COUNTY, ORE.

SEC. 12 T27S R6W WM

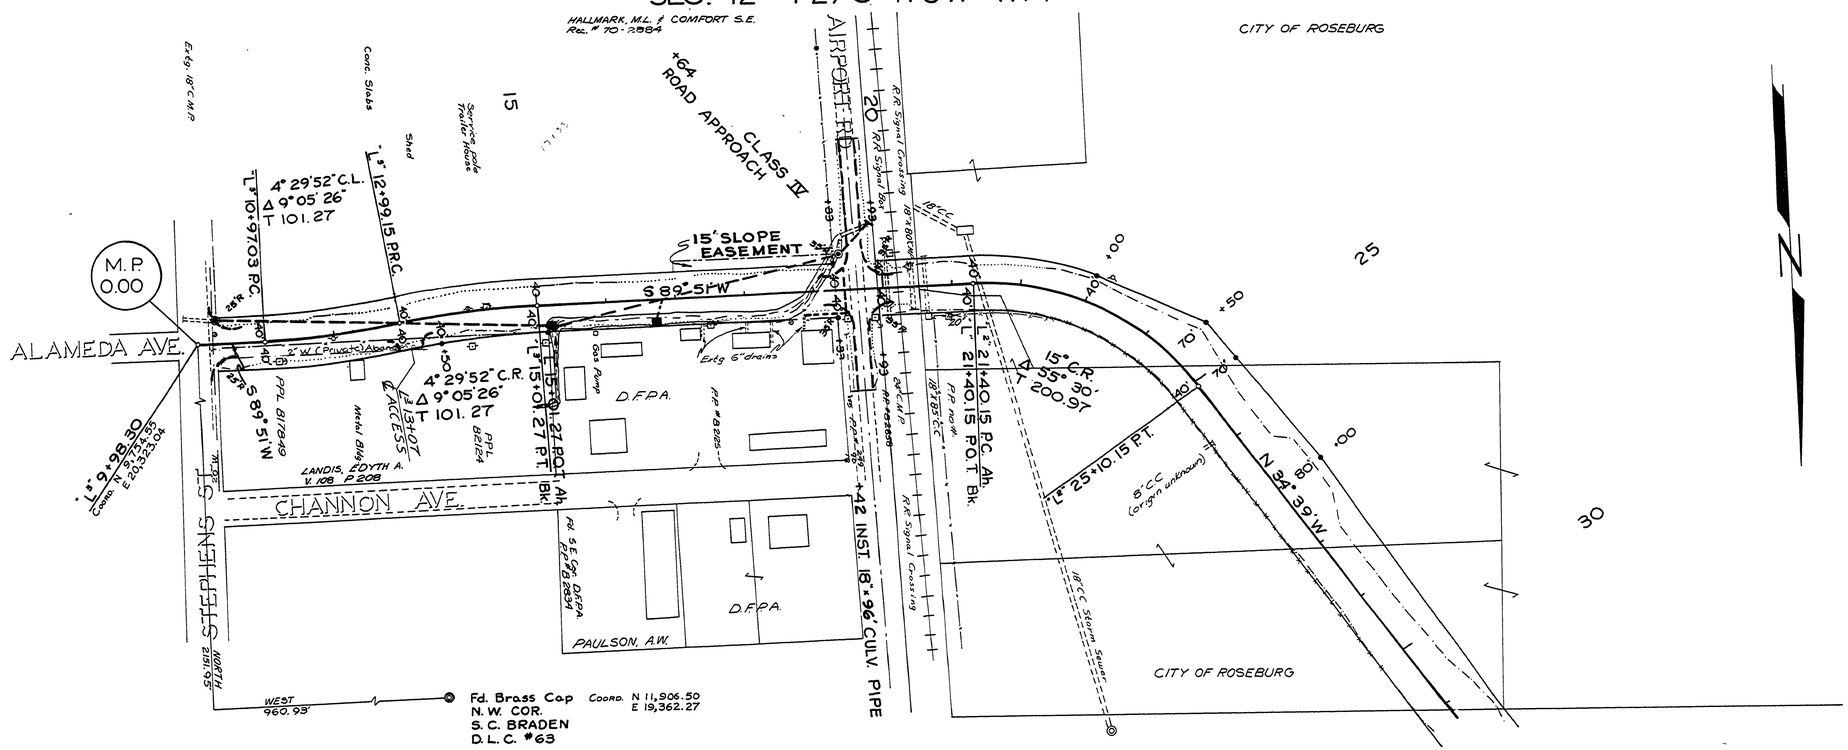

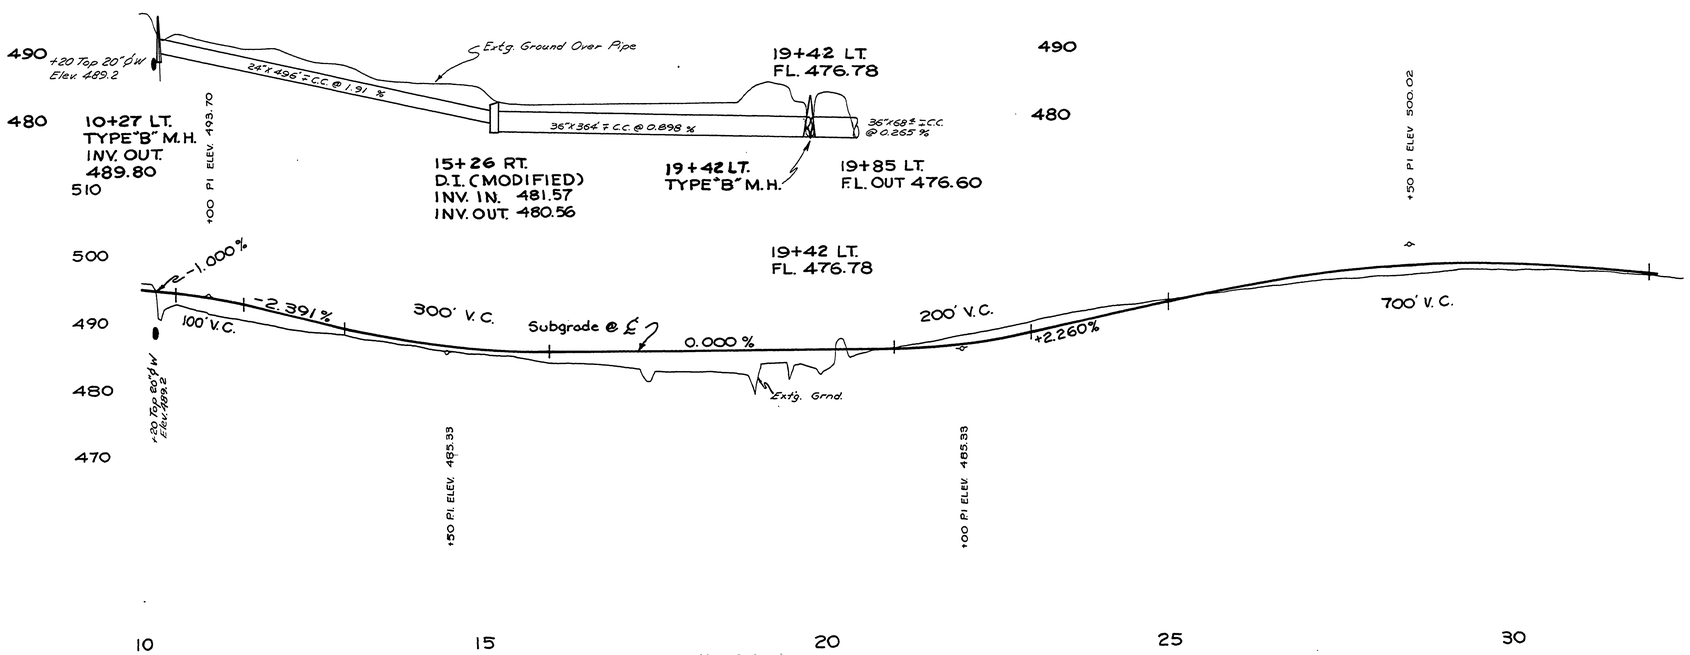

As Construction
JW 1-11-77

DOUGLAS COUNTY
PUBLIC WORKS DEPARTMENT
STEWART PARKWAY ROAD 308
1975 SHT. 6
GEORGE E. GRUBB, DIRECTOR

00000059

M.P. 0.00 - 0.59

G. Rd. # 308 1975 sht. 6

13