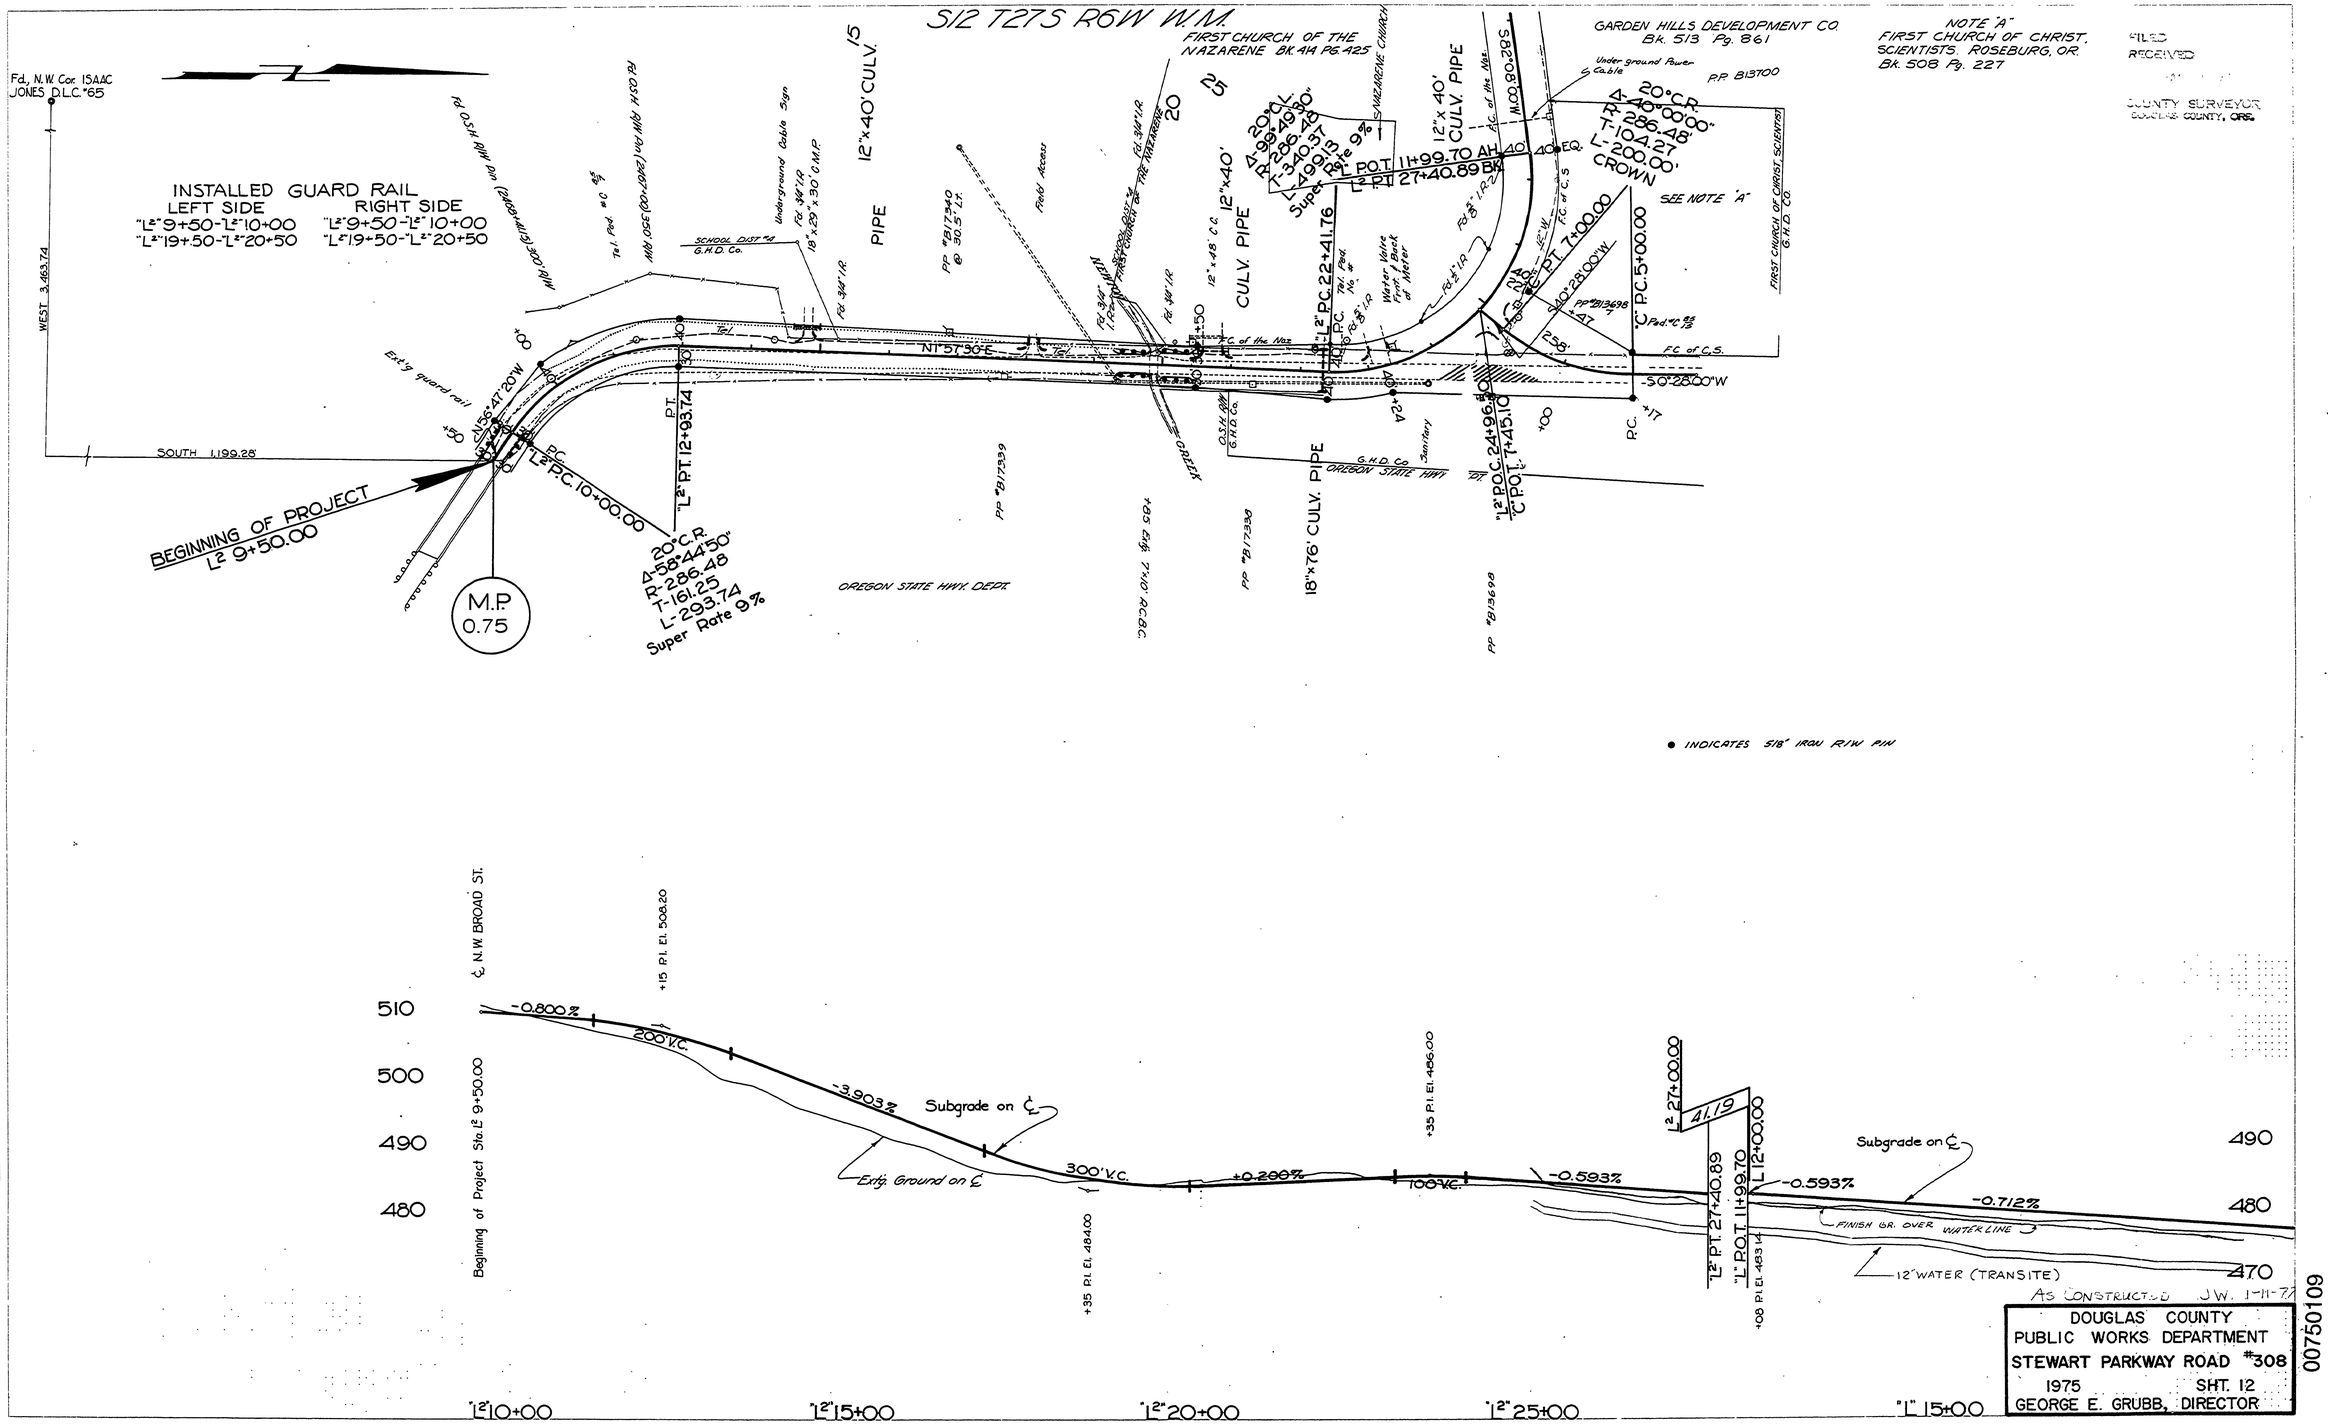

● INDICATES 5/8" IRON R/W PIN

AS CONSTRUCTED J.W. 1-11-77

DOUGLAS COUNTY
PUBLIC WORKS DEPARTMENT
STEWART PARKWAY ROAD #308
1975 SHT. 12
GEORGE E. GRUBB, DIRECTOR

00750109

1975

M.P. 0.75 - 1.09 C. Rd. #308 sht. 12