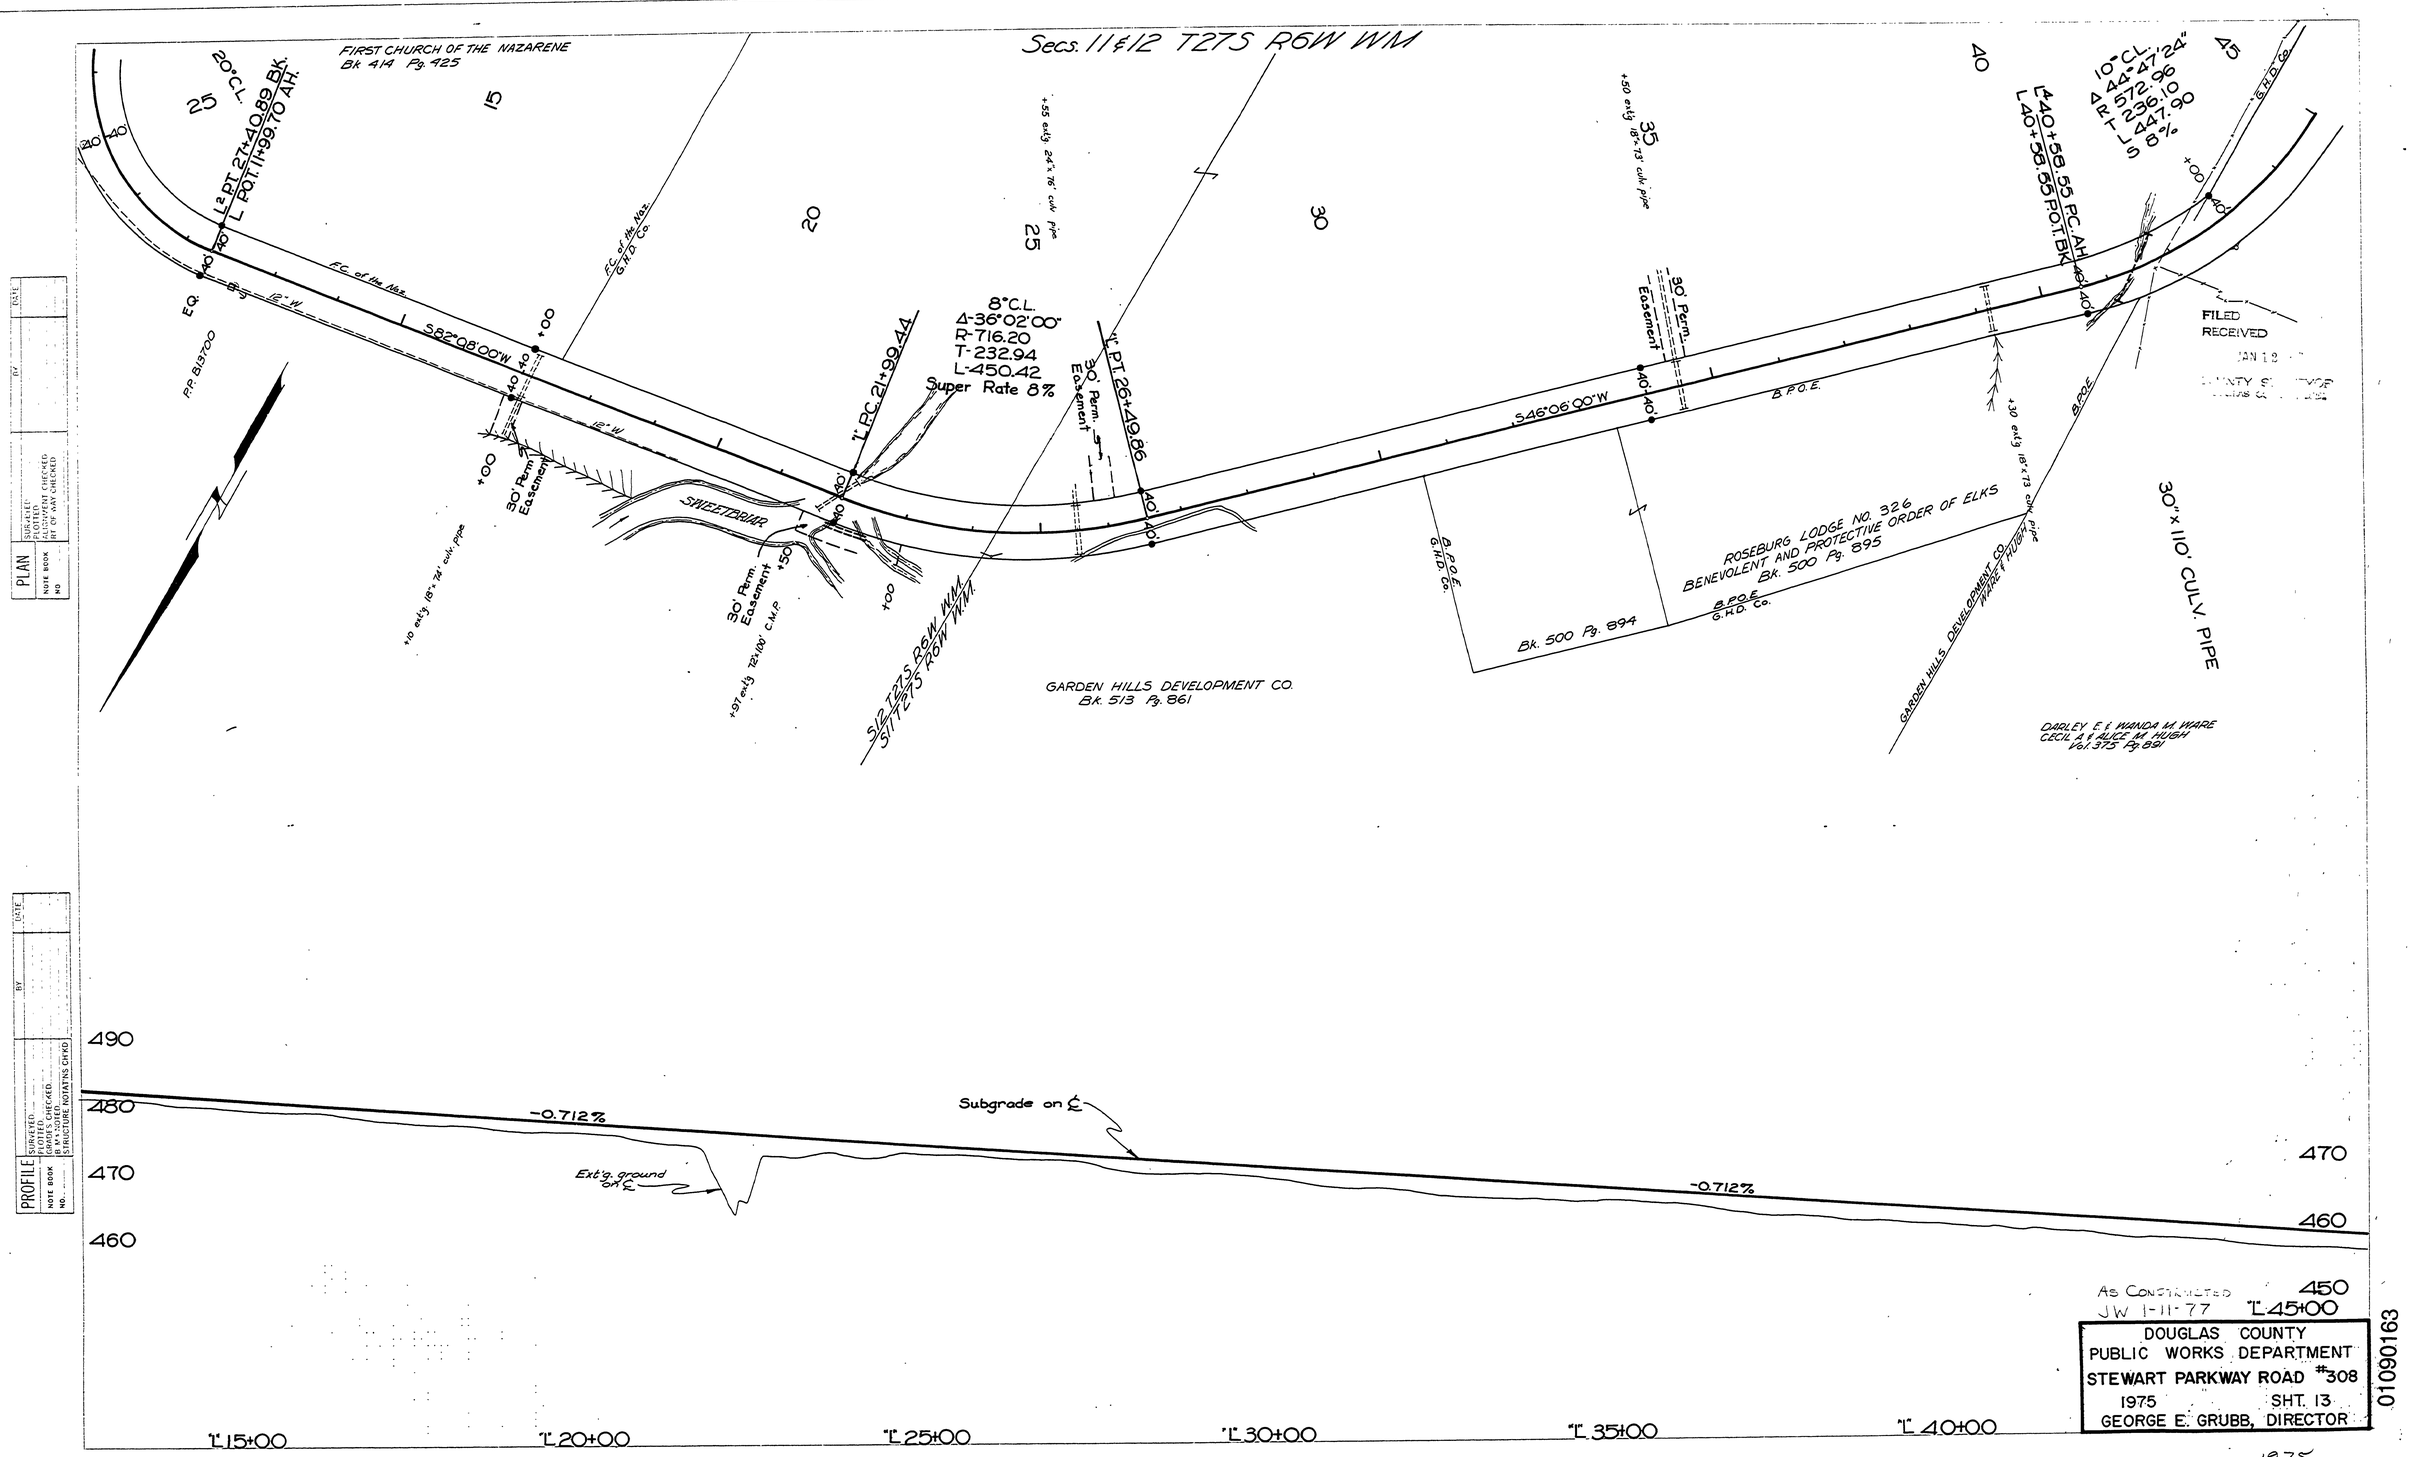
Secs. 11 & 12 T27S R6W WM
FIRST CHURCH OF THE NAZARENE
Bk. 414 Pg. 425
20° C.L.
Δ 2 PT. 27+40.89 BK.
L PO.T. 11+99.70 AH.
F.C. of the Nat.
G.H.D. Co.
E.Q.
P.P. 813700
S82°08'00"W
12" W.
+00
30' Perm. Easement
SWEETBRIAR
+10 ex'tg 18" x 74' cuk. pipe
+97 ex'tg 72"x100' C.M.P.
+50
S12 T27S R6W WM
S11 T27S R6W WM
8° C.L.
Δ-36°02'00"
R-716.20
T-232.94
L-450.42
Super Rate 8%
1° P.C. 21+99.44
1° P.T. 26+49.86
30' Perm. Easement
+55 ex'tg 24" x 76' cuk. pipe
GARDEN HILLS DEVELOPMENT CO.
Bk. 513 Pg. 861
S46°06'00"W
B.P.O.E.
B.P.O.E. G.H.D. Co.
Bk. 500 Pg. 894
ROSEBURG LODGE NO. 326
BENEVOLENT AND PROTECTIVE ORDER OF ELKS
Bk. 500 Pg. 895
B.P.O.E. G.H.D. Co.
+50 ex'tg 18" x 73' cuk. pipe
+30 ex'tg 18" x 73' cuk. pipe
GARDEN HILLS DEVELOPMENT CO.
HARRY & HUGH
10° C.L.
Δ 44°47'24"
R 572.96
T 236.10
L 447.90
S 8%
L 40+58.55 RC. AH.
L 40+58.55 PO.T. BK.
+00
FILED
RECEIVED
JAN 1 9
COUNTY SURVEYOR
DOUGLAS CO. OREGON
30" x 110' CULV. PIPE
DARLEY E. & WANDA M. WARE
CECIL A. & ALICE M. HUGH
Vol. 375 Pg. 891
PLAN
SURVEYED
PLOTTED
ALIGNMENT CHECKED
BY CG AND CHECKED
NOTE BOOK
NO.
DATE
BY
PROFILE
SURVEYED
PLOTTED
GRADES CHECKED
BY
STRUCTURE NOTATIONS CHKD
490
480
470
460
450
-0.712%
Subgrade on ℄
Ext'g. ground on ℄
-0.712%
AS CONSTRUCTED
JW 1-11-77
℄ 45+00
℄ 15+00
℄ 20+00
℄ 25+00
℄ 30+00
℄ 35+00
℄ 40+00
DOUGLAS COUNTY
PUBLIC WORKS DEPARTMENT
STEWART PARKWAY ROAD #308
1975
SHT. 13
GEORGE E. GRUBB, DIRECTOR
01090163
1975
M.P. 1.09 - 1.63
G. Rd #308
sht. 13
12