FILED
RECEIVED
JAN 12 1977
COUNTY SURVEYOR
DOUGLAS COUNTY, ORE.

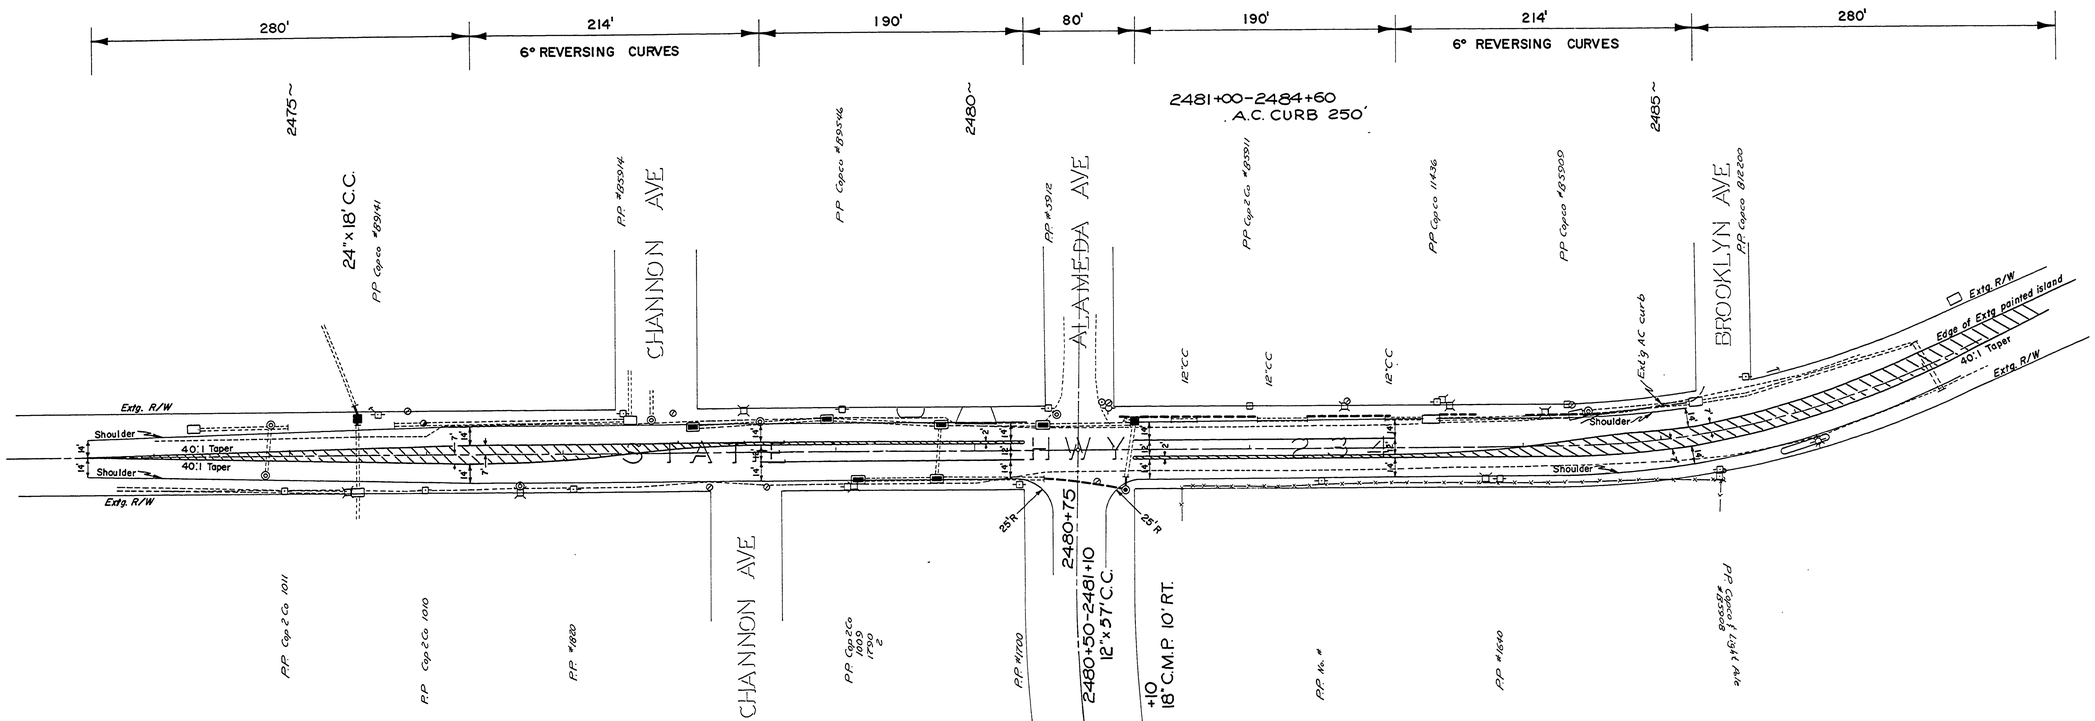

As Constructed
JW 1-11-77

DOUGLAS COUNTY
PUBLIC WORKS DEPARTMENT
STEWART PARKWAY ROAD #308
1975 SHT. 4
GEORGE E. GRUBB, DIRECTOR

RD308TYP

State Hwy. #23 1975
Co. Rd. #308 sht. 4 (12)