PALOMINO AVE.
LENGTH OF PROJ. 0.16 MILES

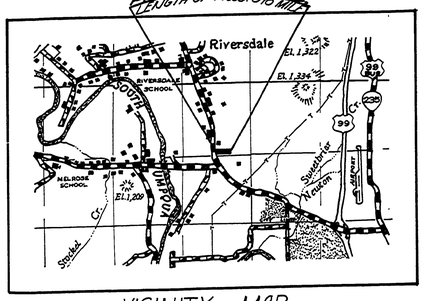

VICINITY MAP
GARDEN-VALLEY AREA

REGISTERED PROFESSIONAL ENGINEER
James E. Gruidl
4250
MAY 2, 1958
GEORGE E. GRUBB

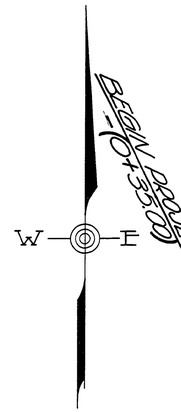

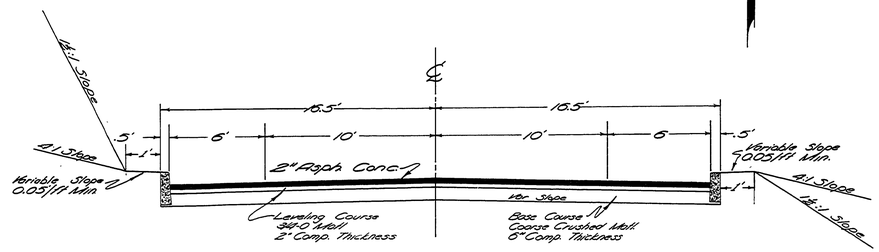

TYPICAL SECTION

D.L.C. #43 T.27S. R.6W. W.M.

FRONTIER

ESTATES

E. GARDEN VALLEY RD. CO. RD. #6

BEGIN PROJECT Sta. 0+00

+00 Const. Catch Basin Installed 12" Conc. Culv. 28 Ft.

+00 Const. Catch Basin Installed 12" Conc. Culv. 36 Ft.

Sta. 0+00 to Sta. 8+30 Const. type B Conc. Curbs Rt. & Lt.

PALOMINO AVENUE

S59°39'00"E

30'

30'

30'

30'

GAS COMPANY

END PROJECT Sta. 8+30.00

(-0+06) Installed 18" Con. Culv. 36 Ft.

+00 Const. Catch Basin

0+00 to 8+30 Installed 18" Conc. Culv. 828 Ft.

+98 Const. Catch Basin

+25 Const. Catch Basin

+31 Const. Catch Basin

80' E/W EL A250

16 15 14 13 12 11 10 9

1 2 3 4 5 6 7 8

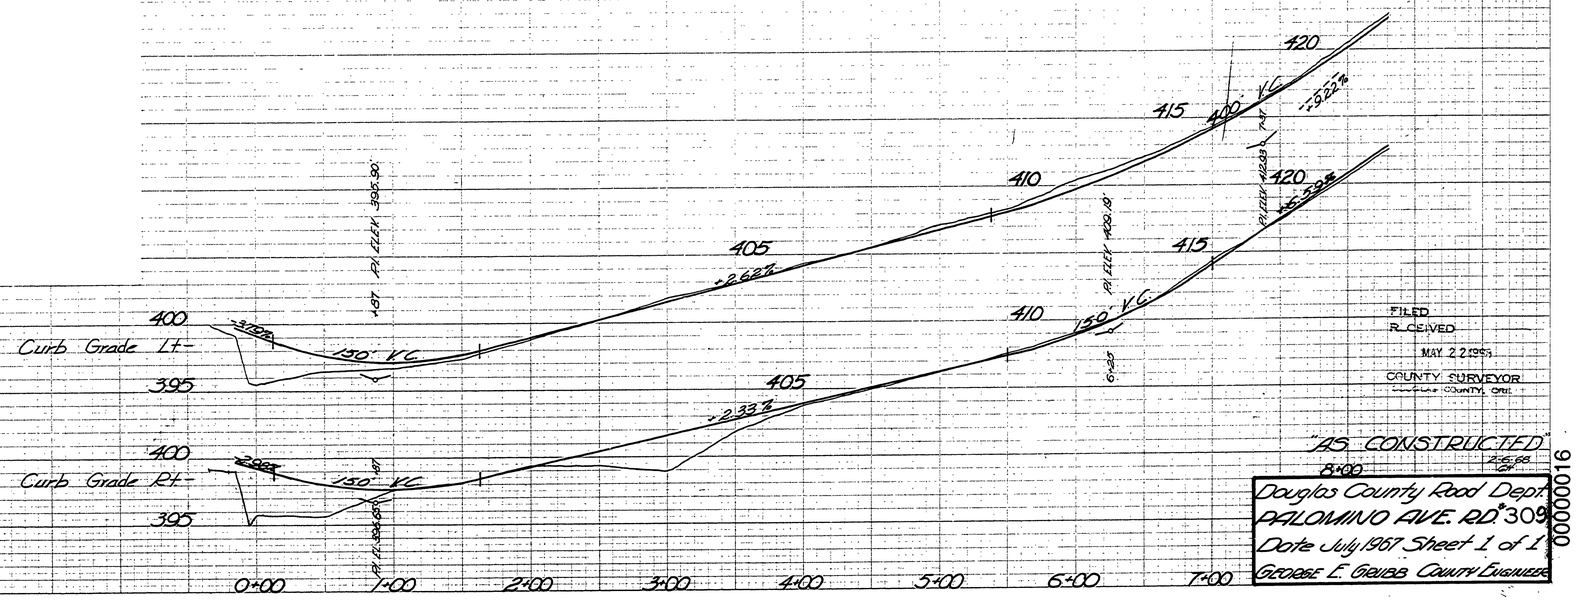

FILED
RECEIVED
MAY 22 1958
COUNTY SURVEYOR
Douglas County, Ore.

"AS CONSTRUCTED"
2668
SP

Douglas County Road Dept.
PALOMINO AVE. RD. #309
Date July 1967 Sheet 1 of 1
GEORGE E. GRUBB COUNTY ENGINEER

00000016

FINAL SURVEY — SURVEYED / PLOTTED / TEMPLATE / AREAS / AREAS CHECKED — NO. — BY — DATE

ORIGINAL SURVEY — SURVEYED / PLOTTED / TEMPLATE / AREAS / AREAS CHECKED — NO. — BY — DATE

M.P. 0.00 - 0.16

G Rd. #309

July, 1967

Sht. 1 of 1

27