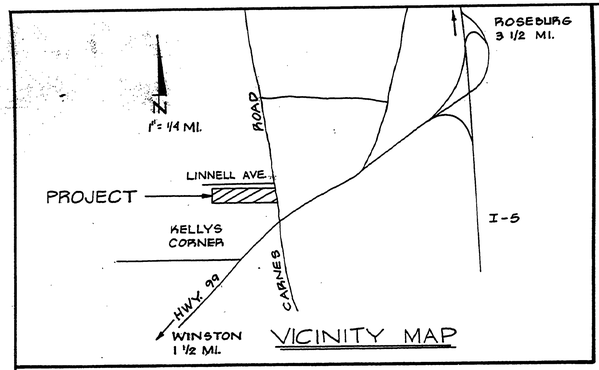

VICINITY MAP

NOTES

1. PROJECT B.M. : NAIL IN P.P. # B 6027, EL. 506.04
2. ALL BEARINGS ARE TRUE.
3. ALL CURB RETURNS : R = 20' Δ = 90° L = 31.42'
4. ALL CONST. SHALL COMPLY WITH REQUIREMENTS OF THE DOUGLAS CO. DEPT. OF PUBLIC WORKS. ARRANGE FOR COUNTY INSPECTION PRIOR TO BEGINNING CONST.
5. PERFORM LOT GRADING AS DIRECTED BY OWNER.

NOTE: DASHED LINES DENOTE LOT CHANGES, SEE FILED PLAT MAPS.

AS BUILT

FILED
AUG 10 1987
COUNTY SURVEYOR
DOUGLAS COUNTY, ORE.

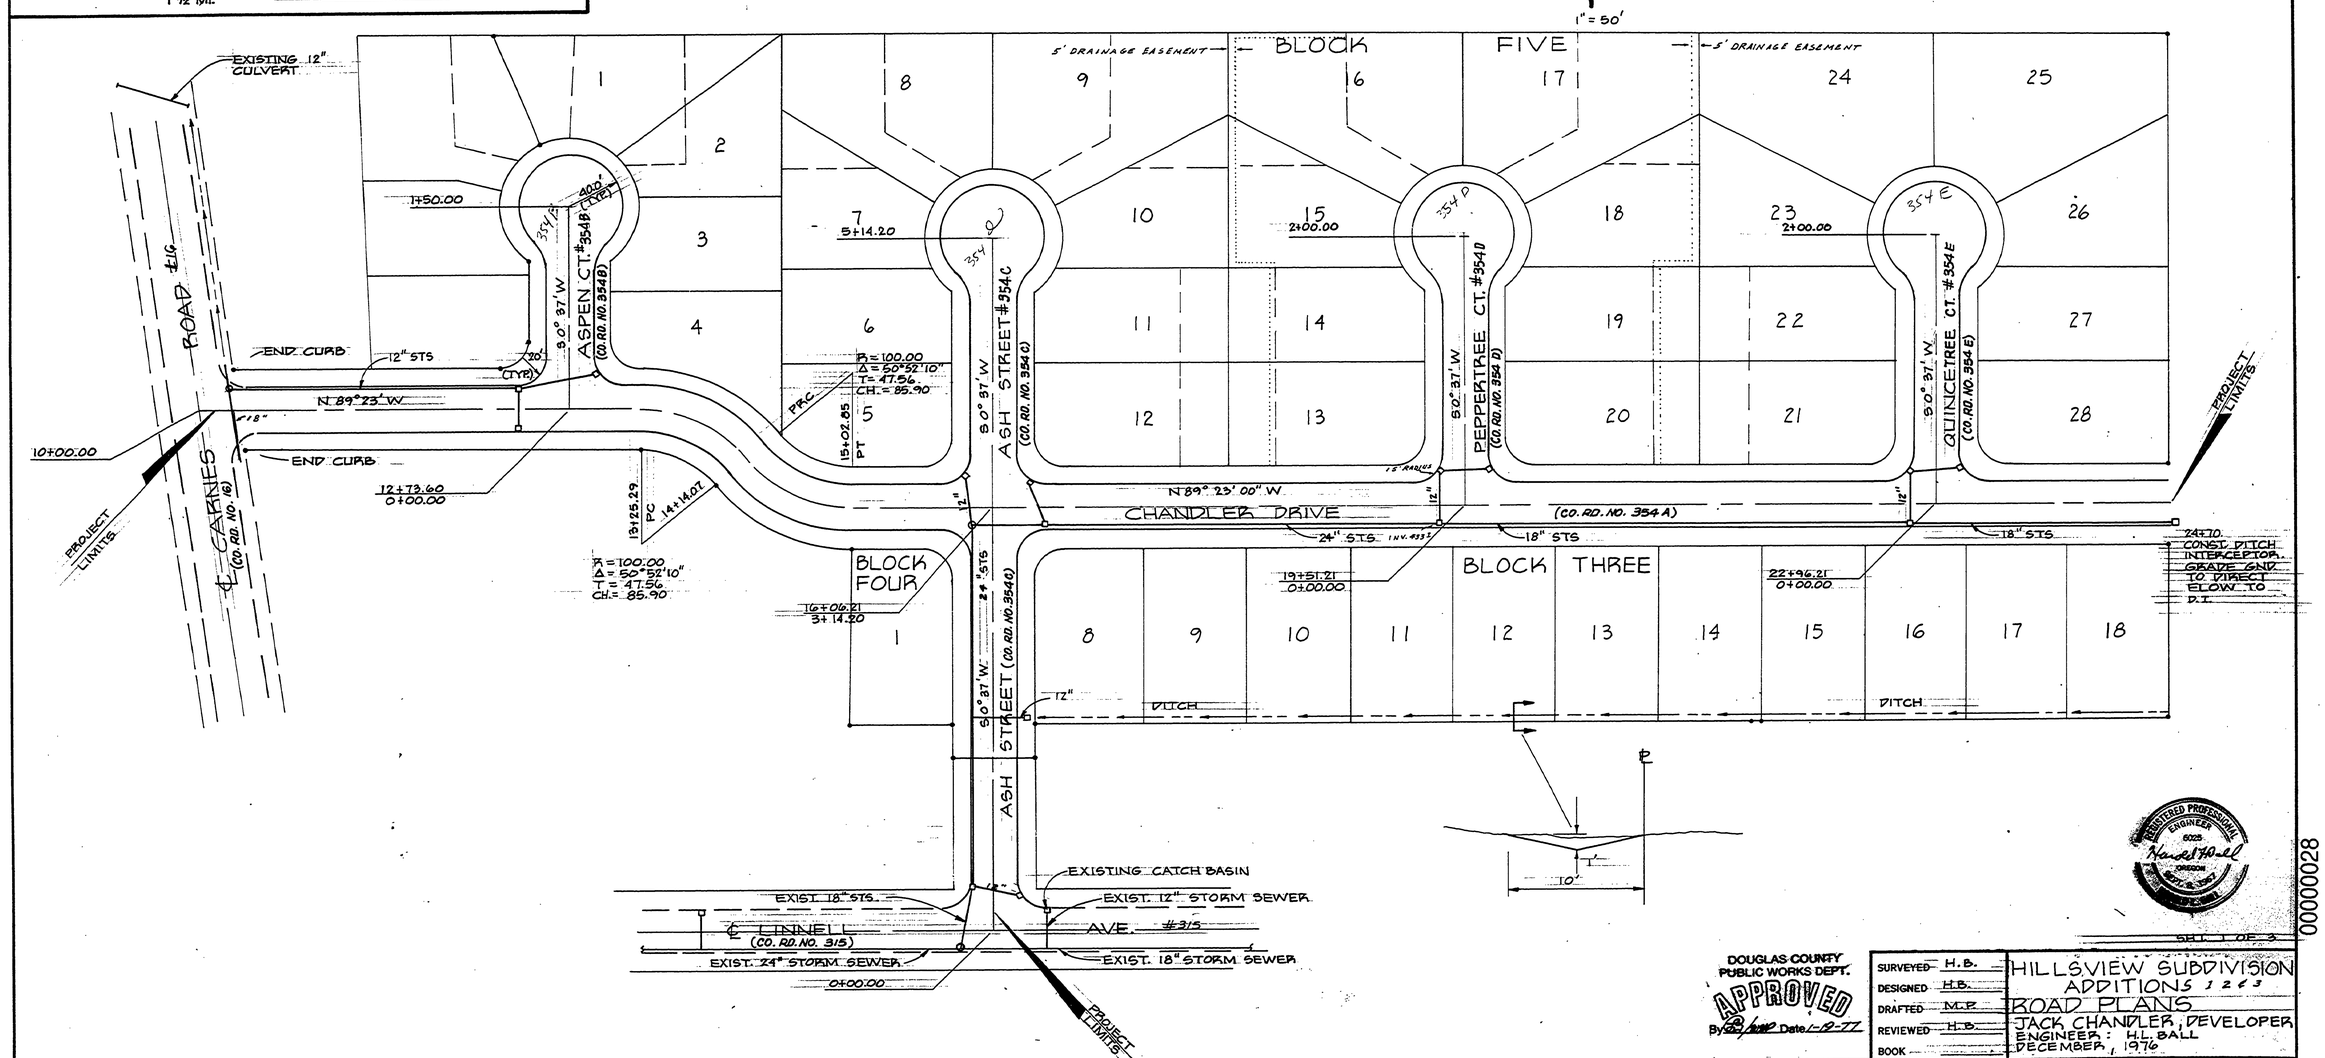

REGISTERED PROFESSIONAL ENGINEER 6025 Harold Ball OREGON

DOUGLAS COUNTY PUBLIC WORKS DEPT. APPROVED By Date 1-12-77

SURVEYED H.B.	HILLSVIEW SUBDIVISION ADDITIONS 1 2 & 3
DESIGNED H.B.	ROAD PLANS
DRAFTED M.P.	JACK CHANDLER, DEVELOPER
REVIEWED H.B.	ENGINEER: H.L. BALL
BOOK	DECEMBER, 1976

SHT. 1 OF 3

CHANDLER DR. CO. RD. NO. 354A
ASPEN CT. CO. RD. NO. 354B
ASH ST. CO. RD. NO. 354C
PEPPERTREE CT. CO. RD. NO. 354D
QUINCETREE CT. CO. RD. NO. 354E
S. 11/10, T. 28 S., R. 6 W., W.M.

00000028

GARGADE MICROFILM/PRECISION GRAPHICS

M.P. 0.00 - 0.28

#354A 1976

93