
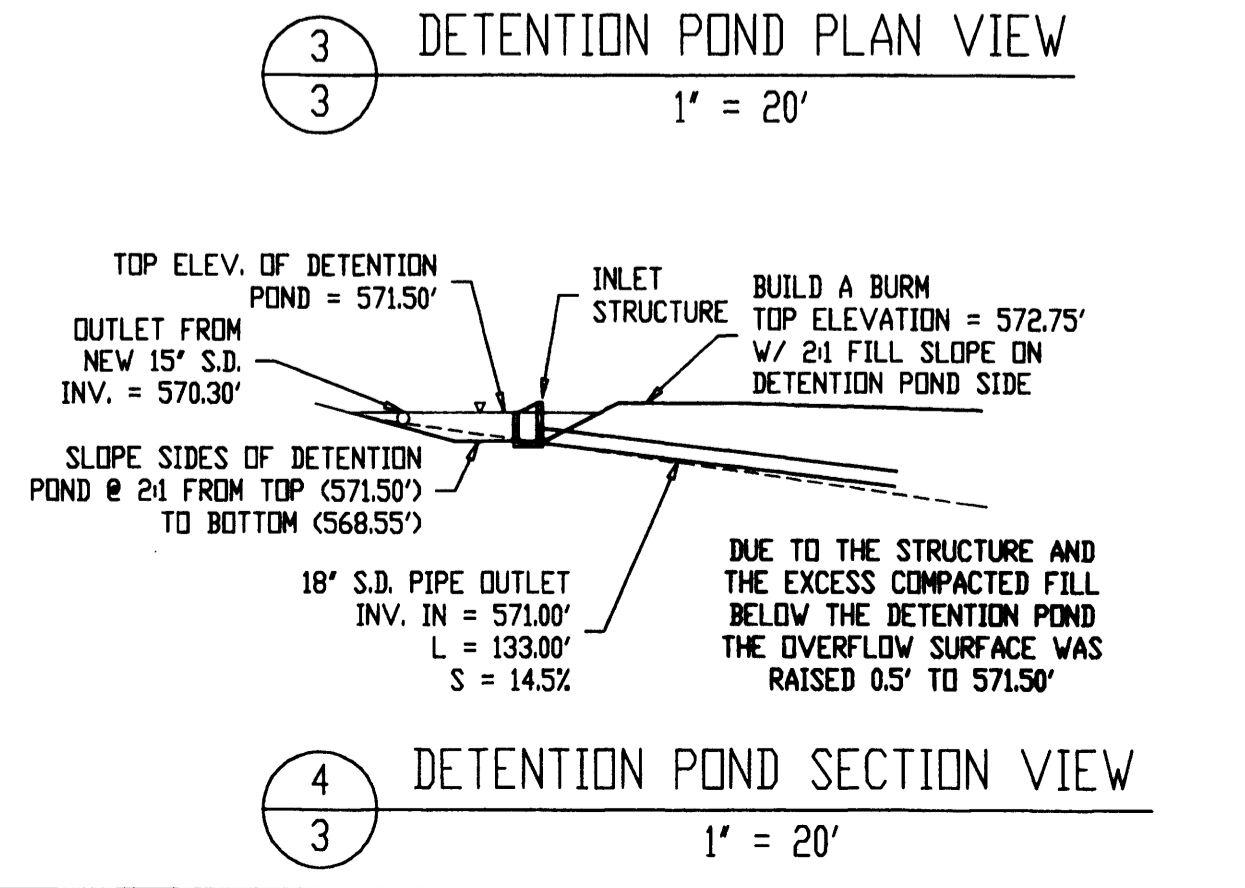


DETAILED DATA:

- DETECTION POND CALCULATIONS:
- DETECTION POND INTAKE RATE: 25 YR. STORM ON FULLY DEVELOPED SUBDIVISION
- POND STORAGE VOLUME: 732 CUBIC FEET
- POND OUTLET RATE: EQUIVALENT TO A 2 YR. STORM ON UNDEVELOPED GRASSLAND

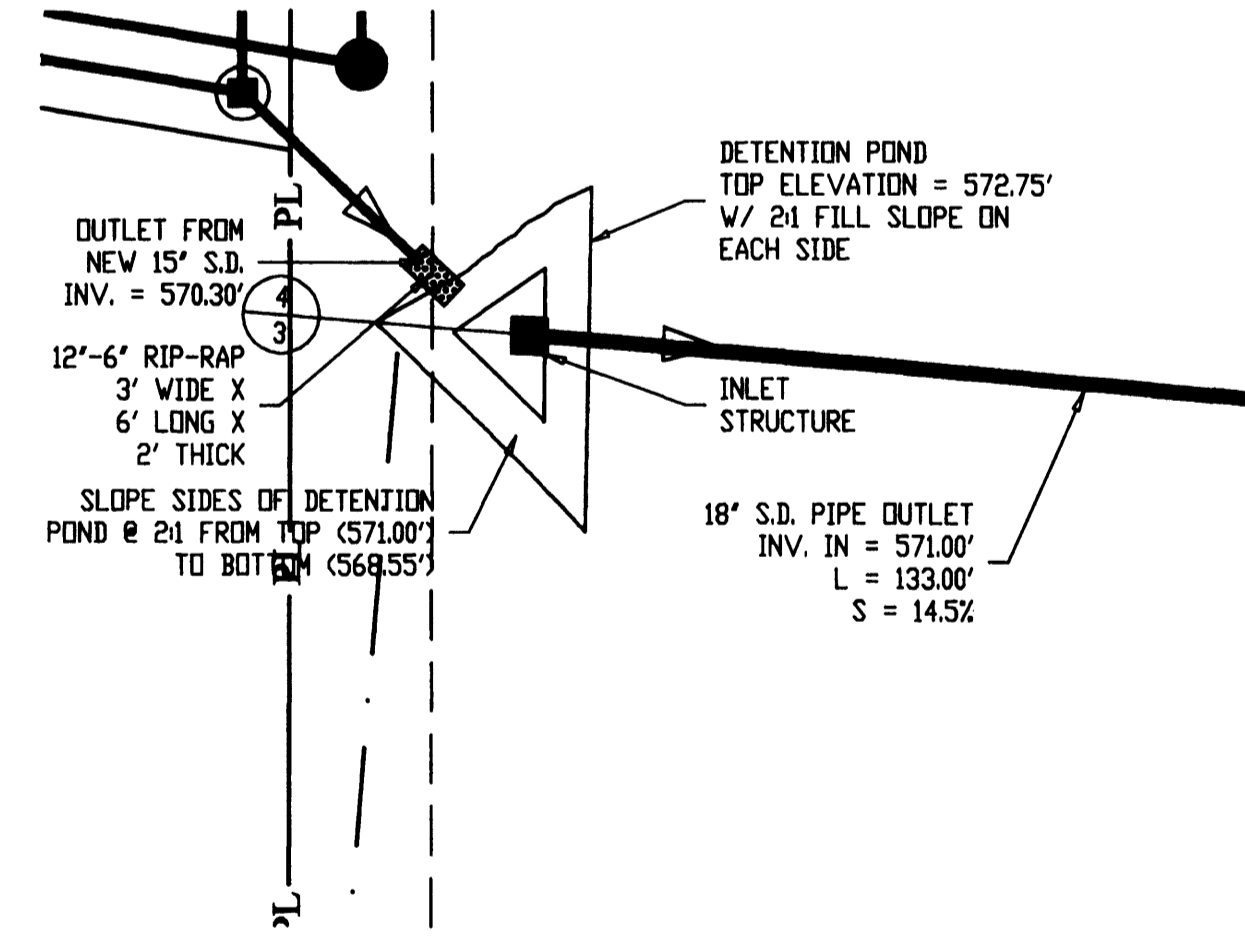

FILED
Date: 4-22-2004 By: JP
This survey consists of:
Map:
Narrative:
Corner F&P:
DOUGLAS COUNTY SURVEYOR

OWNER: STULL ENTERPRISES

PROJECT: SAVOY COURT SUBDIVISION

PROJECT TITLE: SAVOY COURT STREET & STORM PLAN & PROFILE

DATE: MAY 20, 2004

REV. #1: -
REV. #2: -
REV. #3: -
REV. #4: -
REV. #5: -

REGISTERED PROFESSIONAL ENGINEER
10235
DAVID G. PHILLIPS
EXPIRATION DATE: 12/31/04

PROJ. # 04-011

SHEET NO. 3 of 9

00000014