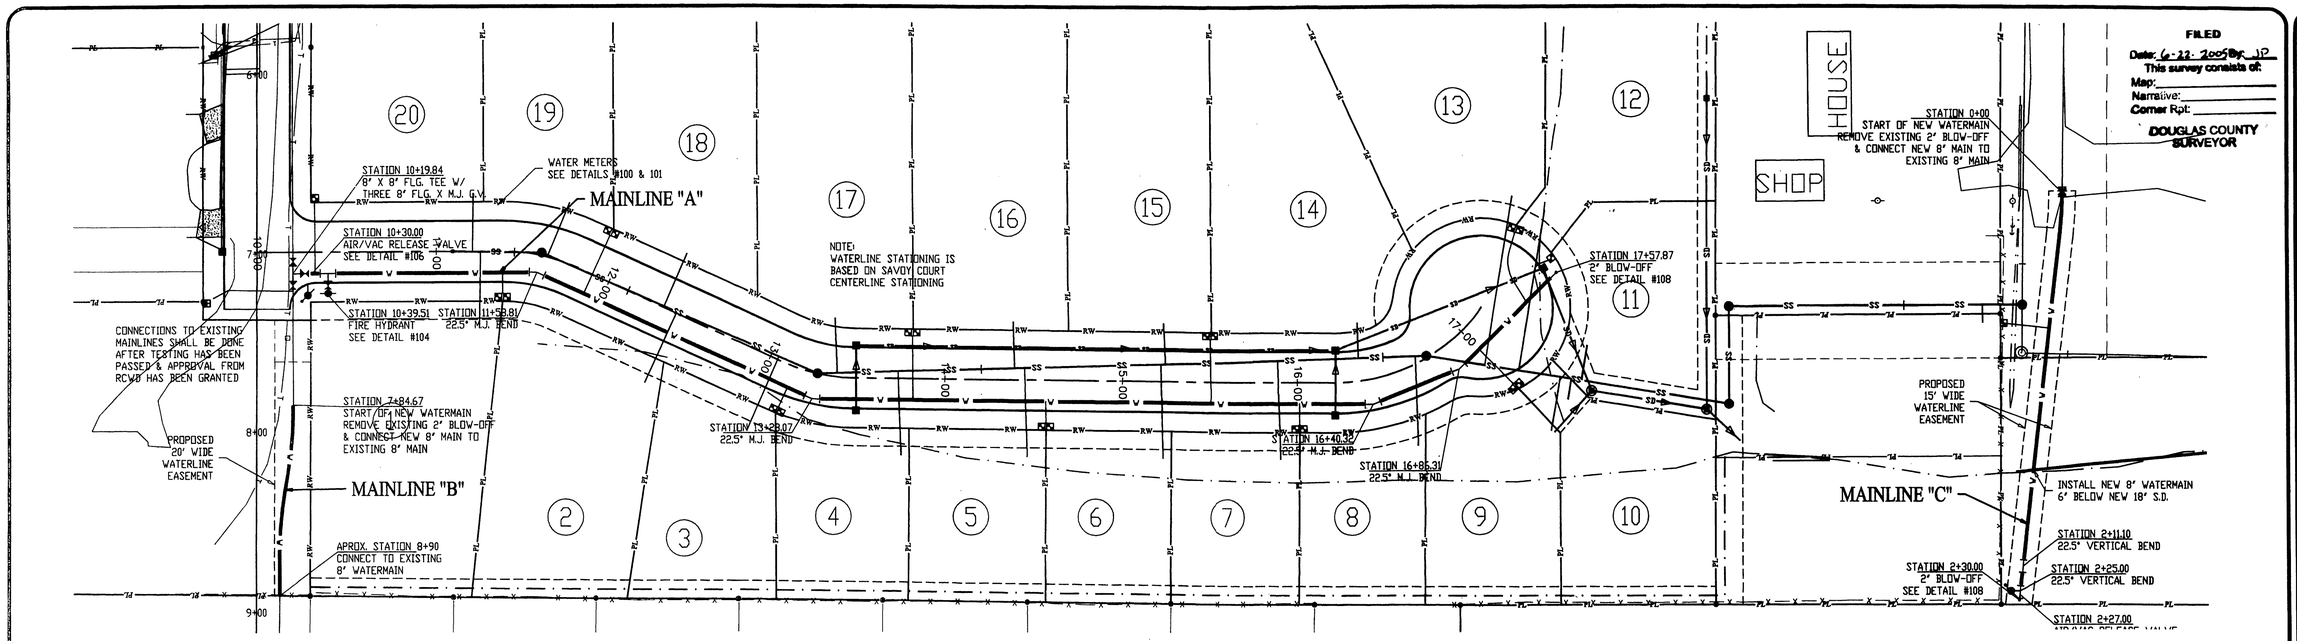

1/5 WATERLINE PLAN
1" = 40'

WATER MAIN AS-BUILTS (9/23/04)

MAINLINE "A" - PROFILE

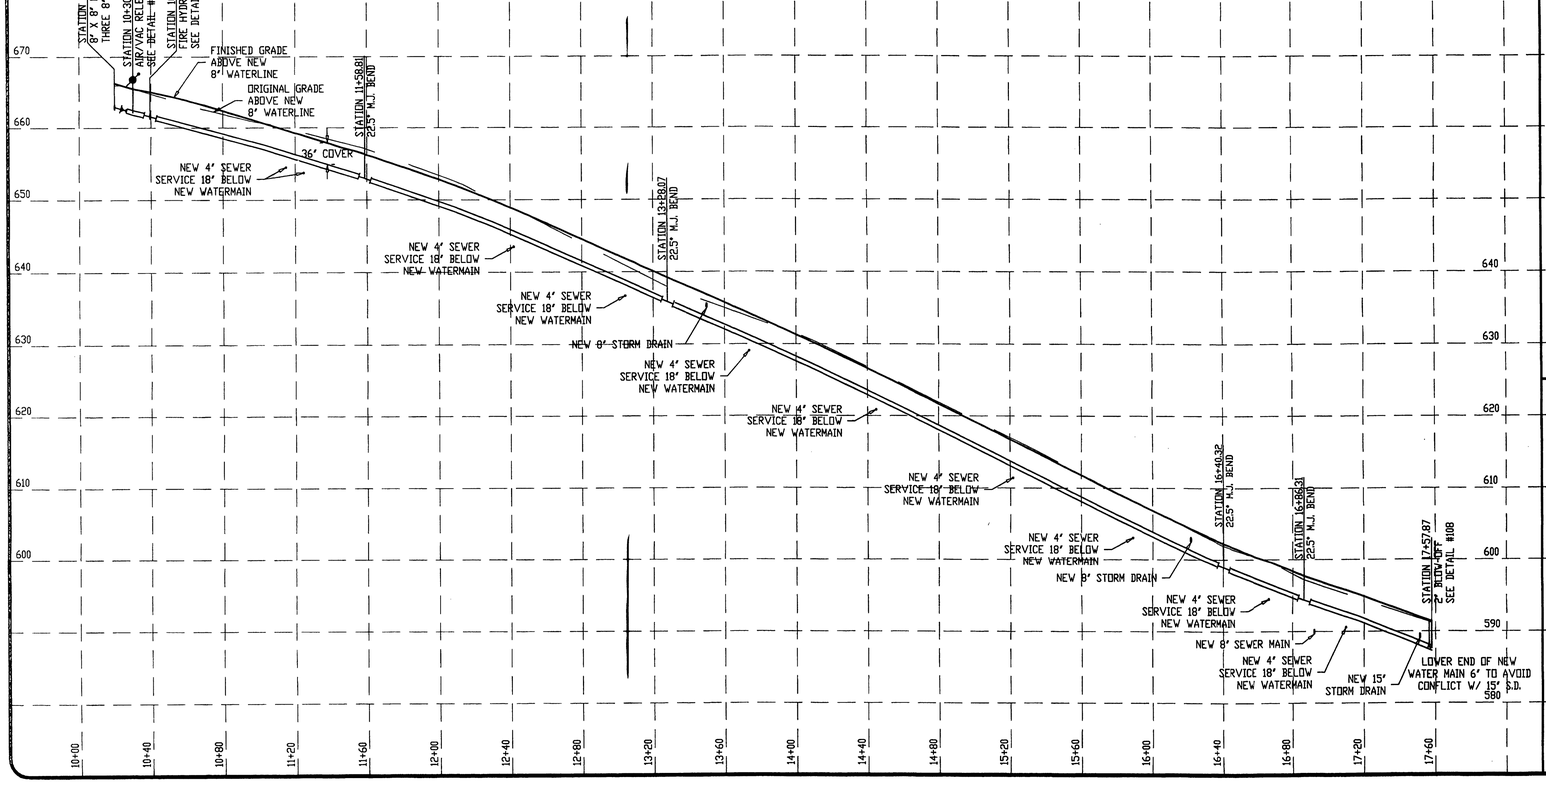

MAINLINE "B" - PROFILE

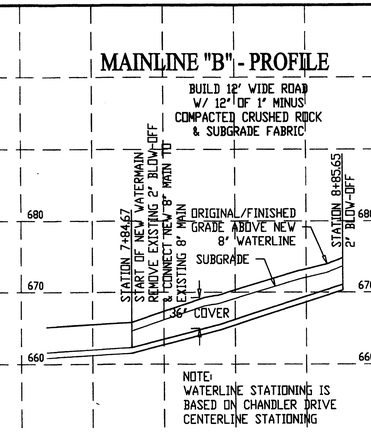

MAINLINE "C" - PROFILE

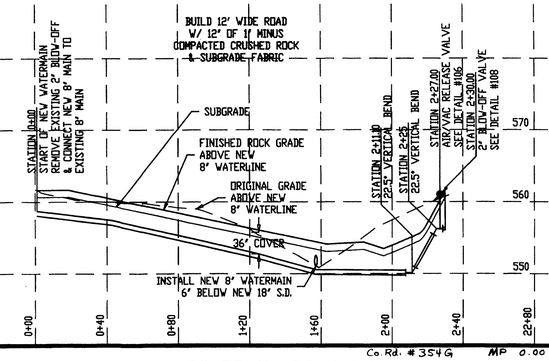

OWNER: STULL ENTERPRISES

BTS ENGINEERING & SURVEYING, INC.
411 S.E. MAIN ST., ROSEBURG, OR 97470
PHONE (541) 673-5666 FAX (541) 673-0165

SAVOY COURT SUBDIVISION

SAVOY COURT
WATERLINE PLAN

PROJECT:

SHEET TITLE:

DATE: MAY 20, 2004
REV. #1: -
REV. #2: -
REV. #3: -
REV. #4: -
REV. #5: -

REGISTERED PROFESSIONAL ENGINEER 10235 OREGON NOV. 13, 1973 DAVID G. PHILIPPI
EXPIRATION DATE: 12/31/04

PROJ. # 04-011

SHEET NO.
5 of 9

354GWATR

Co. Rd. # 354G MP 0.00 - 0.14

CO. RD. No. 354G SAVOY CT. WATERLINE PLAN