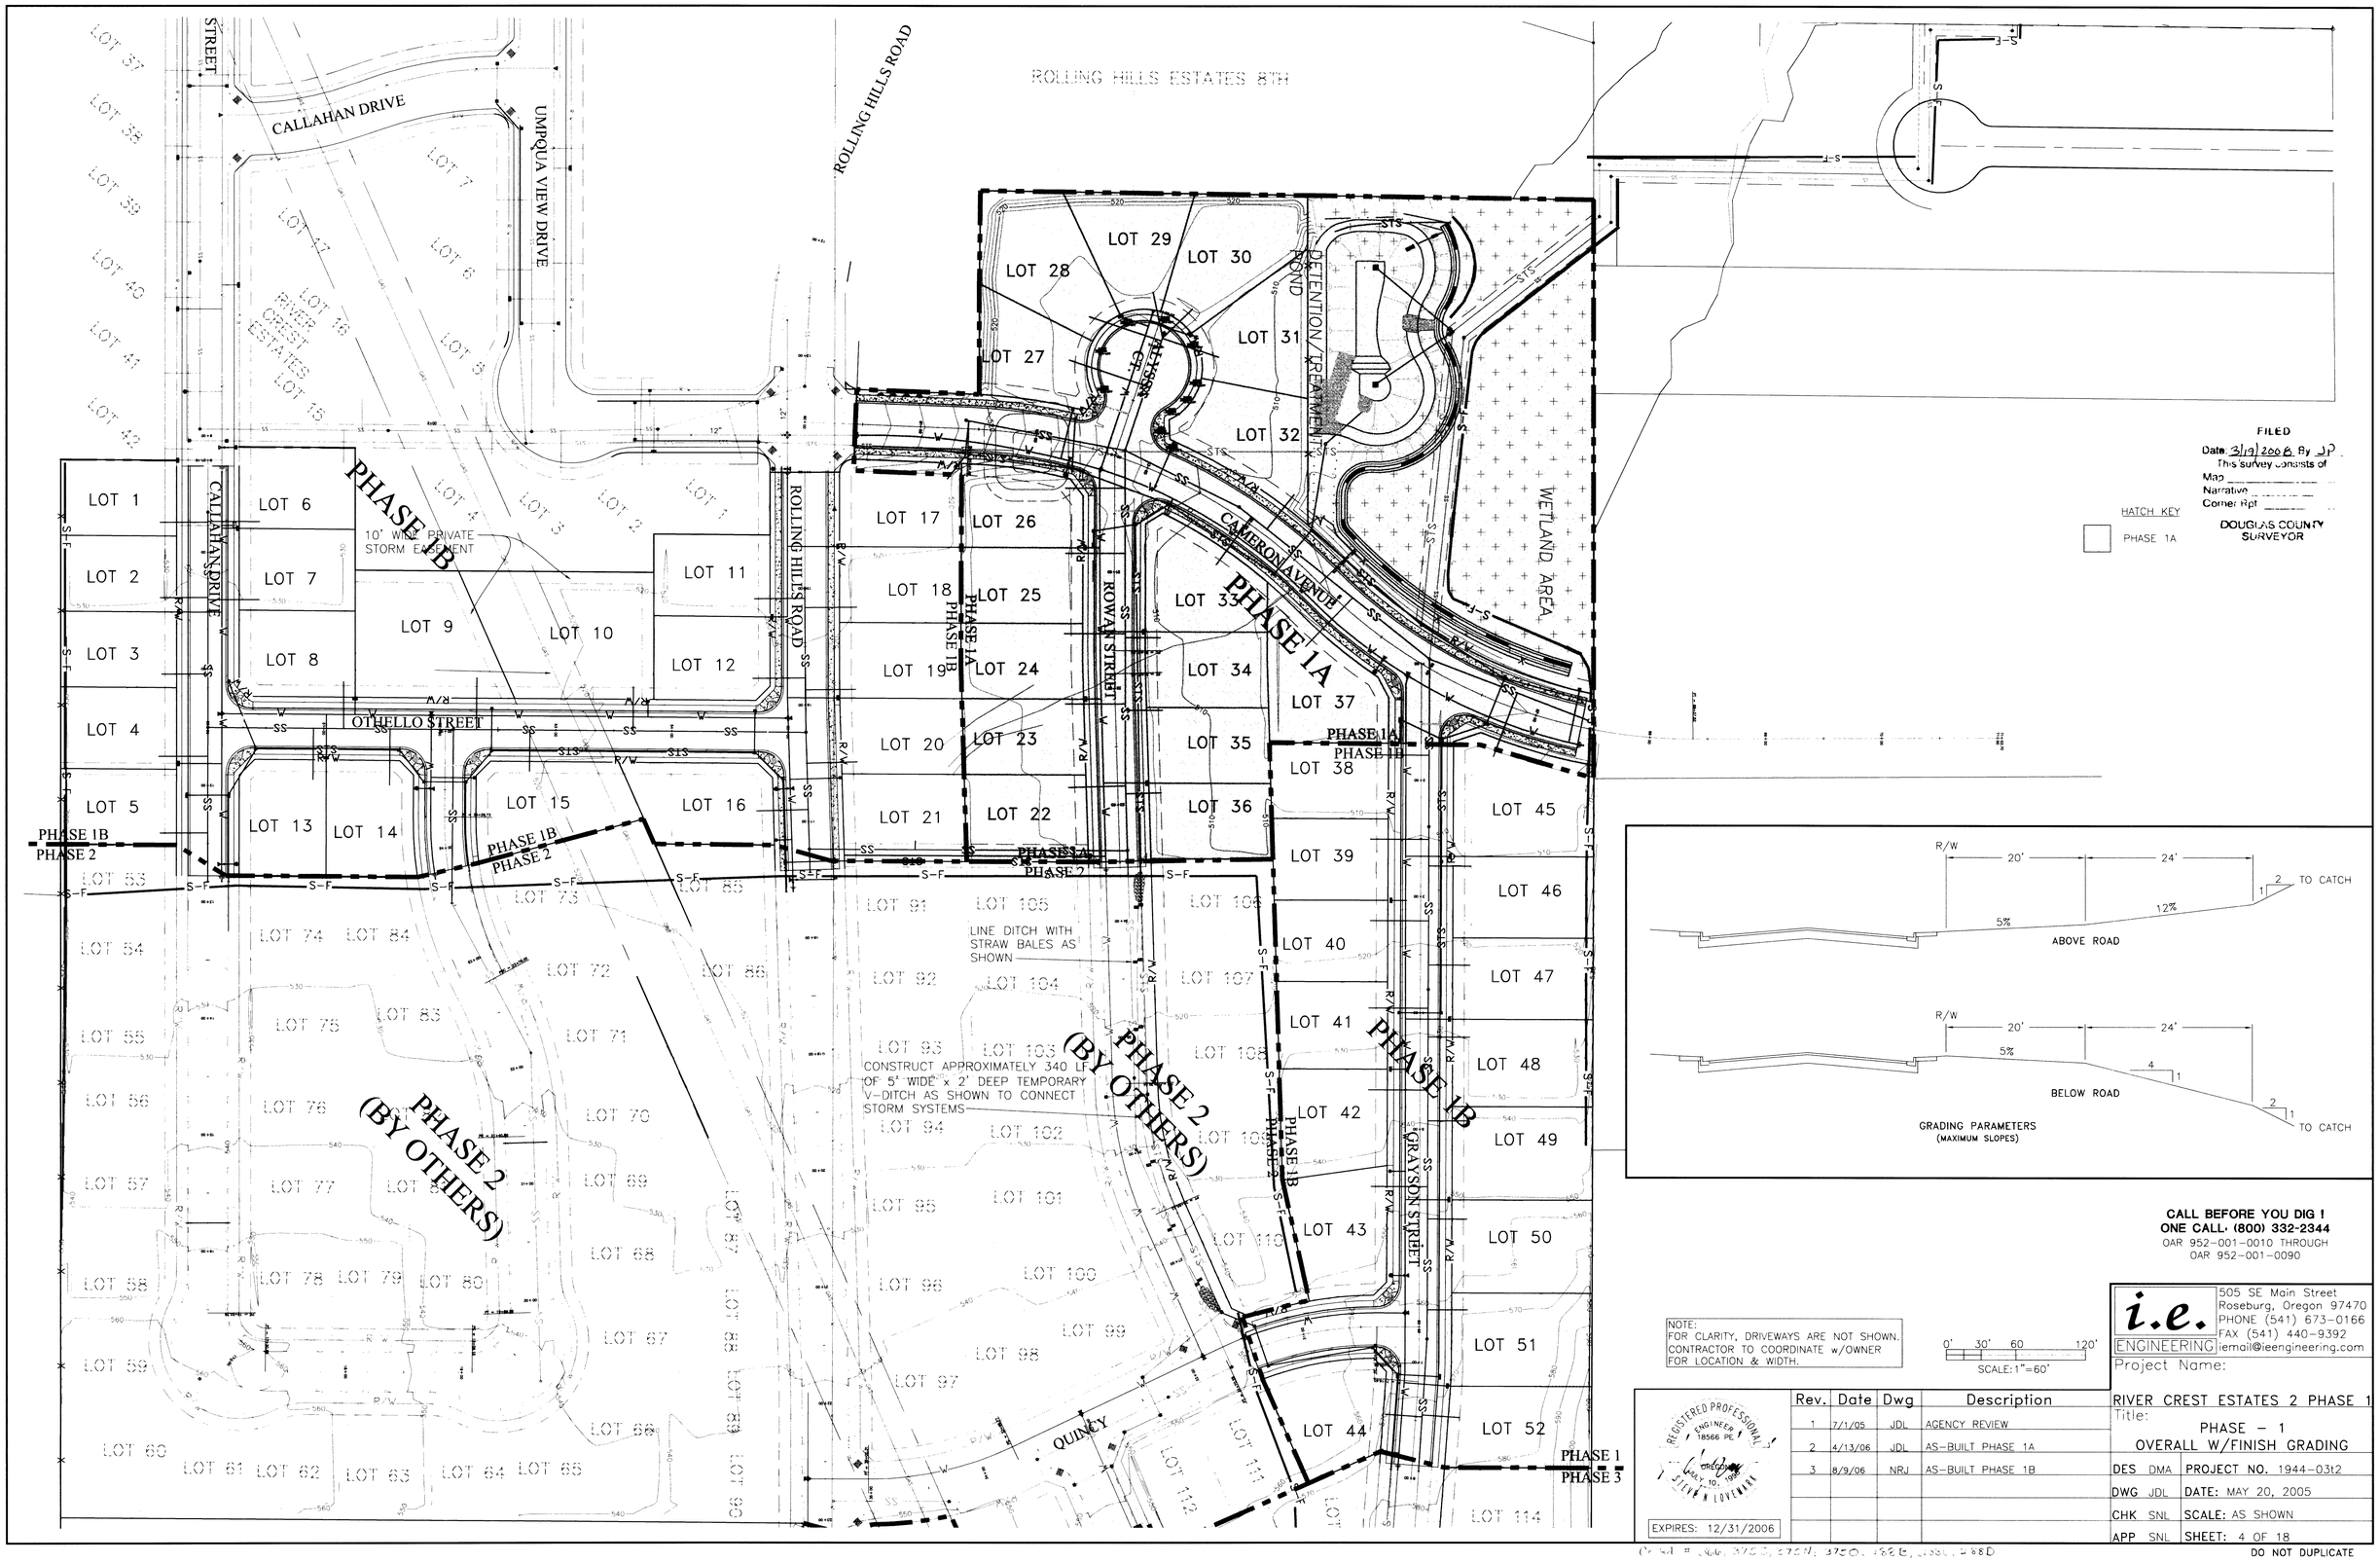

Rev.	Date	Dwg	Description
1	7/1/05	JDL	AGENCY REVIEW
2	4/13/06	JDL	AS-BUILT PHASE 1A
3	8/9/06	NRJ	AS-BUILT PHASE 1B

Crews # 366, 375J, 375N, 375O, 288B, 288C, 288D

FINISH GRADING CO. RDS. 366 375J
375N 3750 288B 288C 288D