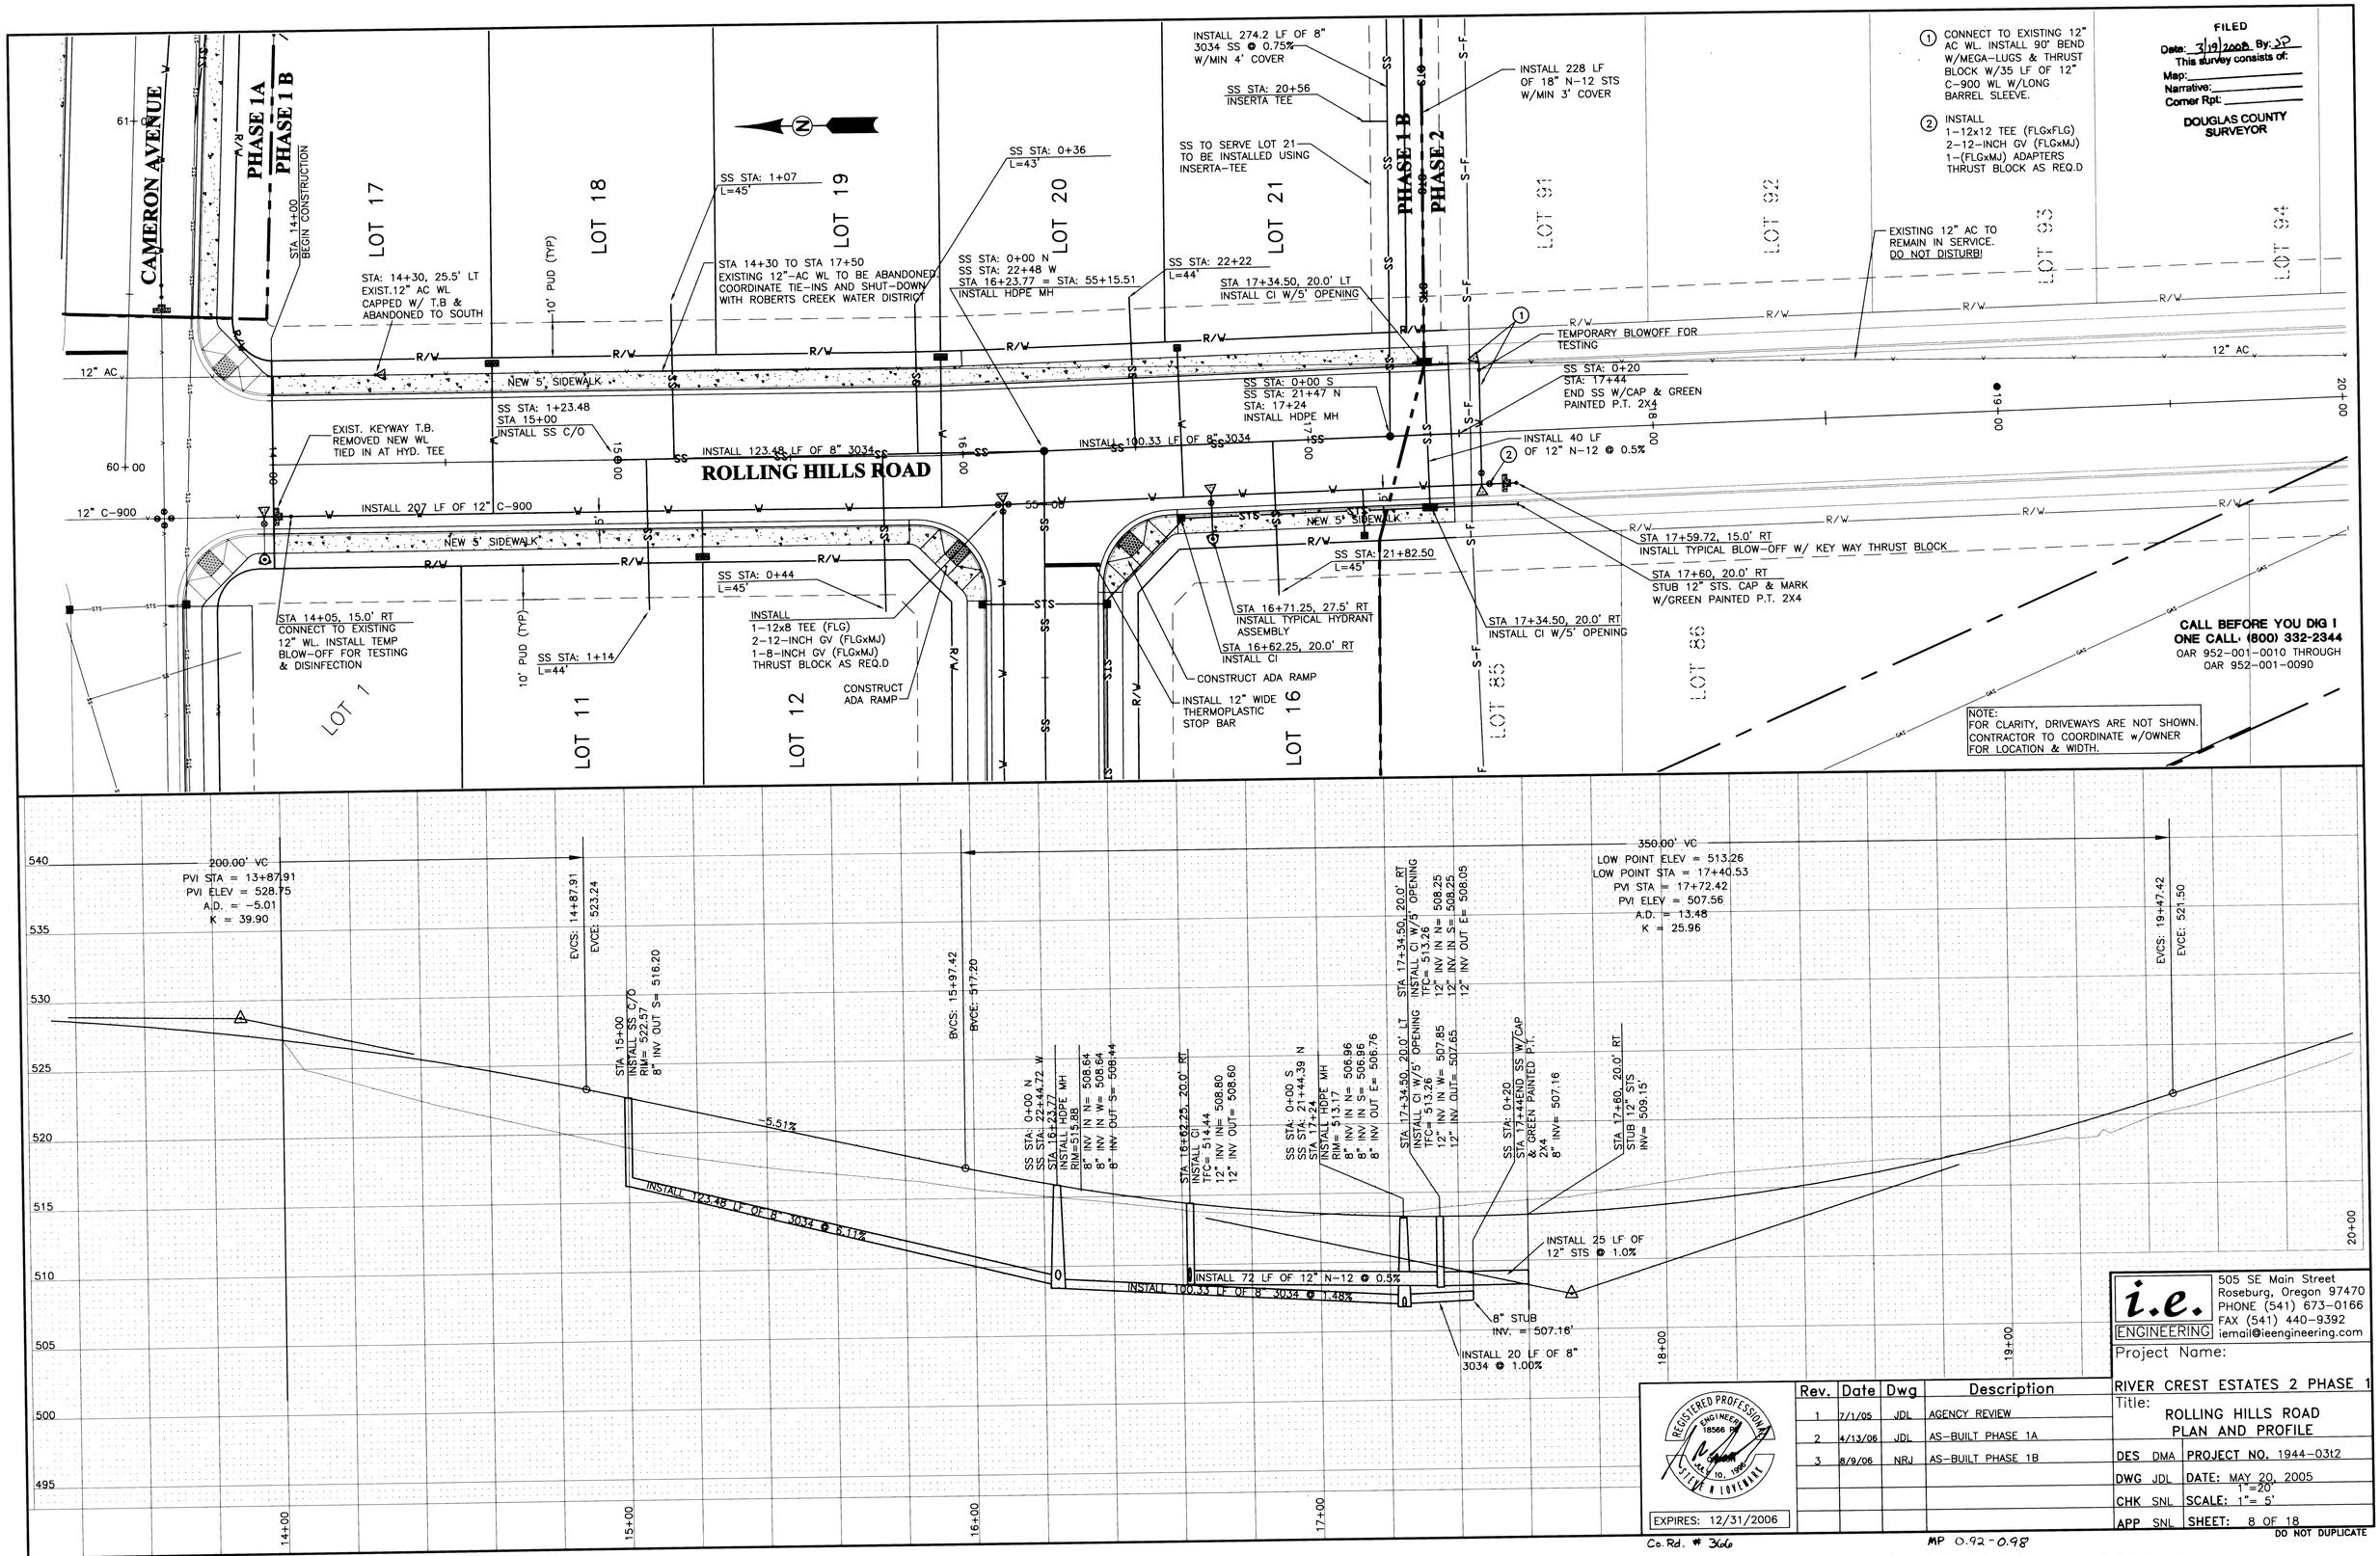

FILED
Date: 3/19/2008 By: JP
This survey consists of:
Map:
Narrative:
Corner Rpt:
DOUGLAS COUNTY SURVEYOR

REGISTERED PROFESSIONAL ENGINEER 18566 PE
OREGON JULY 10, 1986
STEVE N. LOVEMARK
EXPIRES: 12/31/2006

Rev.	Date	Dwg	Description
1	7/1/05	JDL	AGENCY REVIEW
2	4/13/06	JDL	AS-BUILT PHASE 1A
3	8/9/06	NRJ	AS-BUILT PHASE 1B

i.e. ENGINEERING
505 SE Main Street
Roseburg, Oregon 97470
PHONE (541) 673-0166
FAX (541) 440-9392
iemail@ieengineering.com

Project Name:
RIVER CREST ESTATES 2 PHASE 1
Title:
ROLLING HILLS ROAD
PLAN AND PROFILE

DES DMA | PROJECT NO. 1944-03t2
DWG JDL | DATE: MAY 20, 2005
CHK SNL | SCALE: 1"=20' 1"= 5'
APP SNL | SHEET: 8 OF 18

DO NOT DUPLICATE

R3660092

Co. Rd. # 366

MP 0.92-0.98

CO. RD. 366 PLAN & PROFILE