
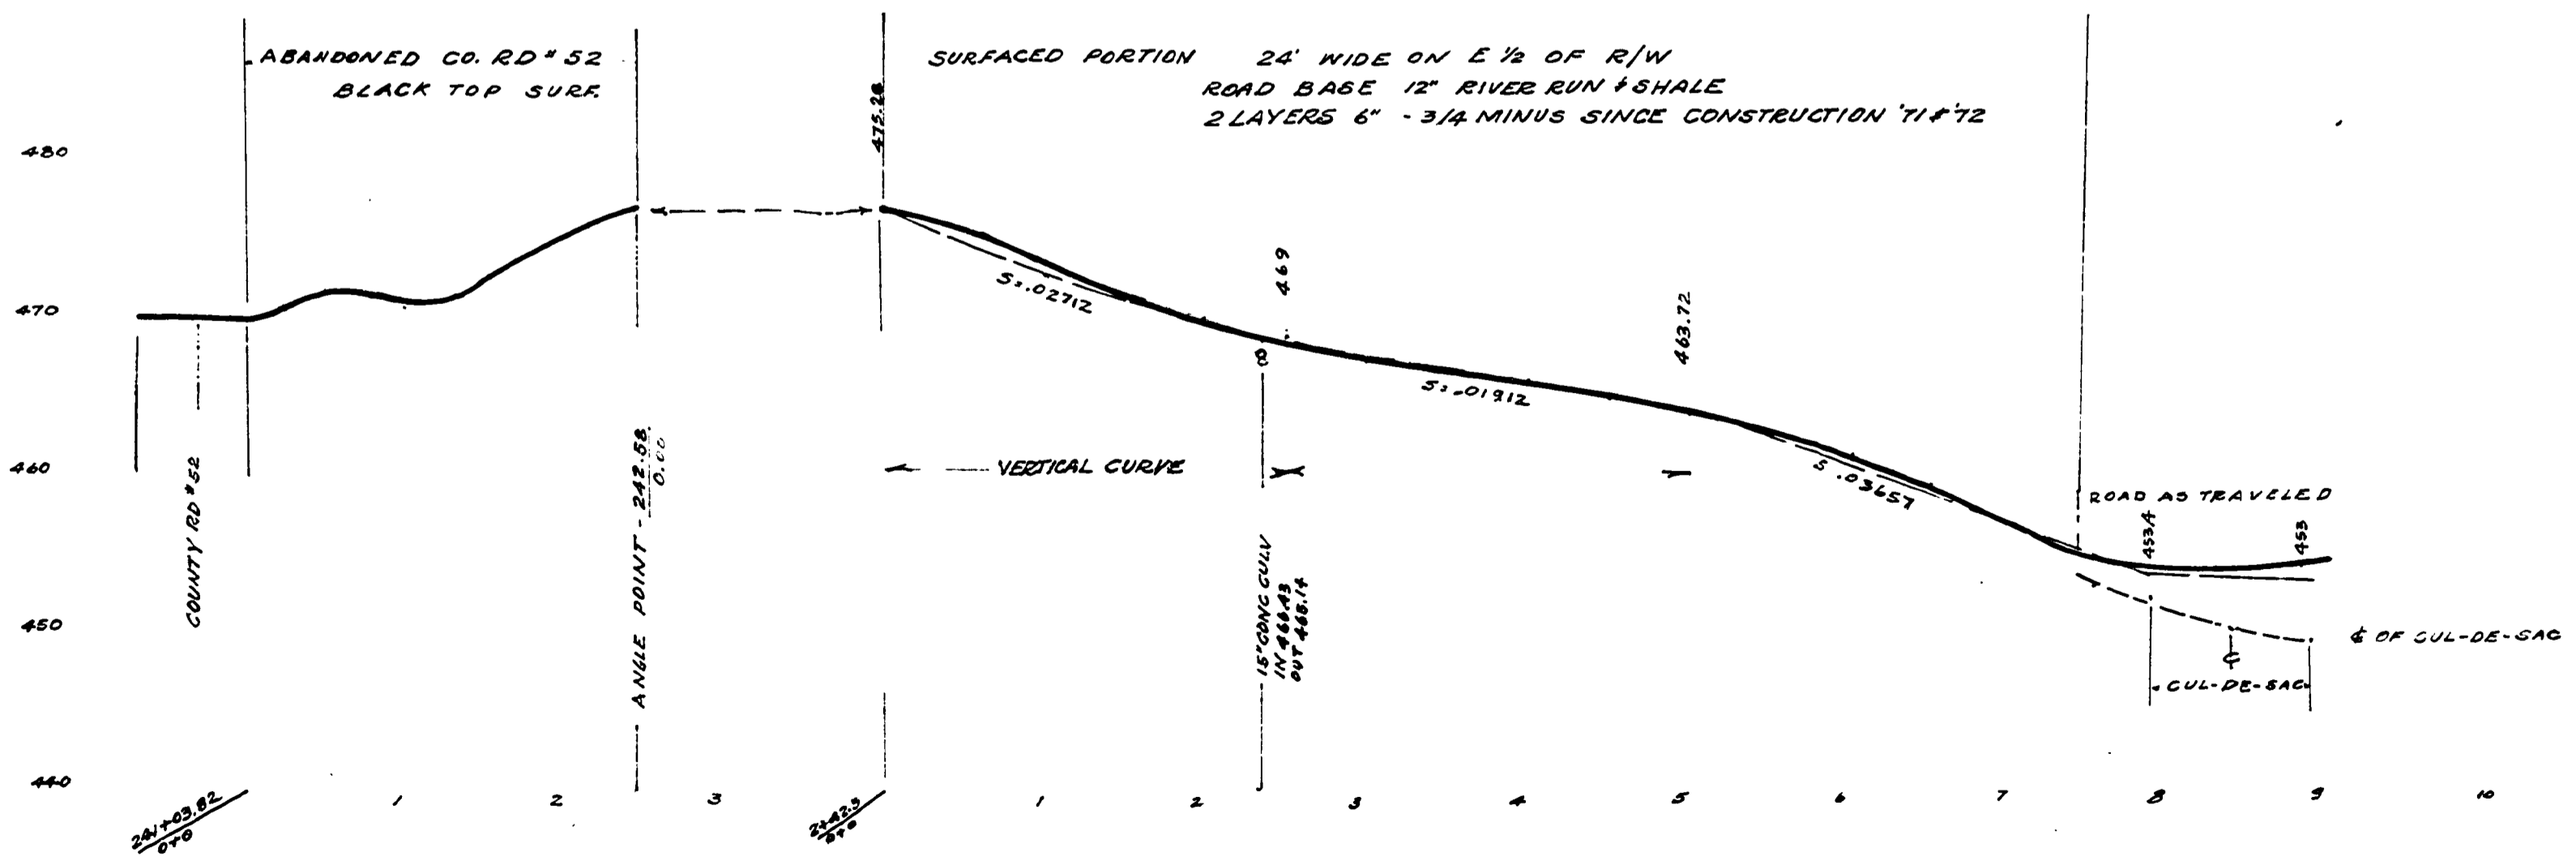
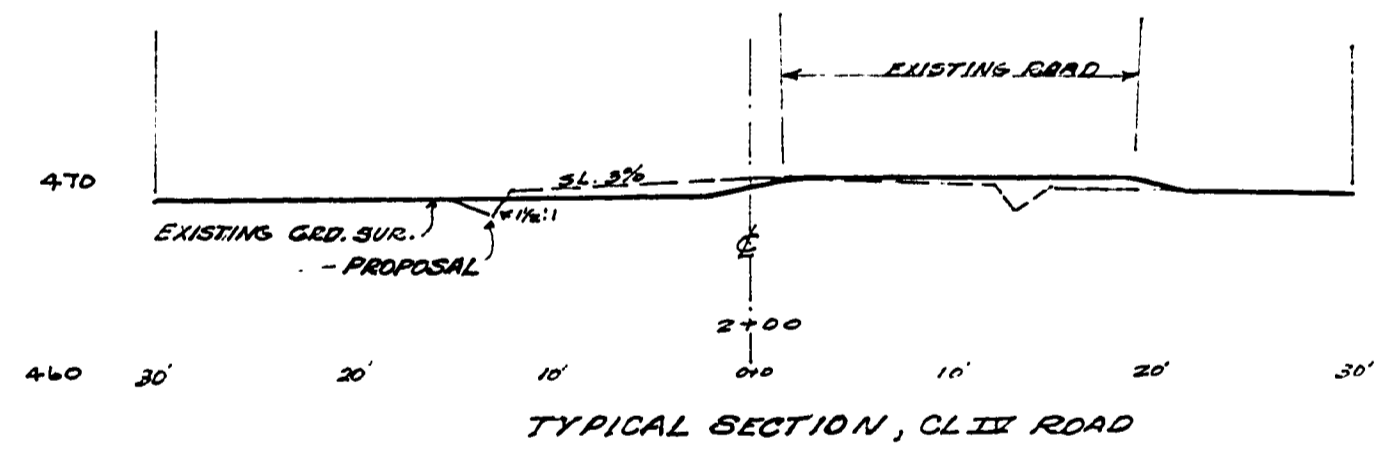


CHAMPAGNE ACRES-DEDICATED ROAD  
 A SUBDIVISION IN SEC. 12, T. 27 S., R. 7 W., WM.,  
 DOUGLAS CO. ORE.

1" = 100 HORIZ.  
 1" = 10' VERT. 72 & 73

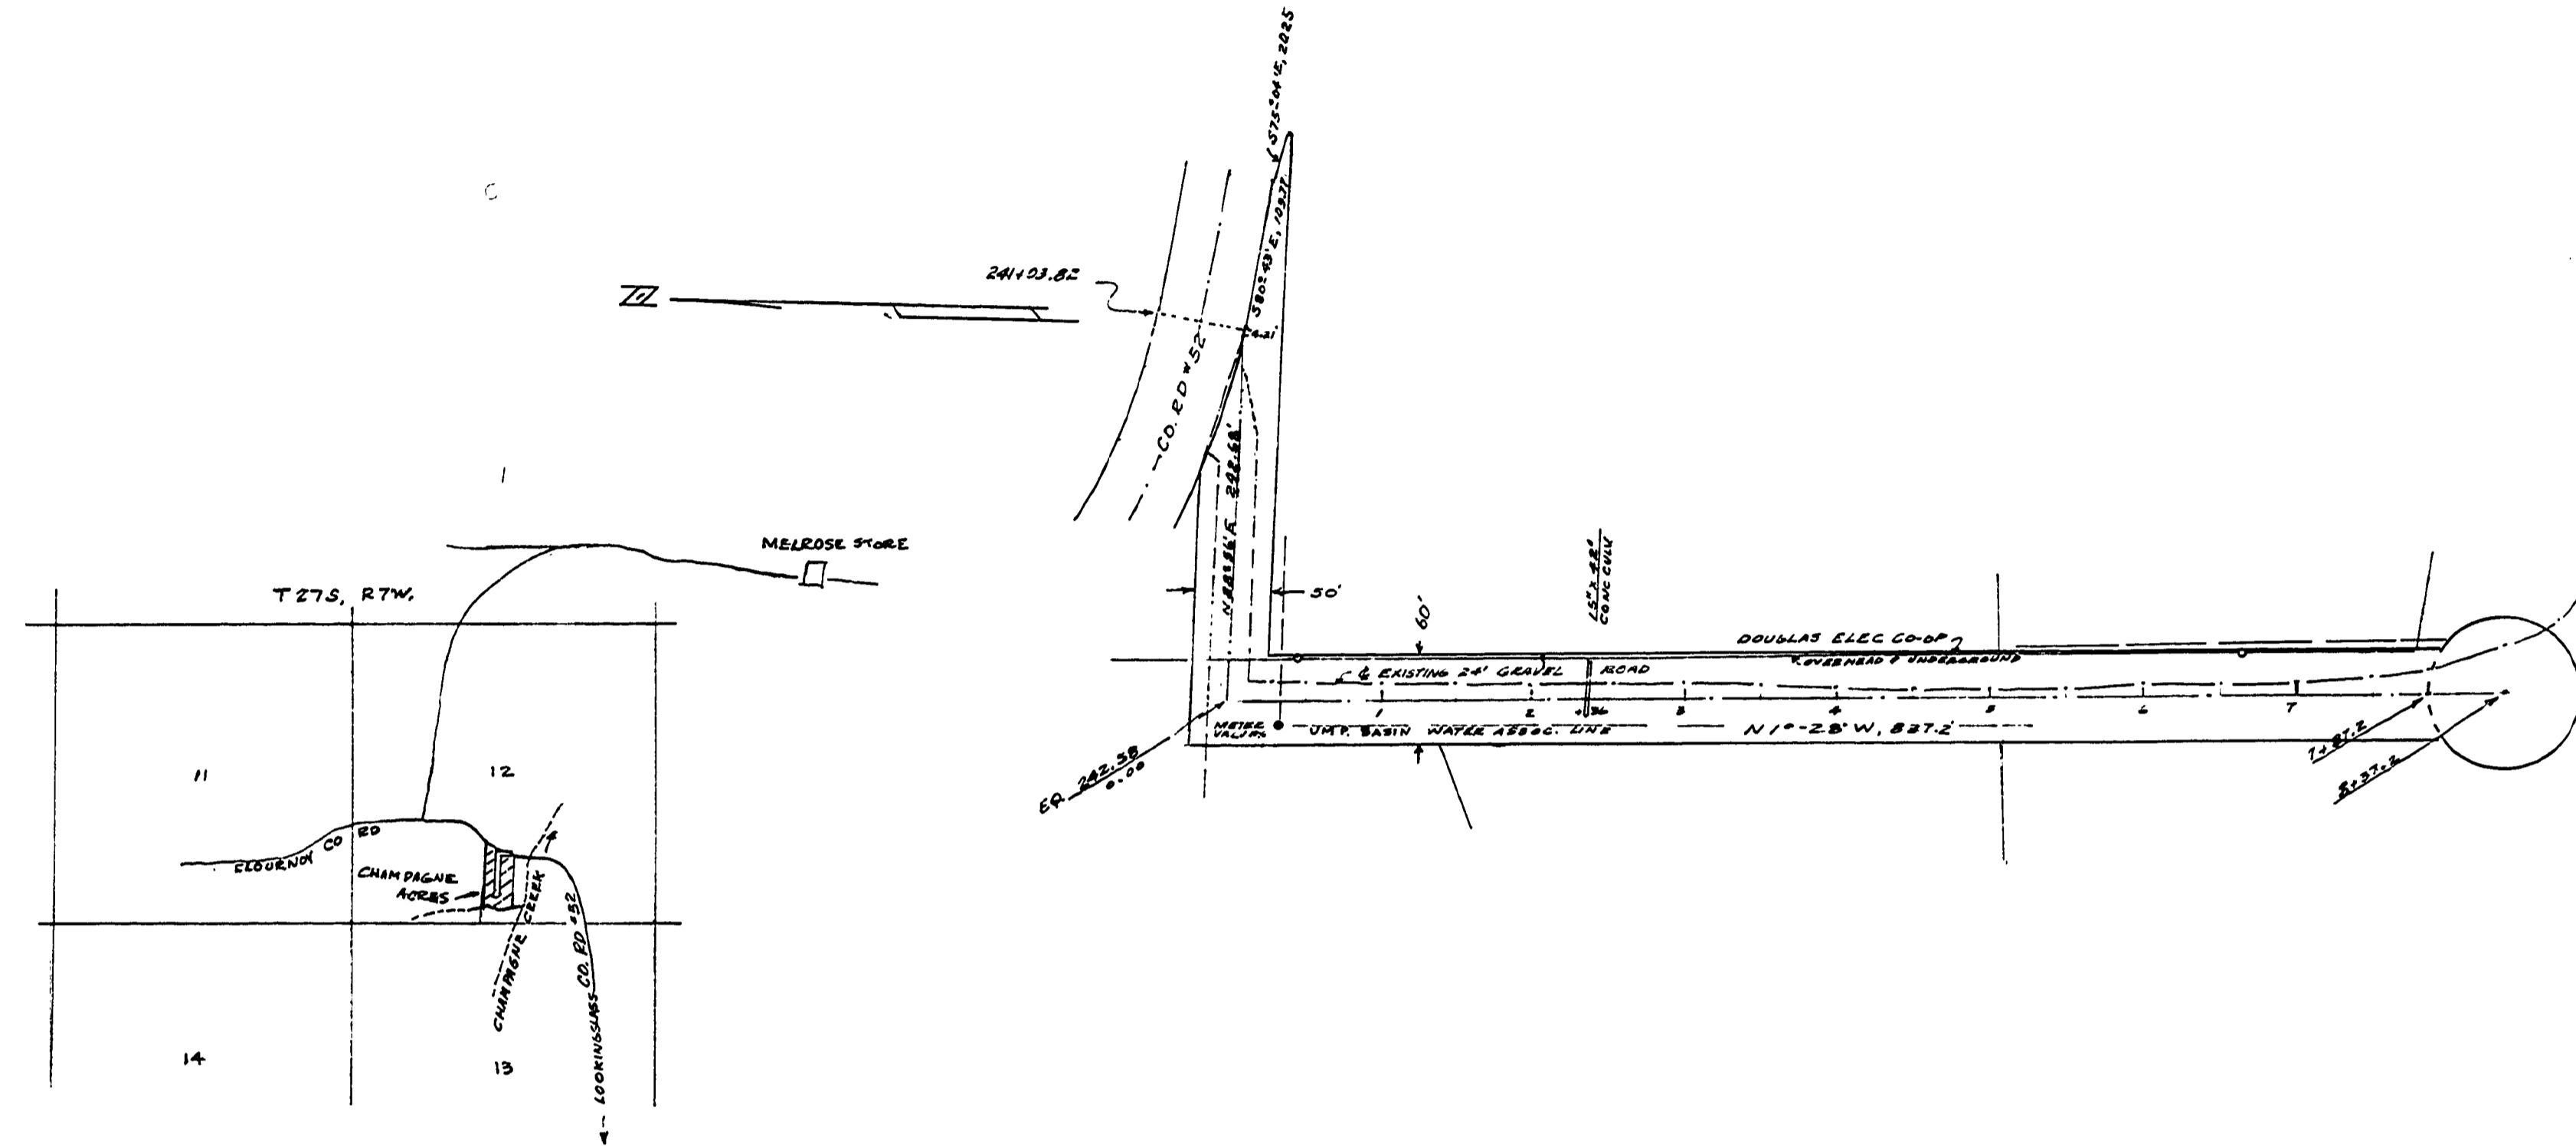

REGISTERED  
 PROFESSIONAL  
 LAND SURVEYOR

Herbert L. Northcraft

OFFICE  
 HERBERT L. NORTHCRAFT  
 750

CHAMPAGNE ACRES  
 DEDICATED ROAD 50'x60'  
 SEC. 12, T. 27 S., R. 7 W., DOUG. CO.  
 DEDICATORS MARY SIBBEL KLEBPALD  
 DEC. 73 H.L. NORTHCRAFT L.S. 1051

CHAMPAGNE COURT  
 Co. RD. # 368

ROAD 0368