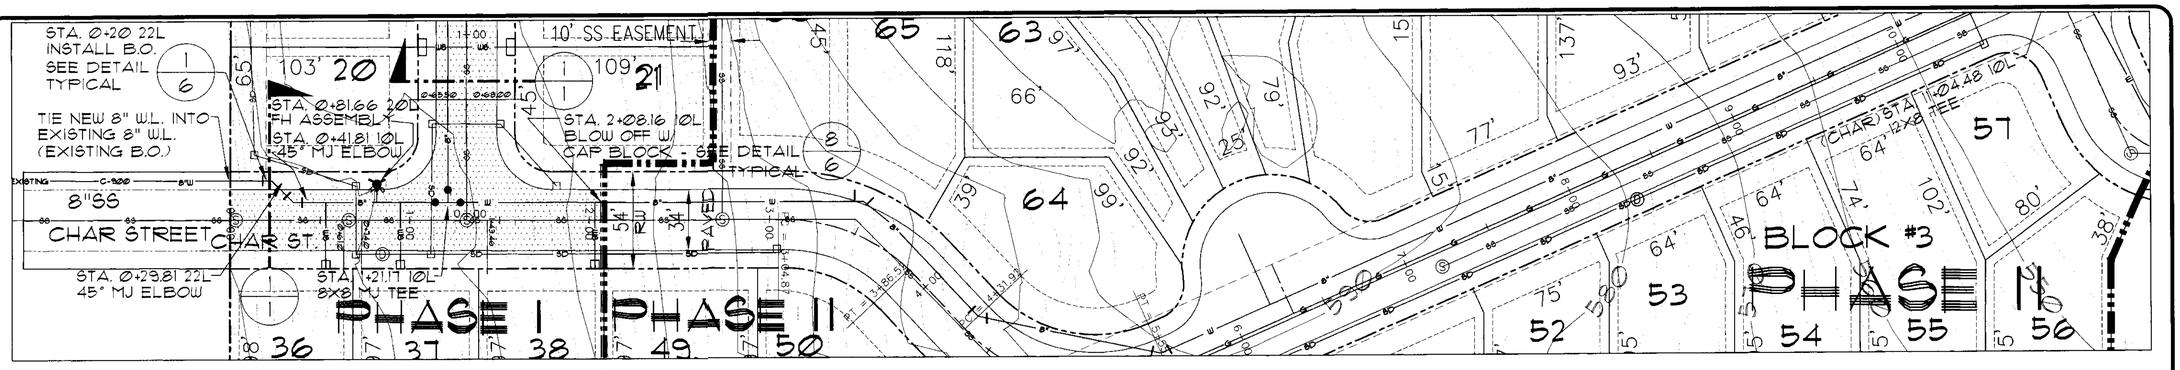

CHAR STREET-PLAN

SCALE:1"=40'

FILED

Date: 5/16/2001 By: JP

This survey consists of:

Map: _____

Narrative: _____

Corner Rpt: _____

DOUGLAS COUNTY SURVEYOR

PHASE I

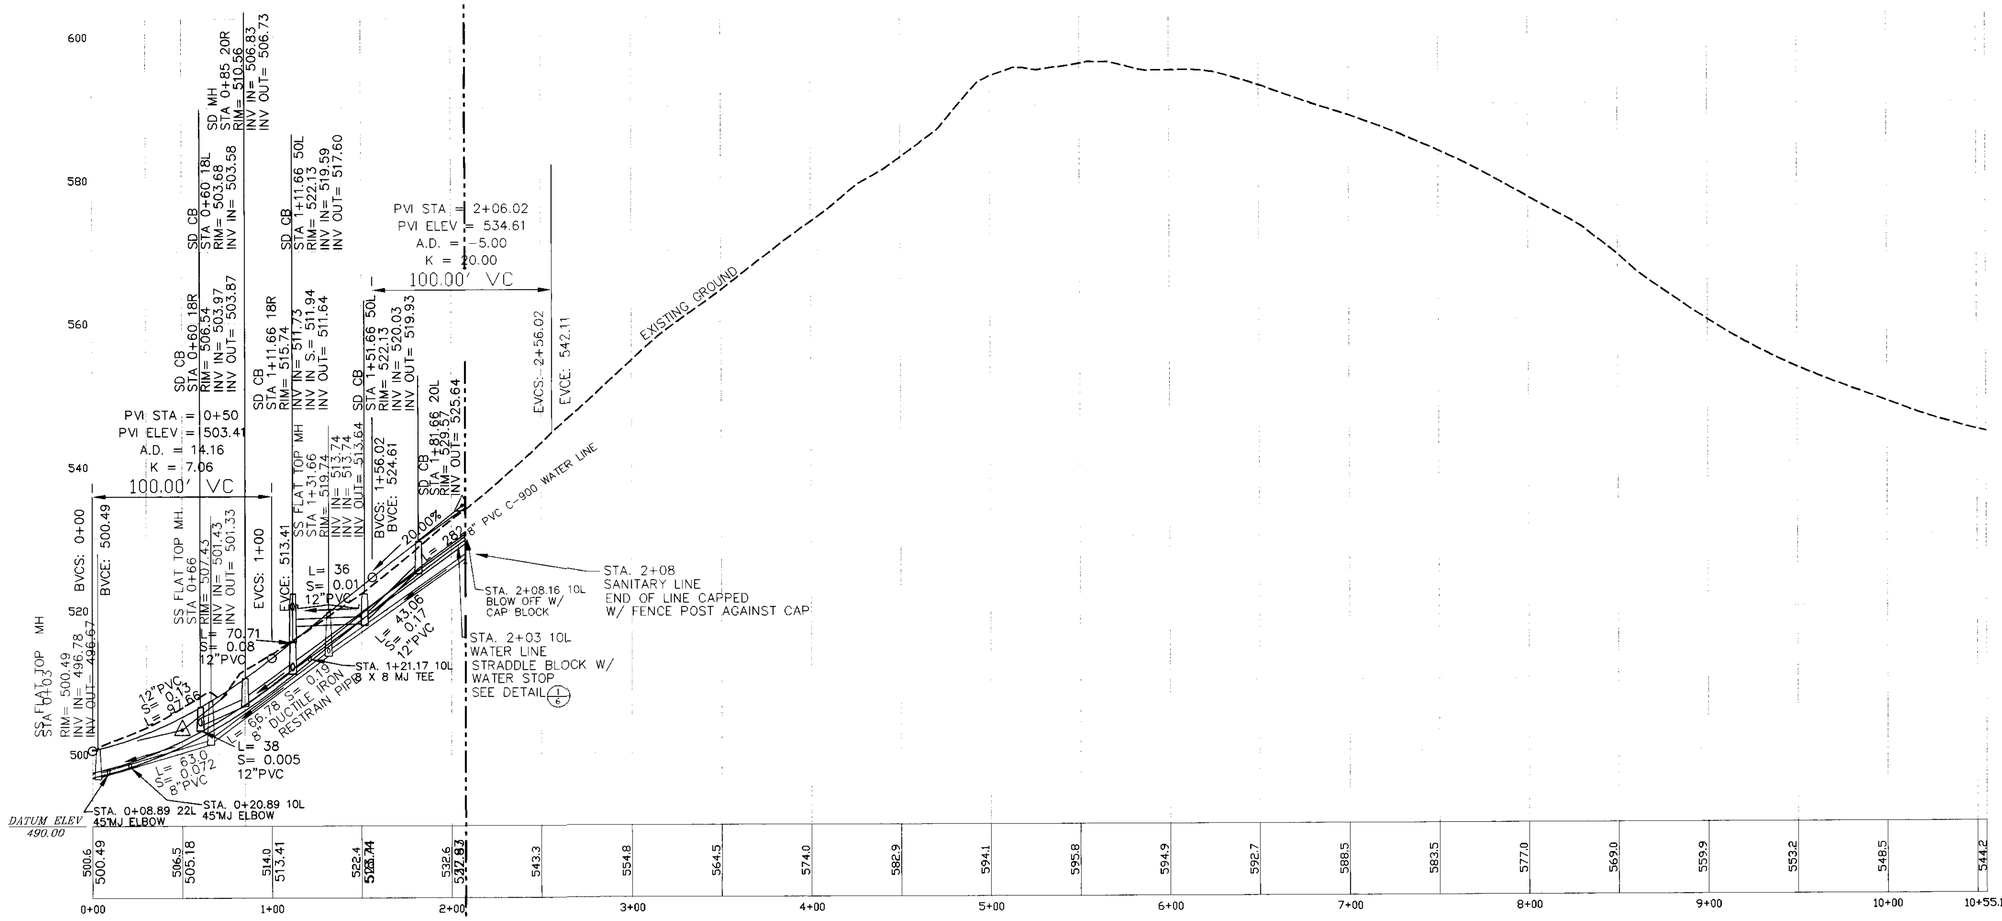

CHAR STREET-PROFILE

SCALE:
HORIZ:1"=40'
VERT:1"=10'

RECORD DRAWING

THIS DRAWING IS AN APPROXIMATE REPRESENTATION OF THE RECORDED "AS-BUILT" CONDITIONS. THIS INFORMATION IS ONLY A GRAPHIC REPRESENTATION. EXISTING CONDITIONS SHOULD BE VERIFIED PRIOR TO ANY WORK OR CONSTRUCTION ON OR IN RELATION TO THE INFORMATION SHOWN ON THESE PLANS.

DRAWN BY: D.B. DATE: 2/19/01

CONTRACTOR: ROSEBURG PAVING

D:\Land Projects R2\Burdette 99-049\dwg\Phase I as-builts\99049-02pl_PS.dwg 02/22/2001 01:13:09 PM PST

REVISIONS	
STORM DRAIN	8/23/99
REVISED WATERLINE PER R.C.W.D.	10/5/99
REVISED WATER AND SANITARY	10/15/99
REVISED CHAR ALIGNMENT	2/24/00
REVISED PER "AS-BUILT" MARKUPS	2/19/01

T.J. BOSSARD, INC.
Civil & Structural Engineering
133 N.W. "D" Street
Grants Pass, OR. 97526
TEL. : (541) 479-5774
FAX : (541) 471-6084

REGISTERED PROFESSIONAL ENGINEER — TIMOTHY JAY BOSSARD — JULY 22, 1991 — EXPIRES 12-31-99

RIVER VIEW SUBDIVISION

CHAR STREET

PLAN AND PROFILE

THE BURDETTE LOVING TRUST
280 EAST DELMAR AVENUE #339
PASADENA, CALIFORNIA 91101

DRAWN BY : L.W.	
CHECKED BY :	
DATE : 8/23/99	
SCALE : AS SHOWN	
CADDFILE: 99049-02_PS	
JOB NO. : 99-049	
SHEET 2	OF 10

00420045

Co. Rd. 375A MP 0.42-0.45

CO. RD. # 375A, PLAN & PROFILE