FILED

Date: 11-22-96 By: JP

This survey consists of:

Map: _____

Narrative: _____

Corner Rpt: _____

DOUGLAS COUNTY SURVEYOR

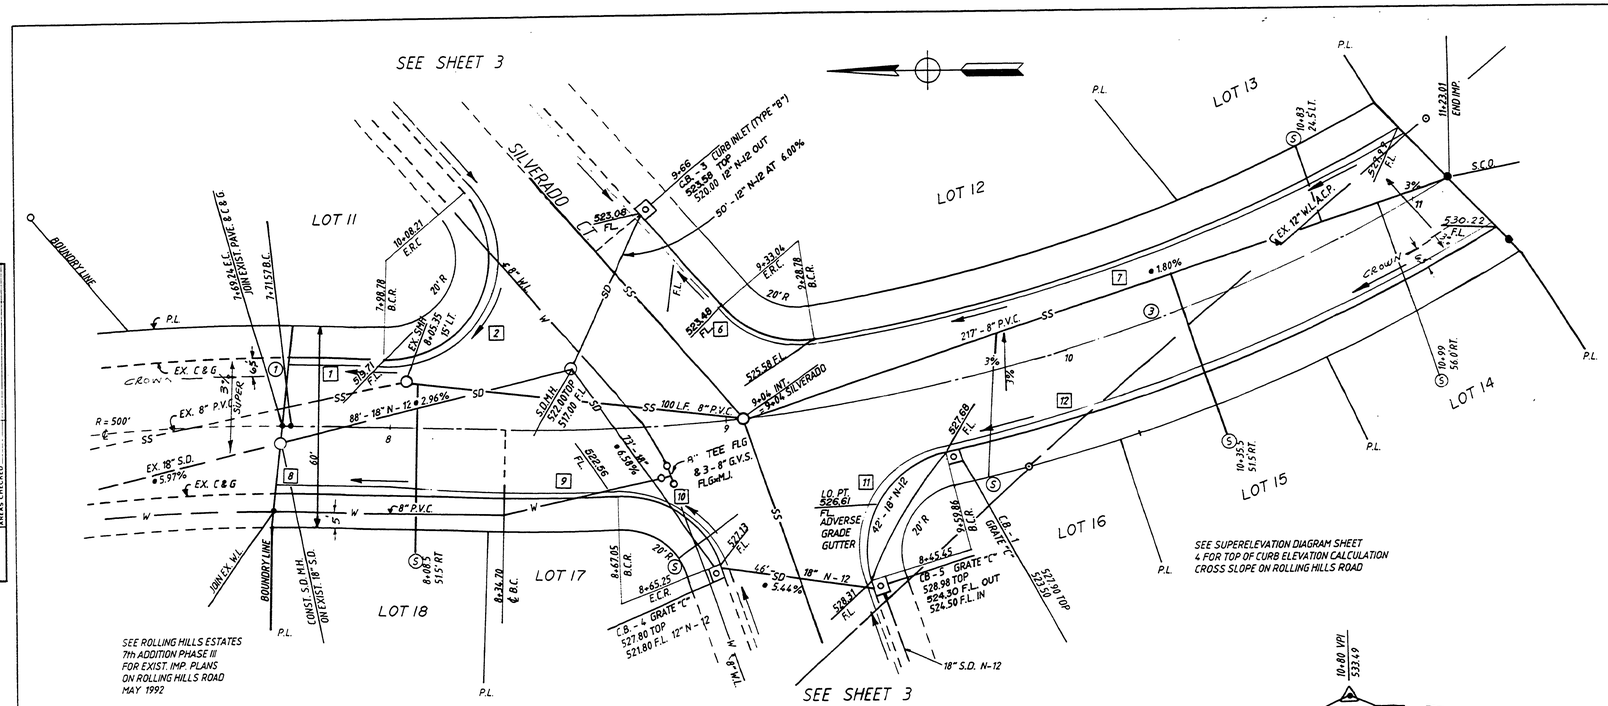

ROLLING HILL ROAD PLAN

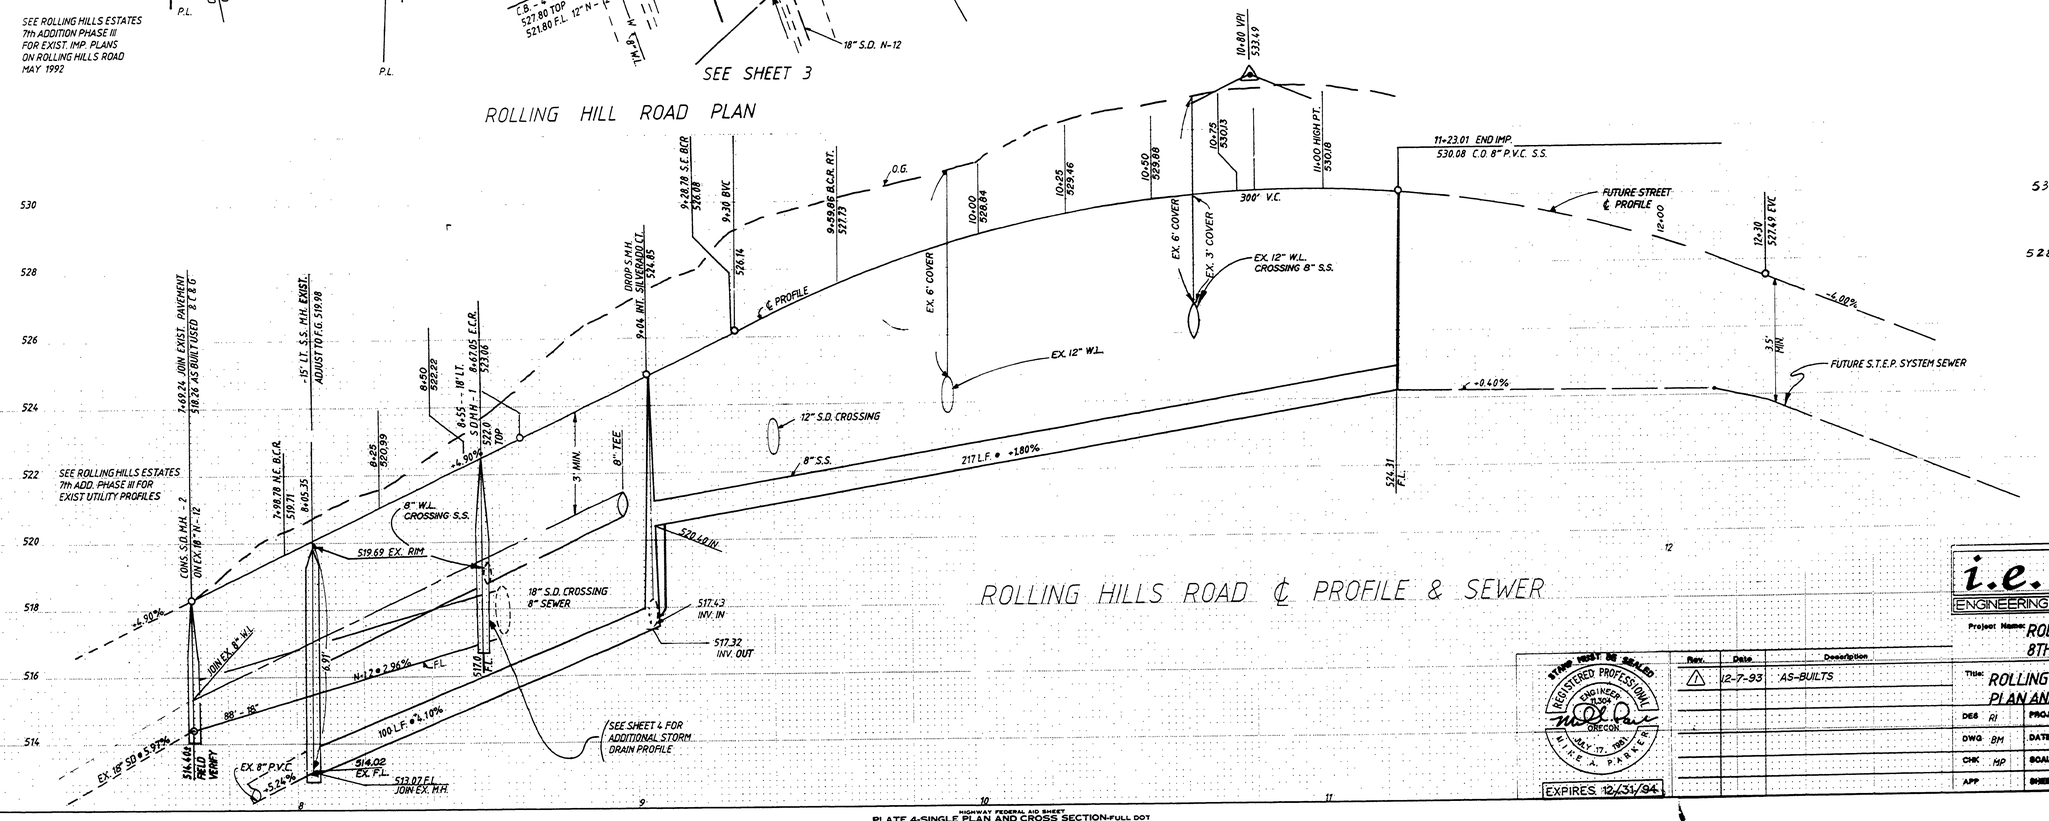

ROLLING HILLS ROAD ℄ PROFILE & SEWER

CENTERLINE CURVE DATA

	DELTA	R	L
1.	0° 16' 04"	499.06	2.33'
2.	7° 56' 29"	500.00	69.30'
3.	25° 05' 45"	500.00	219.00'

CURB CURVE DATA

1.	0° 05' 09"	519.06	0.78'
2.	132° 25' 56"	30.00	69.34'
6.	58° 20' 56"	30.00	30.55'
7.	21° 44' 23"	480.00	182.13'
8.	0° 27' 54"	479.06	3.89'
9.	3° 42' 24"	520.00	33.64'
10	73° 29' 04"	30.00	38.48'
11	95° 52' 52"	30.00	50.20'
12	19° 10' 18"	520.00	174.00'

FINAL SURVEY — SURVEYED / PLOTTED / TEMPLATE / AREAS / AREAS CHECKED — NOTE BOOK NO. — BY — DATE

ORIGINAL SURVEY — SURVEYED / PLOTTED / TEMPLATE / AREAS / AREAS CHECKED — NOTE BOOK NO. — BY — DATE

RD0375F2

i.e. ENGINEERING
1205 S.E. Court Street
Roseburg, Oregon 97470
PHONE (503) 673-0366
FAX (503) 440-9392

STAMP MUST BE SEALED — REGISTERED PROFESSIONAL ENGINEER — OREGON — JULY 17, 1981 — MIKE A. PARKER

EXPIRES 12/31/94

Rev.	Date	Description
1	12-7-93	AS-BUILTS

Project Name: ROLLING HILLS ESTATES 8TH ADDITION

Title: ROLLING HILLS ROAD PLAN AND PROFILE

DES	RI	PROJECT NO.	108-08
DWG	BM	DATE	JUNE 1993
CHK	MP	SCALE	1" = 20' H. 1" = 2' V
APP		SHEET	2 OF 4

HIGHWAY FEDERAL AID SHEET
PLATE 4-SINGLE PLAN AND CROSS SECTION-FULL DOT
3M TELEDYNE
PRINTED IN U.S.A.

CO. RD. NO. 375-F

40