FILED
Date: 11-22-94 By: JP
This survey consists of:
Map:
Narrative:
Corner Rpt:
DOUGLAS COUNTY SURVEYOR

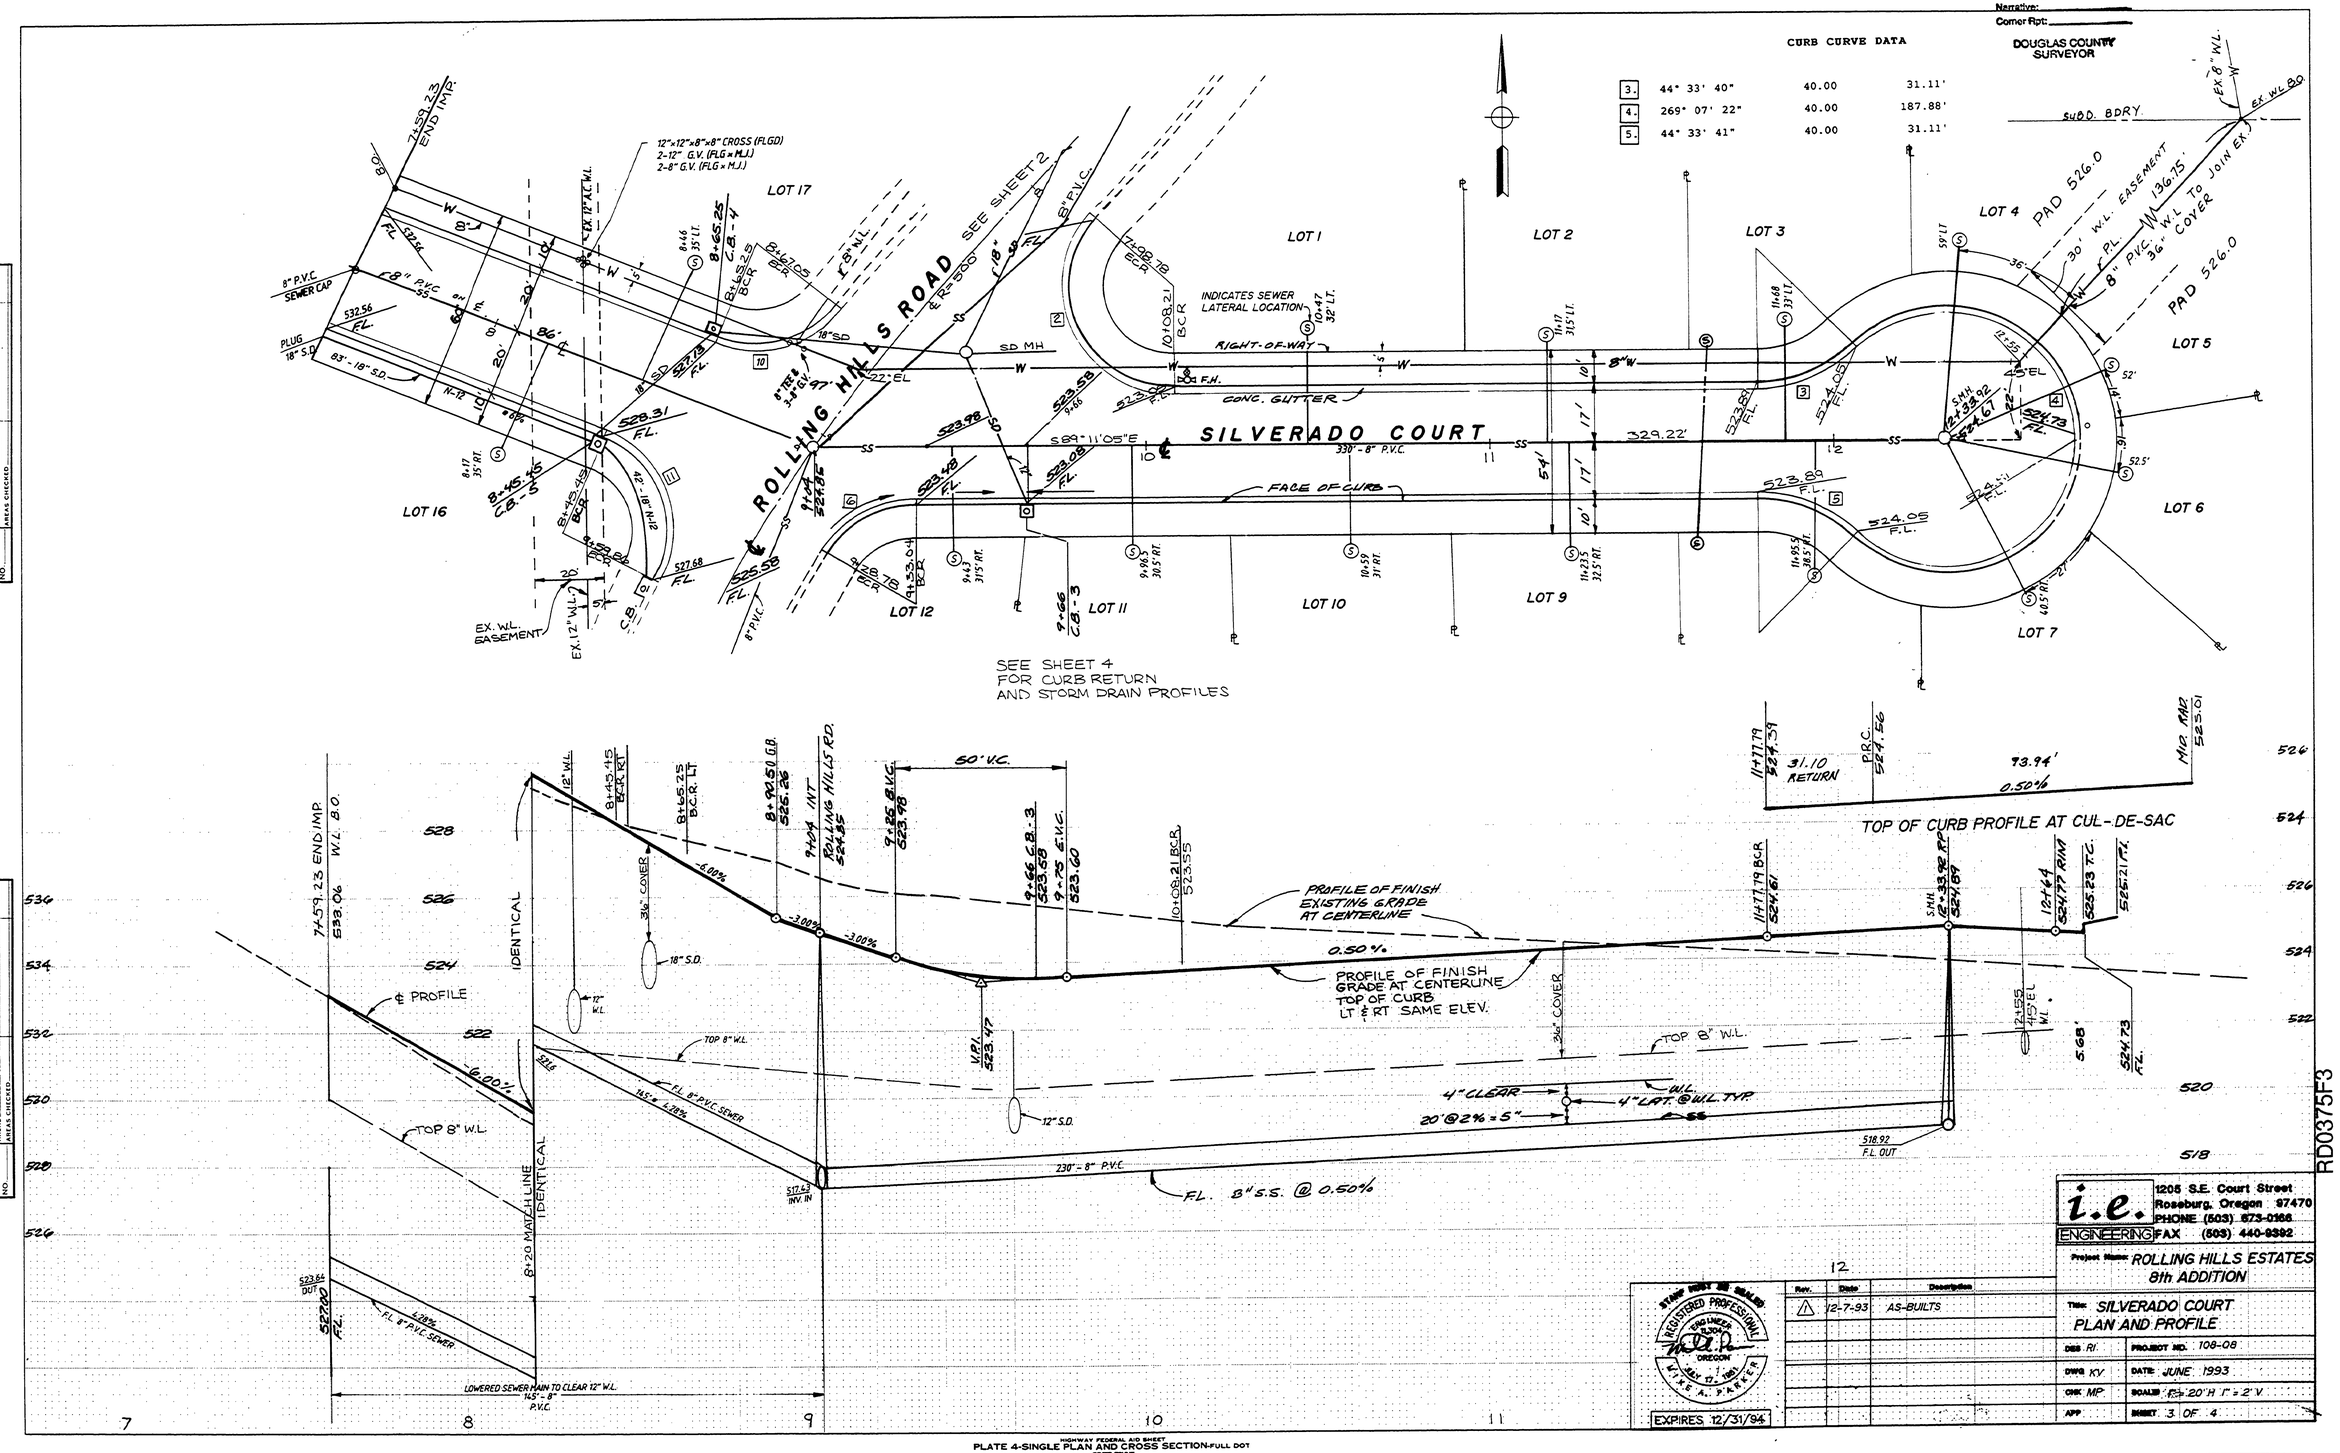

PLATE 4-SINGLE PLAN AND CROSS SECTION-FULL DOT
HIGHWAY FEDERAL AID SHEET
TELEDYNE
PRINTED IN U.S.A.

CO. RD. NO. 375-F

41