FILED
Date: 11-22-96 By: JP
This survey consists of:
Map:
Narrative:
Corner Rpt:
DOUGLAS COUNTY SURVEYOR

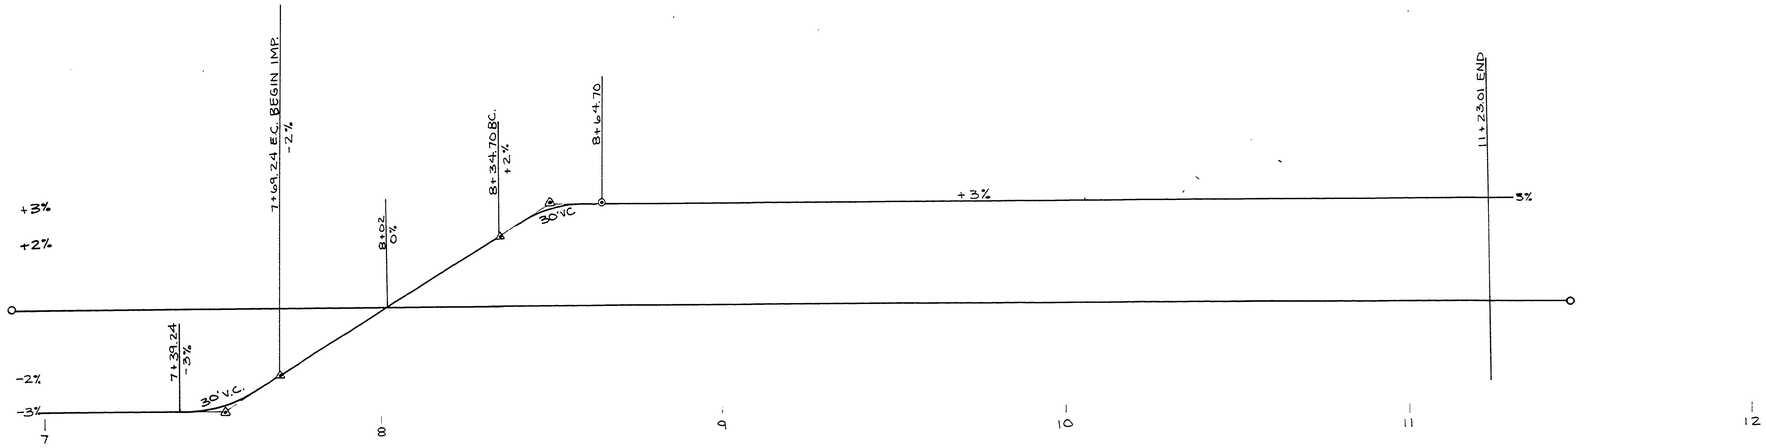


ROLLING HILLS ROAD
SUPERELEVATION DIAGRAM

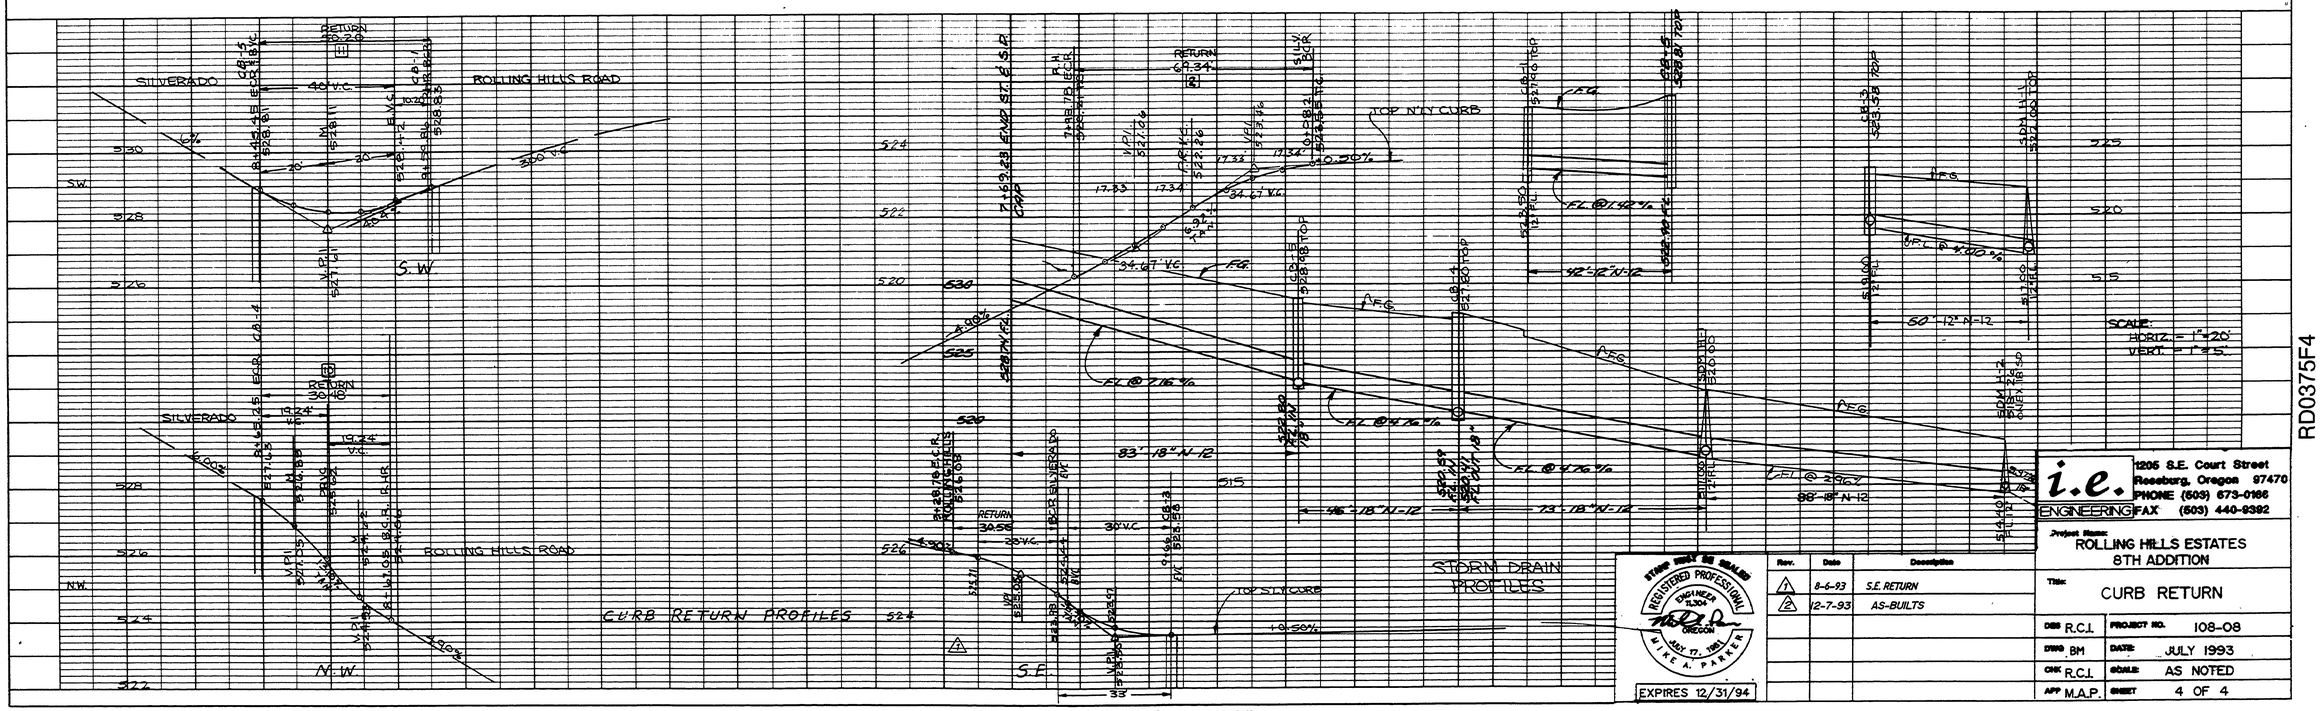


PLATE 1 PLAN-PROFILE O. P. R. & R. E. STANDARD
DIETZGEN CORPORATION
PRINTED IN U.S.A.

STAMP MUST BE SEALED
REGISTERED PROFESSIONAL ENGINEER ILLINOIS OREGON
JULY 17, 1981
MIKE A. PARKER
EXPIRES 12/31/94

| Rev. | Date | Description |
|---|---|---|
| 1 | 8-6-93 | S.E. RETURN |
| 2 | 12-7-93 | AS-BUILTS |


i.e. ENGINEERING
1205 S.E. Court Street
Roseburg, Oregon 97470
PHONE (503) 673-0166
FAX (503) 440-9392


Project Name: ROLLING HILLS ESTATES 8TH ADDITION
Title: CURB RETURN

| | | | |
|---|---|---|---|
| DES | R.C.I. | PROJECT NO. | 108-08 |
| DWG | BM | DATE | JULY 1993 |
| CHK | R.C.I. | SCALE | AS NOTED |
| APP | M.A.P. | SHEET | 4 OF 4 |

PLAN — SURVEYED / PLOTTED / ALIGNMENT CHECKED / BY AFFIDAVIT CHECKED — NOTE BOOK No. — BY — DATE

PROFILE — PLOTTED / GRADES CHECKED / B. M.'S WRITTEN / ELEVATIONS / STATIONS CHECKED — NOTE BOOK No. — BY — DATE

RD0375F4

CO. RD. NO. 375-F

42