STA 1+00 12'LT
INSTALL TYPICAL 2" BLOW-OFF ASSEMBLY w/TRHUST BLOCK. PLUMB BEHIND WALK

SERVICES REPAIRED DURING CONSTRUCTION

STA 1+01 12'LT
INSTALL 2" COMBINATION AIR AND VACUUM RELEASE VALVE. PLUMB BEHIND SIDEWALK

SS STA 15+31
STA 1+94.97 7'RT
INSTALL SS CO

SERVICE LOWERED DURING CONSTRUCTION

SS STA 15+30
STA 1+94.82 40'L
SANITARY SERVICE
L= 47'
D= 6'

STA 1+98
INSTALL HYDRANT ASSEMBLY

INSTALL DUAL WATER SERVICE (TYP)

SS STA 14+63
STA 2+62.81 38.83'L
SANITARY SERVICE
L= 45'
D= 7.5'

10' P.U.E.

SS STA 14+03
STA 3+22.81 40.55'L
SANITARY SERVICE
L= 46'
D= 6'

STA 3+60 17'L
INSTALL CI

SS STA 13+10
STA 4+13.91 46.03'L
SANITARY SERVICE
L= 45'
D= 7'

NEW 5' SIDEWALK

CALLAHAN COURT

34 LF OF 12" STS @1.0%

STA 2+53.28 50.28'R
SANITARY SERVICE

10' P.U.E.

STA 13+60 17'R
INSTALL CI

SS STA 13+60, I-34
STA 3+65 7'RT
INSTALL HDPE SS MH

SS STA 13+55
STA 3+74.90 35.23'R
SANITARY SERVICE
L= 30'
D= 6'

SS STA 12+68
STA 4+56.12 33.95'R
SANITARY SERVICE
L= 34'
D= 7'

LOT 23 LOT 22 LOT 21 LOT 20 LOT 19 LOT 18 LOT 17
LOT 28 LOT 29 LOT 32 LOT 33 LOT 34 LOT 35 LOT 36 LOT 37 LOT 38 LOT 39

10' WIDE x 12" THICK, 5000 PSI REINFORCED CONCRETE CAP INSTALLED OVER GAS LINE BY WILLIAMS GAS COMPANY

SS STA 11+86
STA 5+08.92 41.31'L
SANITARY SERVICE
L= 47'
D= 5'

STA 5+95
INSTALL HYDRANT ASSEMBLY

SS STA 11+40
STA 5+84 40'L
SANITARY SERVICE
L= 47'
D= 5'

INSTALL 544 LF OF 8" C-900 PVC

STA 5+00 17'R
INSTALL CI

SS STA 12+04, I-33
STA 5+20 7'RT
INSTALL HDPE SS MH

SS STA 12+04
STA 5+20 40'R
SANITARY SERVICE
L= 33'
D= 6.5'

SS STA 11+38
STA 5+86 32'R
SANITARY SERVICE

CALLAHAN DRIVE

STA 6+00 L
INSTALL CI w/4' OPENING

34 LF OF 12" STS @1.0%

STA 6+00 17'R
INSTALL CI w/4' OPENING

SS STA 10+75
STA 6+46.73 40'R
SANITARY SERVICE
L= 33'
D= 5'

INSTALL
1- 8" TEE (MJ)
3- 8" GV (FLGxMJ)

10' P.U.E.

SS STA 9+67
STA 7+57.6 38'L
SANITARY SERVICE
L= 45'
D= 4'

SS STA 9+74, I-32
STA 7+50 7'RT
INSTALL HDPE SS MH

SS STA 10+08
STA 7+15.70 43'R
SANITARY SERVICE
L= 36'
D= 5'

CALLAHAN DRIVE

NOTE:
FOR CLARITY, DRIVEWAYS ARE NOT SHOWN. CONTRACTOR TO COORDINATE w/OWNER FOR LOCATION & WIDTH.

CALL BEFORE YOU DIG !
ONE CALL: (800) 332-2344
OAR 952-001-0010 THROUGH
OAR 952-001-0090

FILED
Date: _____ By: _____
The survey consists of:
Map _____
No. _____
Comments: _____
DOUGLAS COUNTY SURVEYOR

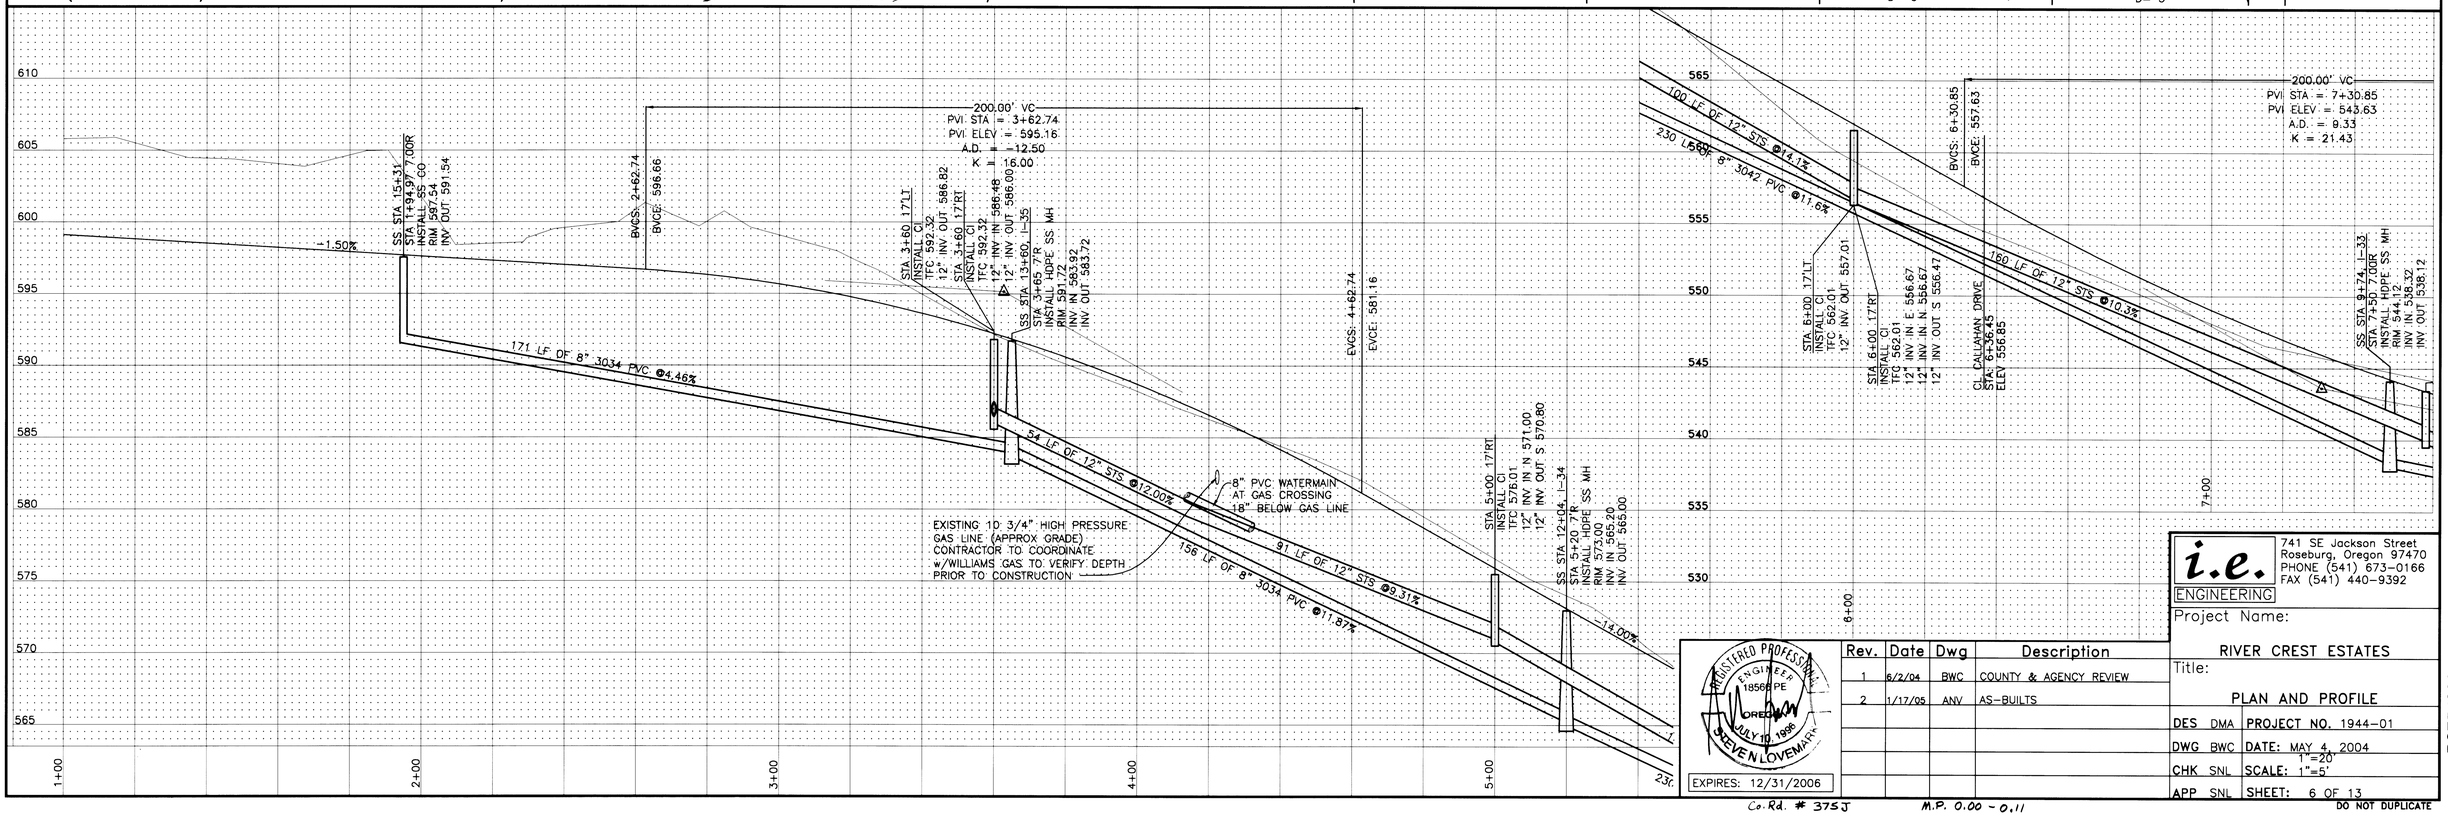

REGISTERED PROFESSIONAL ENGINEER 18568 PE OREGON JULY 10, 1996 STEVEN LOVEMARK
EXPIRES: 12/31/2006

Rev.	Date	Dwg	Description
1	6/2/04	BWC	COUNTY & AGENCY REVIEW
2	1/17/05	ANV	AS-BUILTS

i.e. ENGINEERING
741 SE Jackson Street
Roseburg, Oregon 97470
PHONE (541) 673-0166
FAX (541) 440-9392

Project Name:
RIVER CREST ESTATES

Title:

DES DMA | PROJECT NO. 1944-01
DWG BWC | DATE: MAY 4, 2004
CHK SNL | SCALE: 1"=20' 1"=5'
APP SNL | SHEET: 6 OF 13

DO NOT DUPLICATE

Co.Rd. # 375J M.P. 0.00 - 0.11

R375J000