STA 1+00 12'LT
INSTALL TYPICAL 2" BLOW-OFF ASSEMBLY w/TRHUST BLOCK; PLUMB BEHIND WALK

SERVICES REPAIRED DURING CONSTRUCTION

STA 1+01 12'LT
INSTALL 2" COMBINATION AIR AND VACUUM RELEASE VALVE. PLUMB BEHIND SIDEWALK

SS STA 15+31
STA 1+94.97 7'RT
INSTALL SS CO

SERVICE LOWERED DURING CONSTRUCTION

SS STA 15+30
STA 1+94.82 40'L
SANITARY SERVICE
L= 47'
D= 6'

STA 1+98
INSTALL HYDRANT ASSEMBLY

INSTALL DUAL WATER SERVICE (TYP)

SS STA 14+63
STA 2+62.81 38.83'L
SANITARY SERVICE
L= 45'
D= 7.5'

10' P.U.E.

SS STA 14+03
STA 3+22.81 40.55'L
SANITARY SERVICE
L= 46'
D= 6'

STA 3+60 17'L
INSTALL CI

SS STA 13+10
STA 4+13.91 46.03'L
SANITARY SERVICE
L= 45'
D= 7'

NEW 5' SIDEWALK

CALLAHAN COURT

34 LF OF 12" STS @1.0%

STA 2+53.28 50.28'R
SANITARY SERVICE

10' P.U.E.

STA 13+60 17'R
INSTALL CI

SS STA 13+60, I-34
STA 3+65 7'RT
INSTALL HDPE SS MH

SS STA 13+55
STA 3+74.90 35.23'R
SANITARY SERVICE
L= 30'
D= 6'

SS STA 12+68
STA 4+56.12 33.95'R
SANITARY SERVICE
L= 34'
D= 7'

LOT 23
LOT 22
LOT 28
LOT 21
LOT 29
LOT 20
LOT 32
LOT 19
LOT 18
LOT 33
LOT 34
LOT 35
LOT 36
LOT 37
LOT 38
LOT 39
LOT 17

10' WIDE x 12" THICK, 5000 PSI REINFORCED CONCRETE CAP INSTALLED OVER GAS LINE BY WILLIAMS GAS COMPANY

SS STA 11+86
STA 5+08.92 41.31'L
SANITARY SERVICE
L= 47'
D= 5'

SS STA 11+40
STA 5+84 40'L
SANITARY SERVICE
L= 47'
D= 5'

STA 5+95
INSTALL HYDRANT ASSEMBLY

INSTALL 544 LF OF 8" C-900 PVC

SS STA 12+04, I-33
STA 5+20 7'RT
INSTALL HDPE SS MH

STA 5+00 17'R
INSTALL CI

SS STA 12+04
STA 5+20 40'R
SANITARY SERVICE
L= 33'
D= 6.5'

SS STA 11+38
STA 5+86 32'R
SANITARY SERVICE

STA 6+00 L
INSTALL CI w/4' OPENING

34 LF OF 12" STS @1.0%

STA 6+00 17'R
INSTALL CI w/4' OPENING

SS STA 10+75
STA 6+46.73 40'R
SANITARY SERVICE
L= 33'
D= 5'

INSTALL
1- 8" TEE (MJ)
3- 8" GV (FLGxMJ)

10' P.U.E.

SS STA 9+67
STA 7+57.6 38'L
SANITARY SERVICE
L= 45'
D= 4'

SS STA 9+74, I-32
STA 7+50 7'RT
INSTALL HDPE SS MH

SS STA 10+08
STA 7+15.70 43'R
SANITARY SERVICE
L= 36'
D= 5'

CALLAHAN DRIVE

NOTE:
FOR CLARITY, DRIVEWAYS ARE NOT SHOWN. CONTRACTOR TO COORDINATE w/OWNER FOR LOCATION & WIDTH.

CALL BEFORE YOU DIG !
ONE CALL: (800) 332-2344
OAR 952-001-0010 THROUGH
OAR 952-001-0090

FILED
Date: _____ By: _____
The survey consists of:
Map _____
No. _____
Comment: _____
DOUGLAS COUNTY SURVEYOR

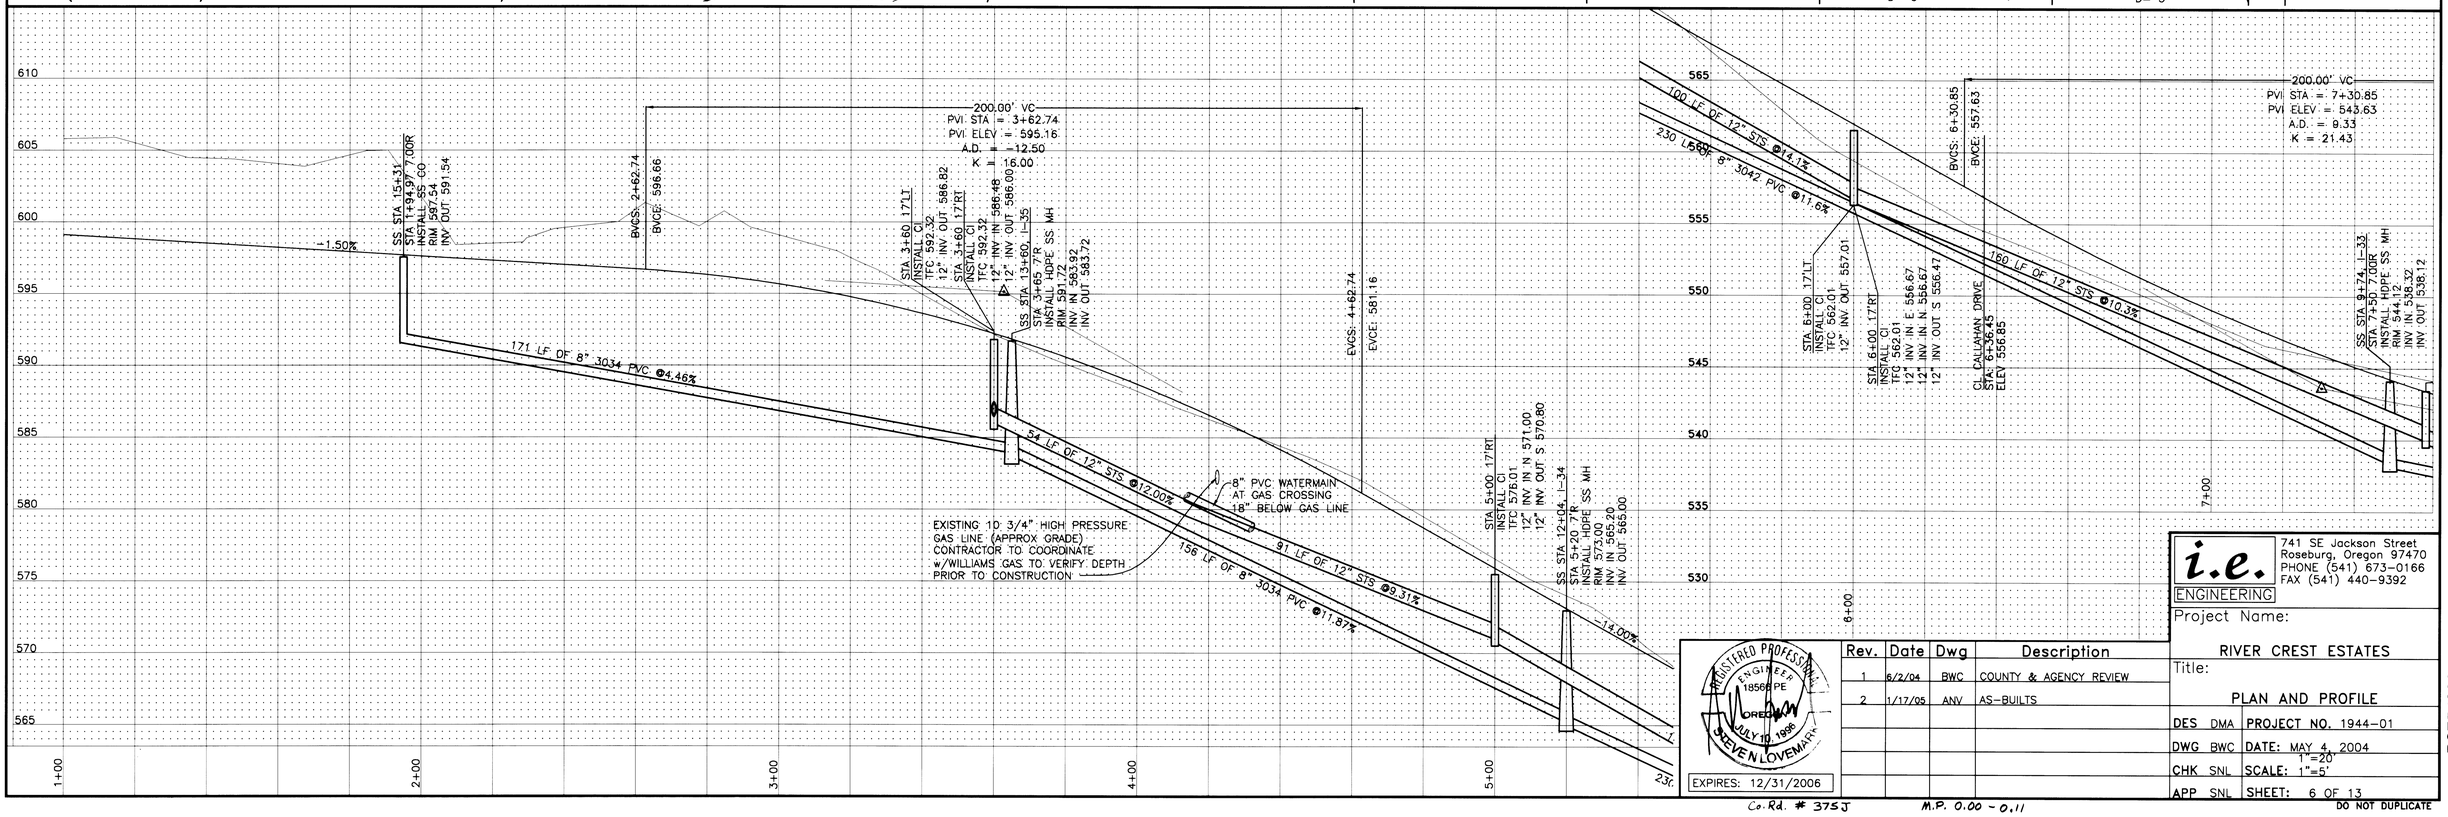

REGISTERED PROFESSIONAL ENGINEER
18568 PE
OREGON
JULY 10, 1996
STEVEN LOVEMARK
EXPIRES: 12/31/2006

i.e. ENGINEERING
741 SE Jackson Street
Roseburg, Oregon 97470
PHONE (541) 673-0166
FAX (541) 440-9392

Rev.	Date	Dwg	Description
1	6/2/04	BWC	COUNTY & AGENCY REVIEW
2	1/17/05	ANV	AS-BUILTS

Project Name:
RIVER CREST ESTATES

Title:
PLAN AND PROFILE

DES	DMA	PROJECT NO.	1944-01
DWG	BWC	DATE:	MAY 4, 2004
CHK	SNL	SCALE:	1"=20' 1"=5'
APP	SNL	SHEET:	6 OF 13

DO NOT DUPLICATE

Co.Rd. # 375J

M.P. 0.00 - 0.11

R375J000