FILED
Date: 3-7-2008 By: JC
This survey consists of:
Map: CO-RD 378 E
Narrative:
Corner Rpt:
DOUGLAS COUNTY SURVEYOR

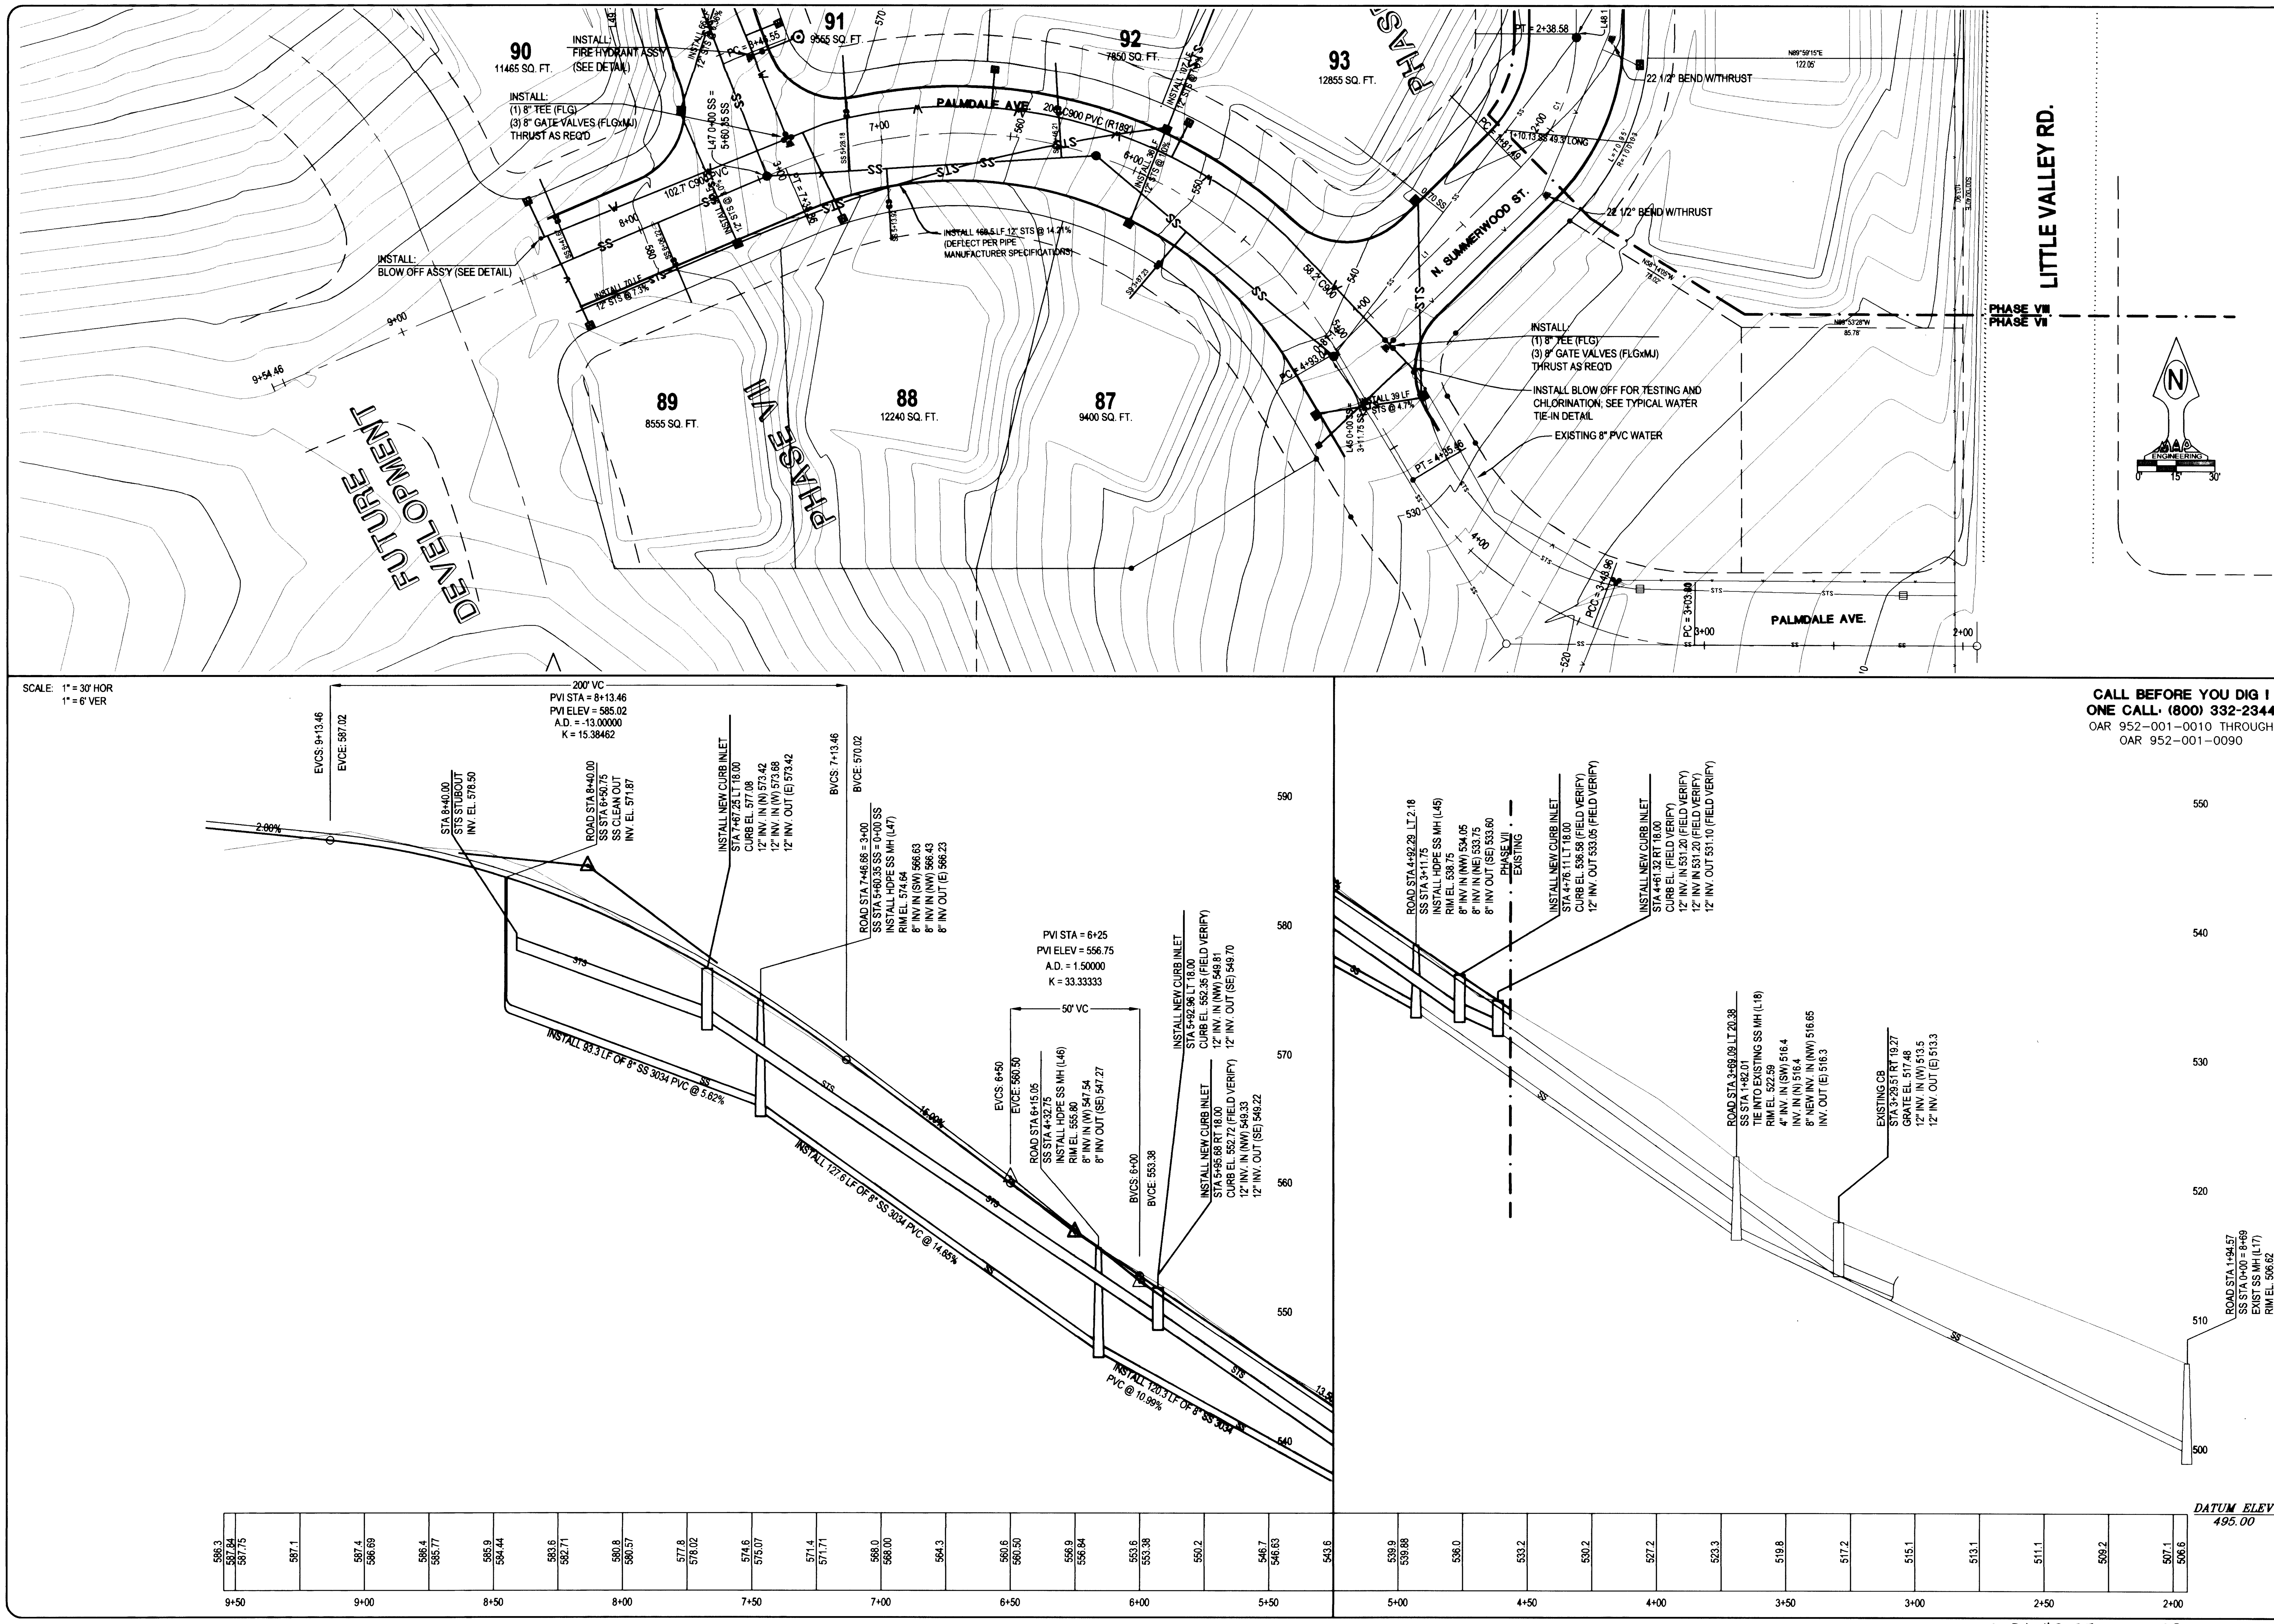

CALL BEFORE YOU DIG !
ONE CALL (800) 332-2344
OAR 952-001-0010 THROUGH
OAR 952-001-0090

STAMP MUST BE SEALED
REGISTERED PROFESSIONAL ENGINEER
11304
OREGON
MIKE A. PARKER
EXPIRATION DATE: 12/31/06

MAP Engineering, Inc.
740 MAIN STREET
ROSEBURG, OREGON 97470
PHONE: (541) 229-0365 FAX: (541) 229-0353
EMAIL: info@mapengineeringinc.com

PROJECT NAME: **ROSEWOOD ESTATES, PHASE VII LITTLE VALLEY ROAD**

DRAWING TITLE: **AS-BUILT PLANS PLAN / PROFILE**

DWG SCALE: 1" = 30' HOR. DATE: 06-30-06 DESIGNER: DRAFTER: APPROVAL: MAP
PROJECT NO.: 1161-04

REVISION #:	BY:	DATE:

SHEET: 3 OF: 9

378E0009

Co.Rd. # 378E MP 0.09 - 0.17

CO RD 378E