FILED
Date: 2-10-97 By: JP
This survey consists of:
Map: ____
Narrative: ____
Corner Rpt: ____
DOUGLAS COUNTY SURVEYOR

SHEET 6 OF 10
PROJ. #16.0300
DATE JUNE '79
SCALE: H 1" = 50' V 1" = 10'
DWG. 16-3

HOWARD BURDETTE
SANTA MARIA ESTATES
PHASE I
SANITARY SEWER & WATER

ALPHA AND OMEGA ENGINEERS

12/10/93	RECORD DWG	D.R.K./J.T.	
10/1/84	REVISION	B.L./B.P.P.	
DEC/HDS	1/86 MDH	1/86 MLT	APP'D MLT

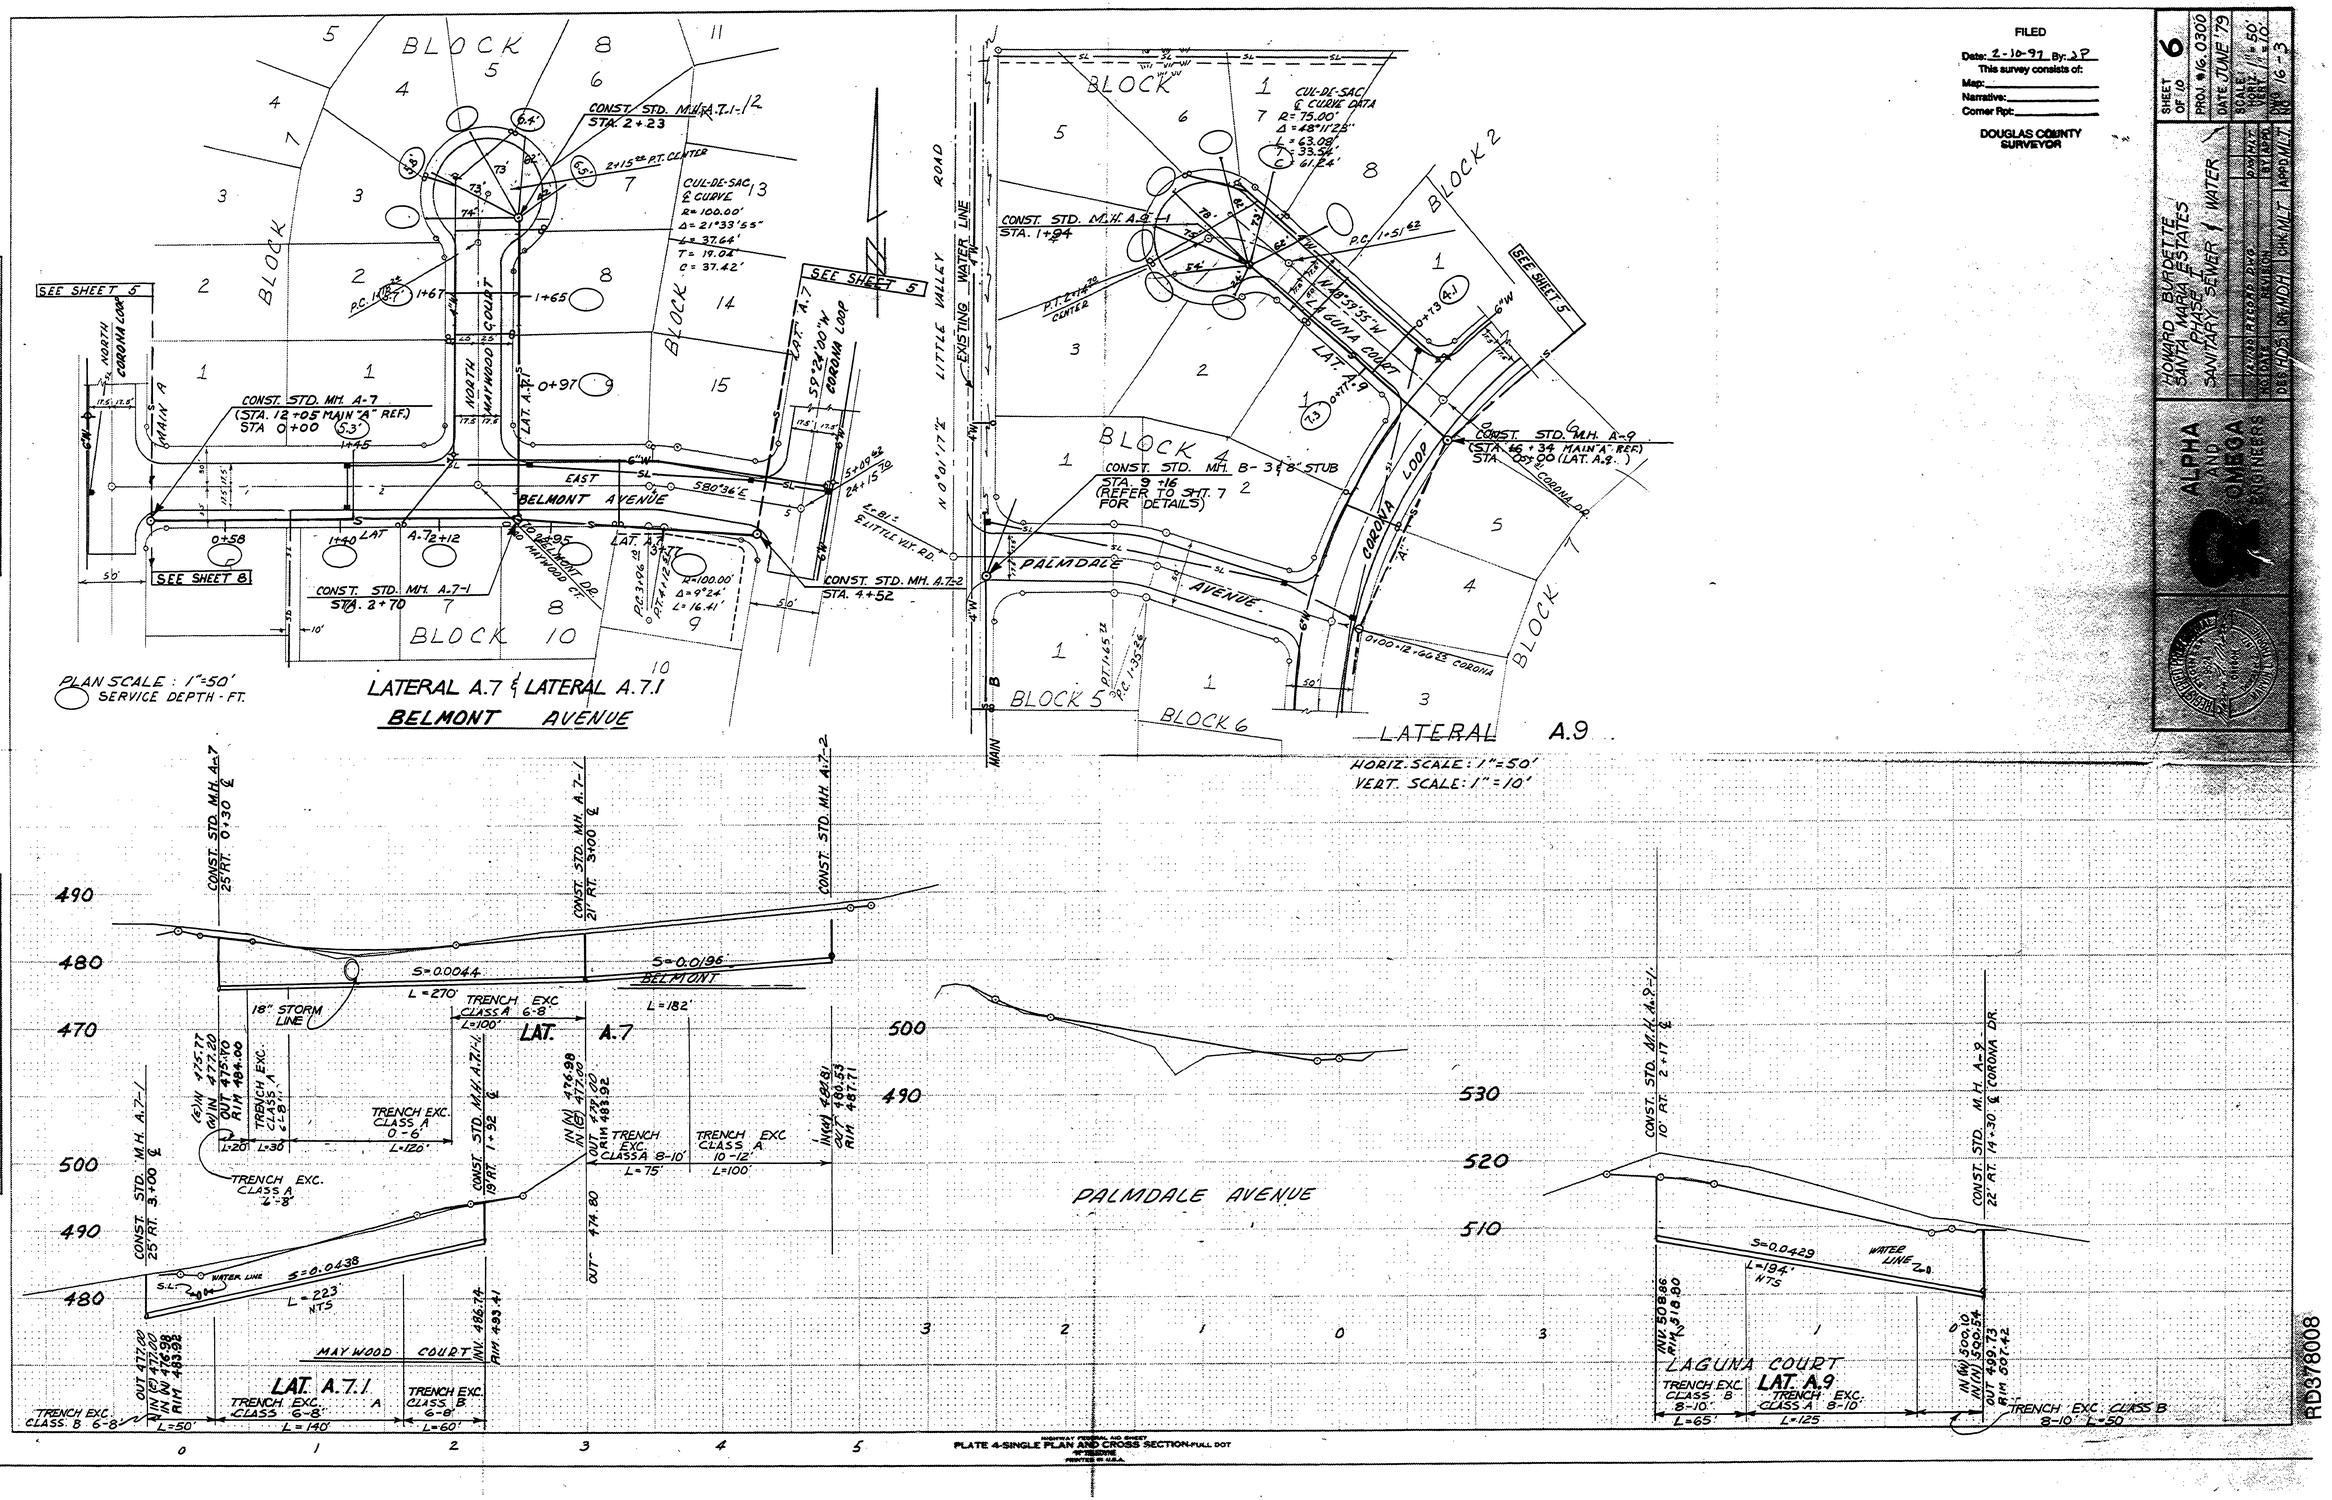

FINAL SURVEY — SURVEYED, PLOTTED, TEMPLATE, AREAS, AREAS CHECKED, NOTE BOOK NO., BY, DATE

ORIGINAL SURVEY — SURVEYED, PLOTTED, TEMPLATE, AREAS, AREAS CHECKED, NOTE BOOK NO., BY, DATE

RD378008

CO. RD. #378-E SAN. SEWER & WATER

52