FILED
Date: 7/1/2002 By: JP
This survey consists of:
Map:
Narrative:
Corner Rpt:
DOUGLAS COUNTY SURVEYOR

LEGEND

- ○ FOUND SURVEY MONUMENT AS NOTED
- ⌖ FOUND BRASS CAP GRID CONTROL AS NOTED
- ◉ SET 1.5" BRASS CAP IN ROCK STAMPED LS 866
- △ COMPUTED POINT
- ● SET 5/8" X30" IRON ROD AND 1.5" PLASTIC CAP "LS 866" ATTACHED

N

0 50 100 200

SCALE

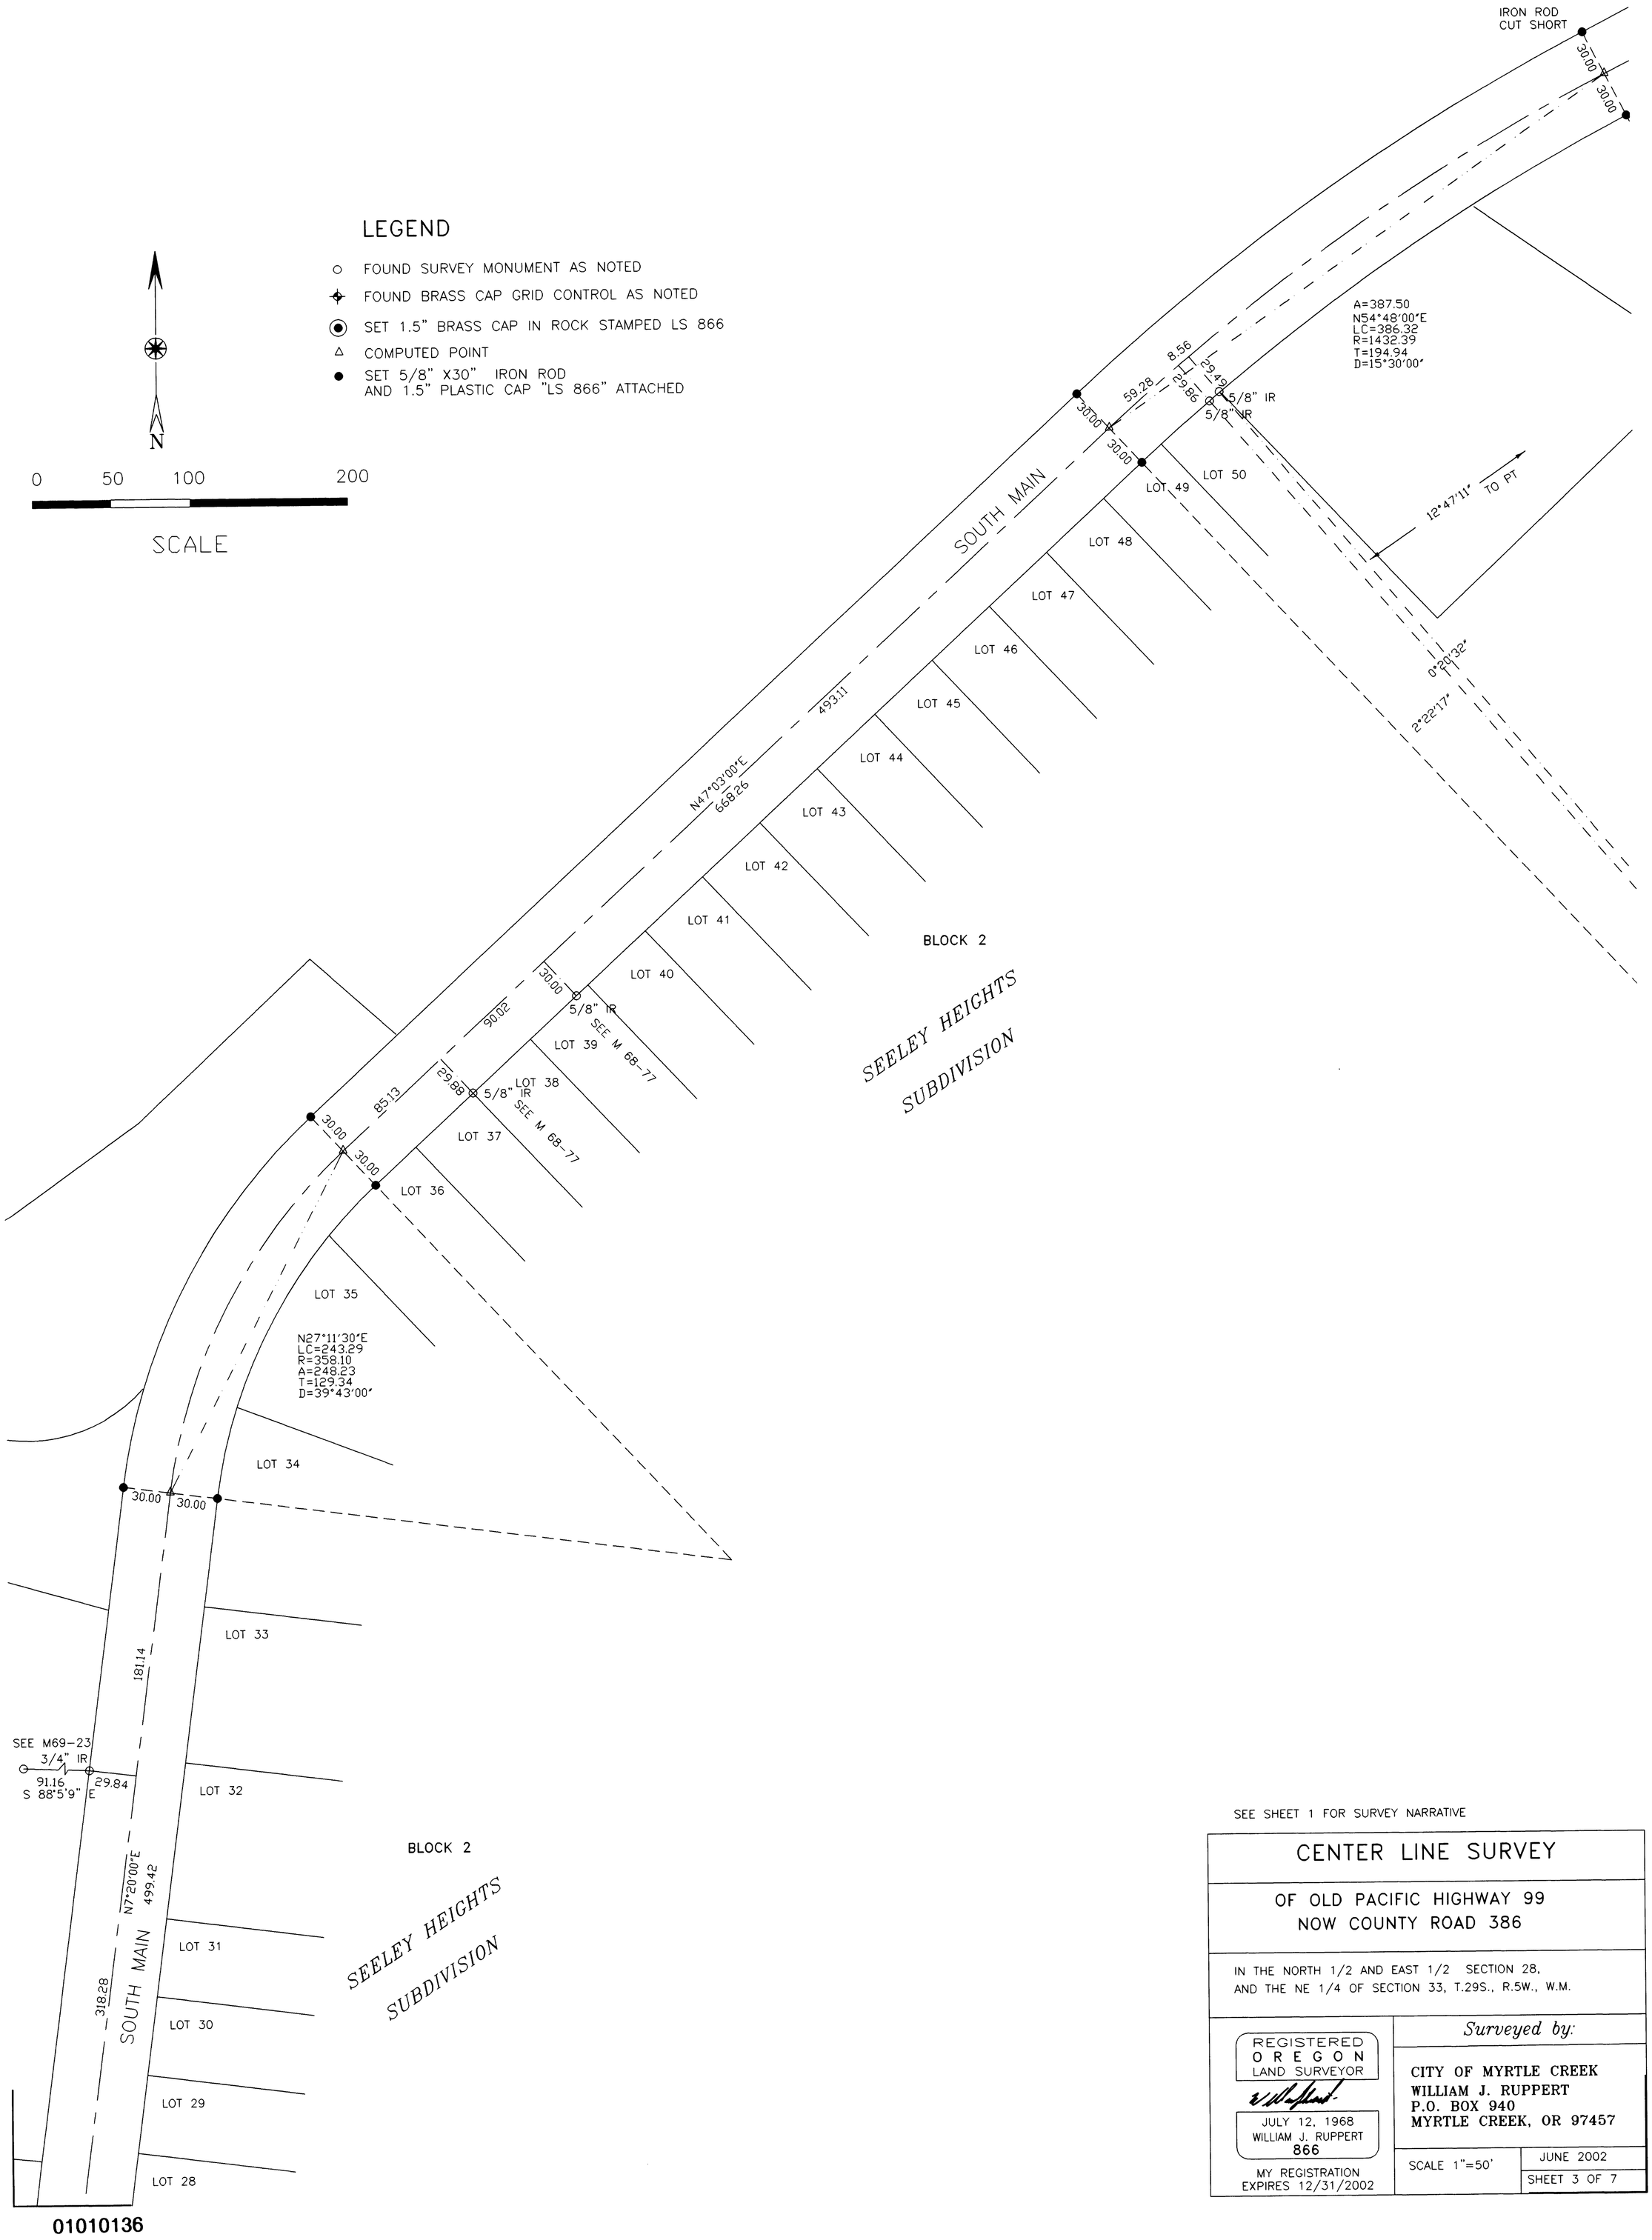

M.P. 1.01 - 1.36

CO. RD. # 386.

01010136

SEE SHEET 1 FOR SURVEY NARRATIVE

CENTER LINE SURVEY

OF OLD PACIFIC HIGHWAY 99
NOW COUNTY ROAD 386

IN THE NORTH 1/2 AND EAST 1/2 SECTION 28,
AND THE NE 1/4 OF SECTION 33, T.29S., R.5W., W.M.

REGISTERED
OREGON
LAND SURVEYOR
JULY 12, 1968
WILLIAM J. RUPPERT
866
MY REGISTRATION EXPIRES 12/31/2002

Surveyed by:

CITY OF MYRTLE CREEK
WILLIAM J. RUPPERT
P.O. BOX 940
MYRTLE CREEK, OR 97457

SCALE 1"=50'

JUNE 2002

SHEET 3 OF 7