FILED

AUG 10 1987

COUNTY SURVEYOR
DOUGLAS COUNTY, ORE.

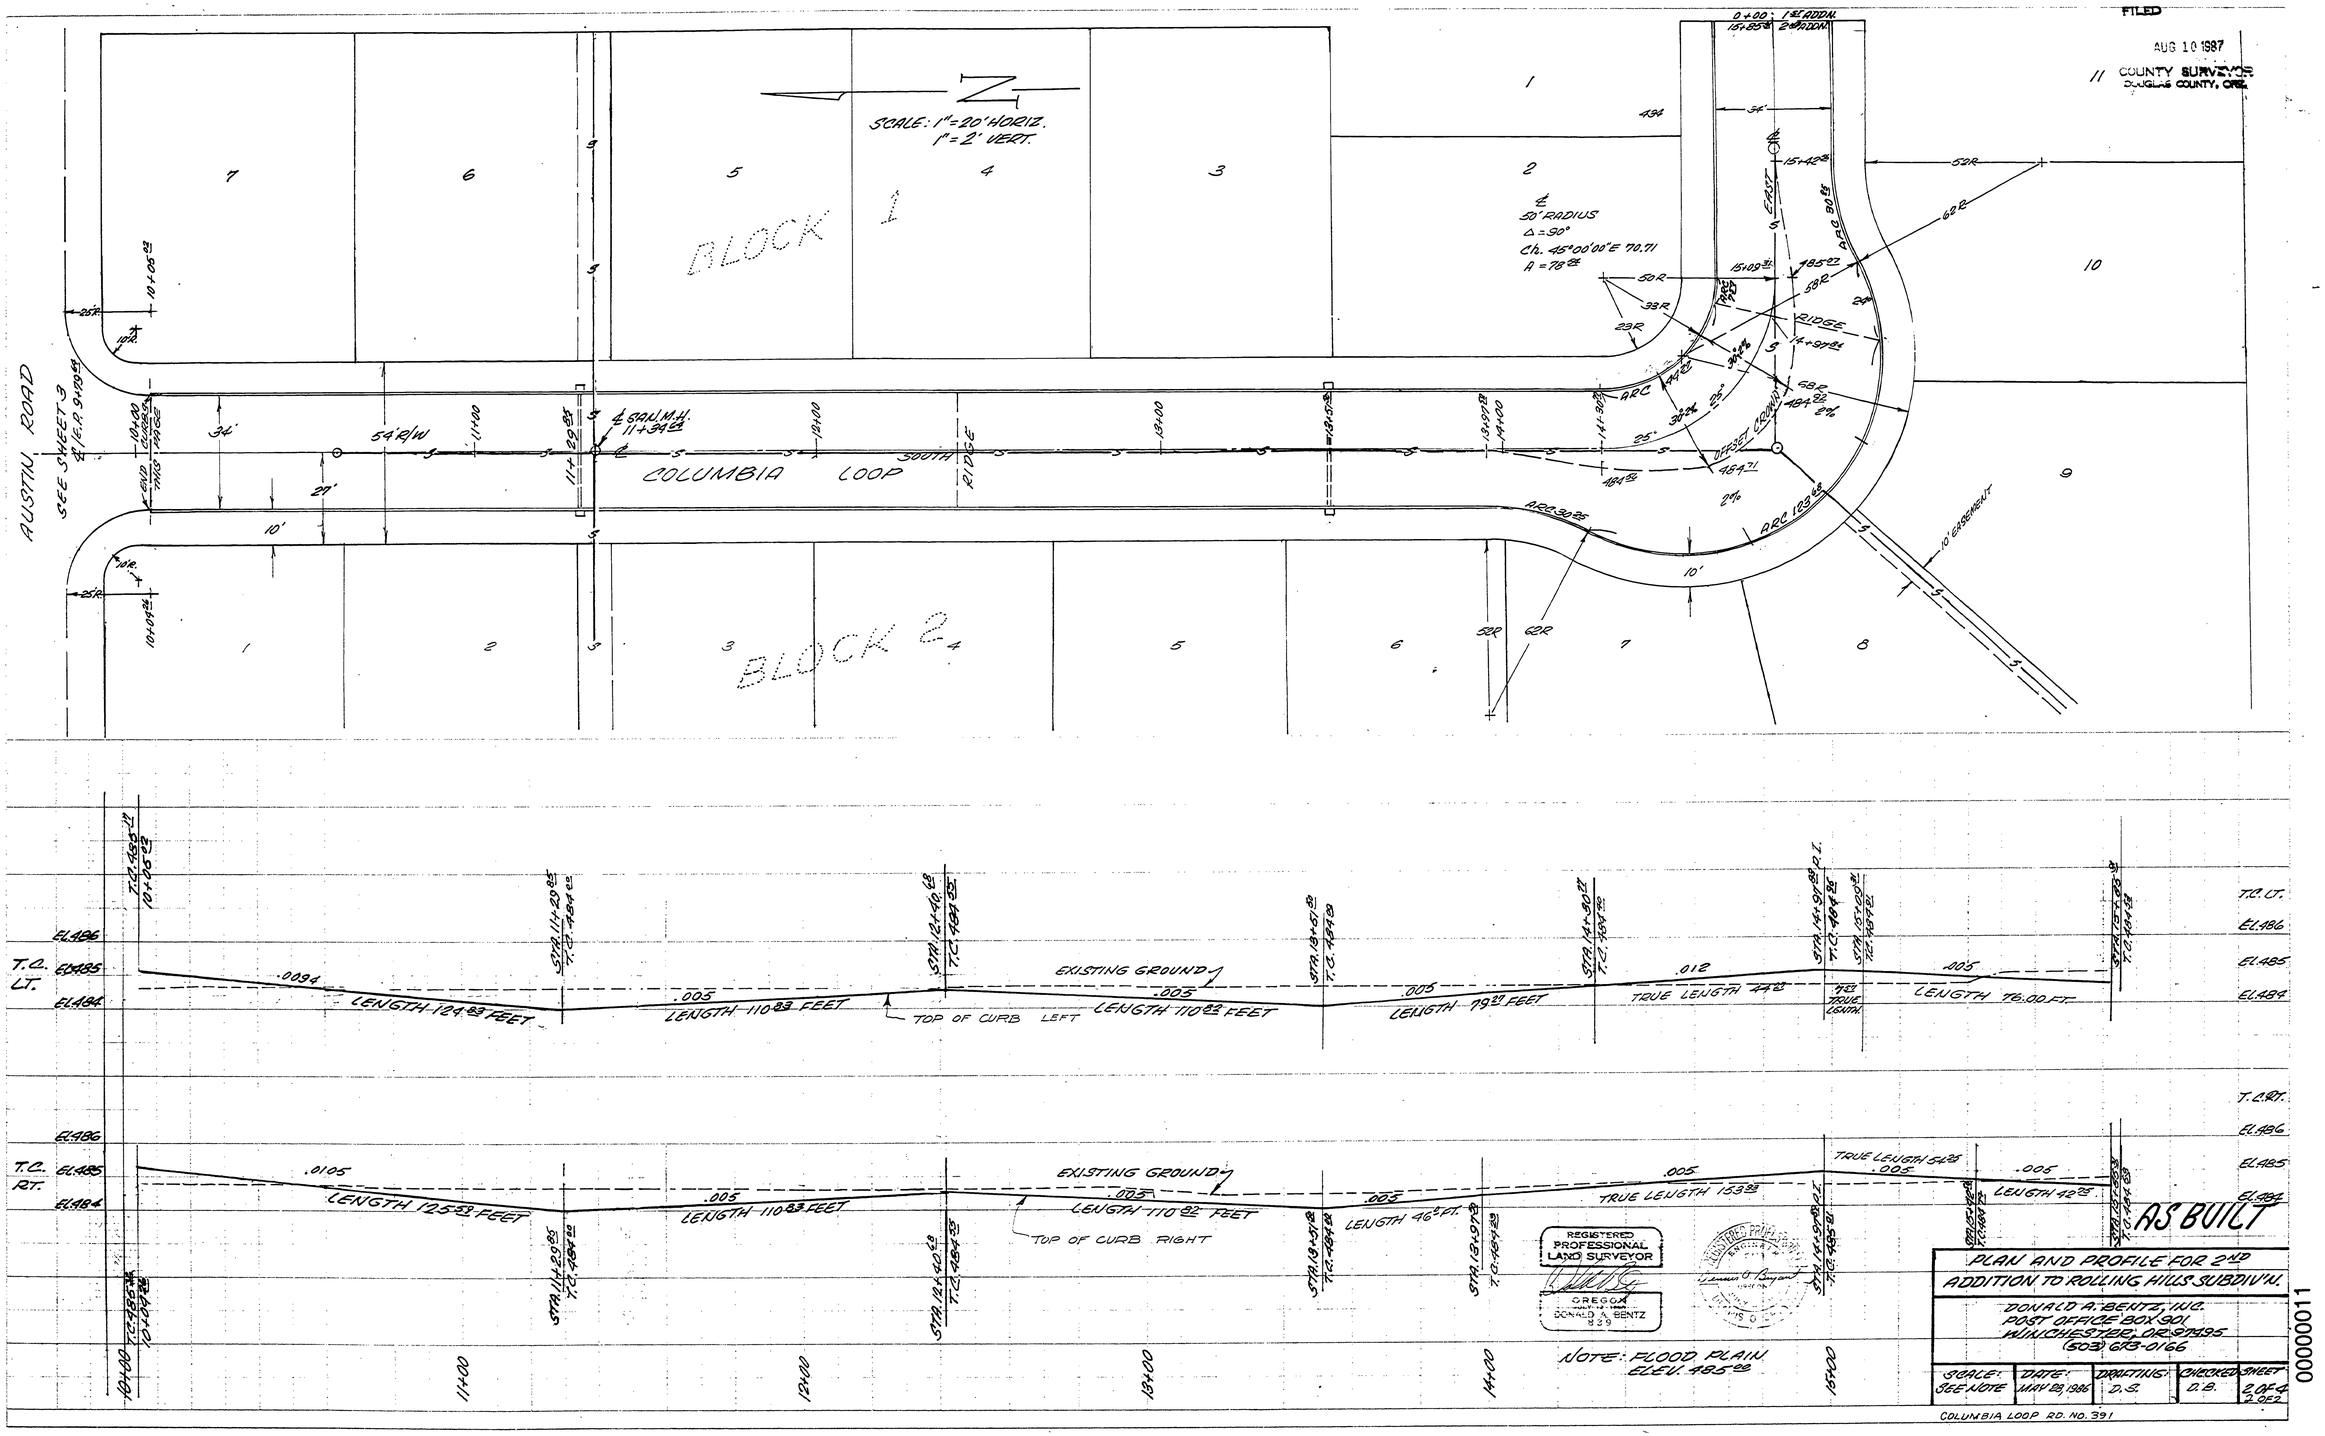

M.P. 0.00 - 0.11 # 391 1986

74

00000011