FILED
Date: 1-6-2000 By: JP
This survey consists of:
Map:
Narrative:
Corner Rpt:
DOUGLAS COUNTY SURVEYOR

DARK HORSE STREET

LOT 1 | LOT 2 | LOT 3 | LOT 4 | LOT 5 | LOT 10 | LOT 11 | LOT 12 | LOT 13 | LOT 14 | LOT 15 | LOT 16

ADAMS LOOP

MONTE WAY

STA: 13+60 17'LT GUTTER INLET(BY OTHERS)
12" STS (BY OTHERS)
STA: 1+16 L: 28.1' D: 8.0'
STA: 1+00, SS INSTALL SSMH
WATER SERVICES UNDER ROAD TO BE INSTALLED IN PVC CONDUITS (TYP.)
INSTALL DUAL WATER METER (TYP WHERE SHOWN)
STA: 2+28.5 L: 30.7' D: 8'
STA: 2+91 L: 33.7' D: 7.7'
STA: 3+24 L: 31' D: 8'
STA: 3+89 L: 35.8' D: 6'
STA: 17+58.63, 17'LT CR TC ELEV: 525.71
8" SS (BY OTHERS)
STA: 13+73, END OF PAVEMENT (BY OTHERS)
STA: 14+27.5, 0.8'RT END OF 8" SS (BY OTHERS)
STA: 3+14, SS INSTALL SSMH
STA: 13+72, END OF CURB AND GUTTER (BY OTHERS)
NO MEGA-LUGS
INSTALL 4" SS LATERAL (TYP. ALL LOTS)
PC = 14+19.18
STA: 4+54, SS INSTALL SSMH
PT = 13+88.53
8" FLEX COUPLERS
PROPOSED 8" C-900 (BY OTHERS)
STA: 1+15 L: 32.2' D: 6.0'
INSTALL 285 L.F. OF 8" C-900 WATERLINE
STA: 2+23 L: 29.6' D: 6.4'
STA: 2+92 L: 31.8' D: 6.1'
INSTALL 22.5° BEND w/THRUST BLOCK (NO MEGA-LUGS)
STA: 3+84 L: 29' D: 8'
INSTALL 100 L.F. OF 8" C-900 WATERLINE
STA: 17+83.00, 17'RT CR TC ELEV: 525.41
STA: 13+72.41, 17'RT CR TC ELEV: 504.27
PT = 11+18.40
STA: 14+46.41, 17'RT CR TC ELEV: 505.53
INSTALL: 1-8"x8"x6" TEE, FLG 2-8" GATE VALVES, FLGxMJ 1-6" GATE VALVES, FLGxMJ THRUST BLOCK AS REQUIRED
INSTALLED MEGA-LUGS
NO MEGA-LUGS
17+94.88
CALL BEFORE YOU DIG !
ONE CALL: (800) 332-2344
ORS 757.541 TO 757.571

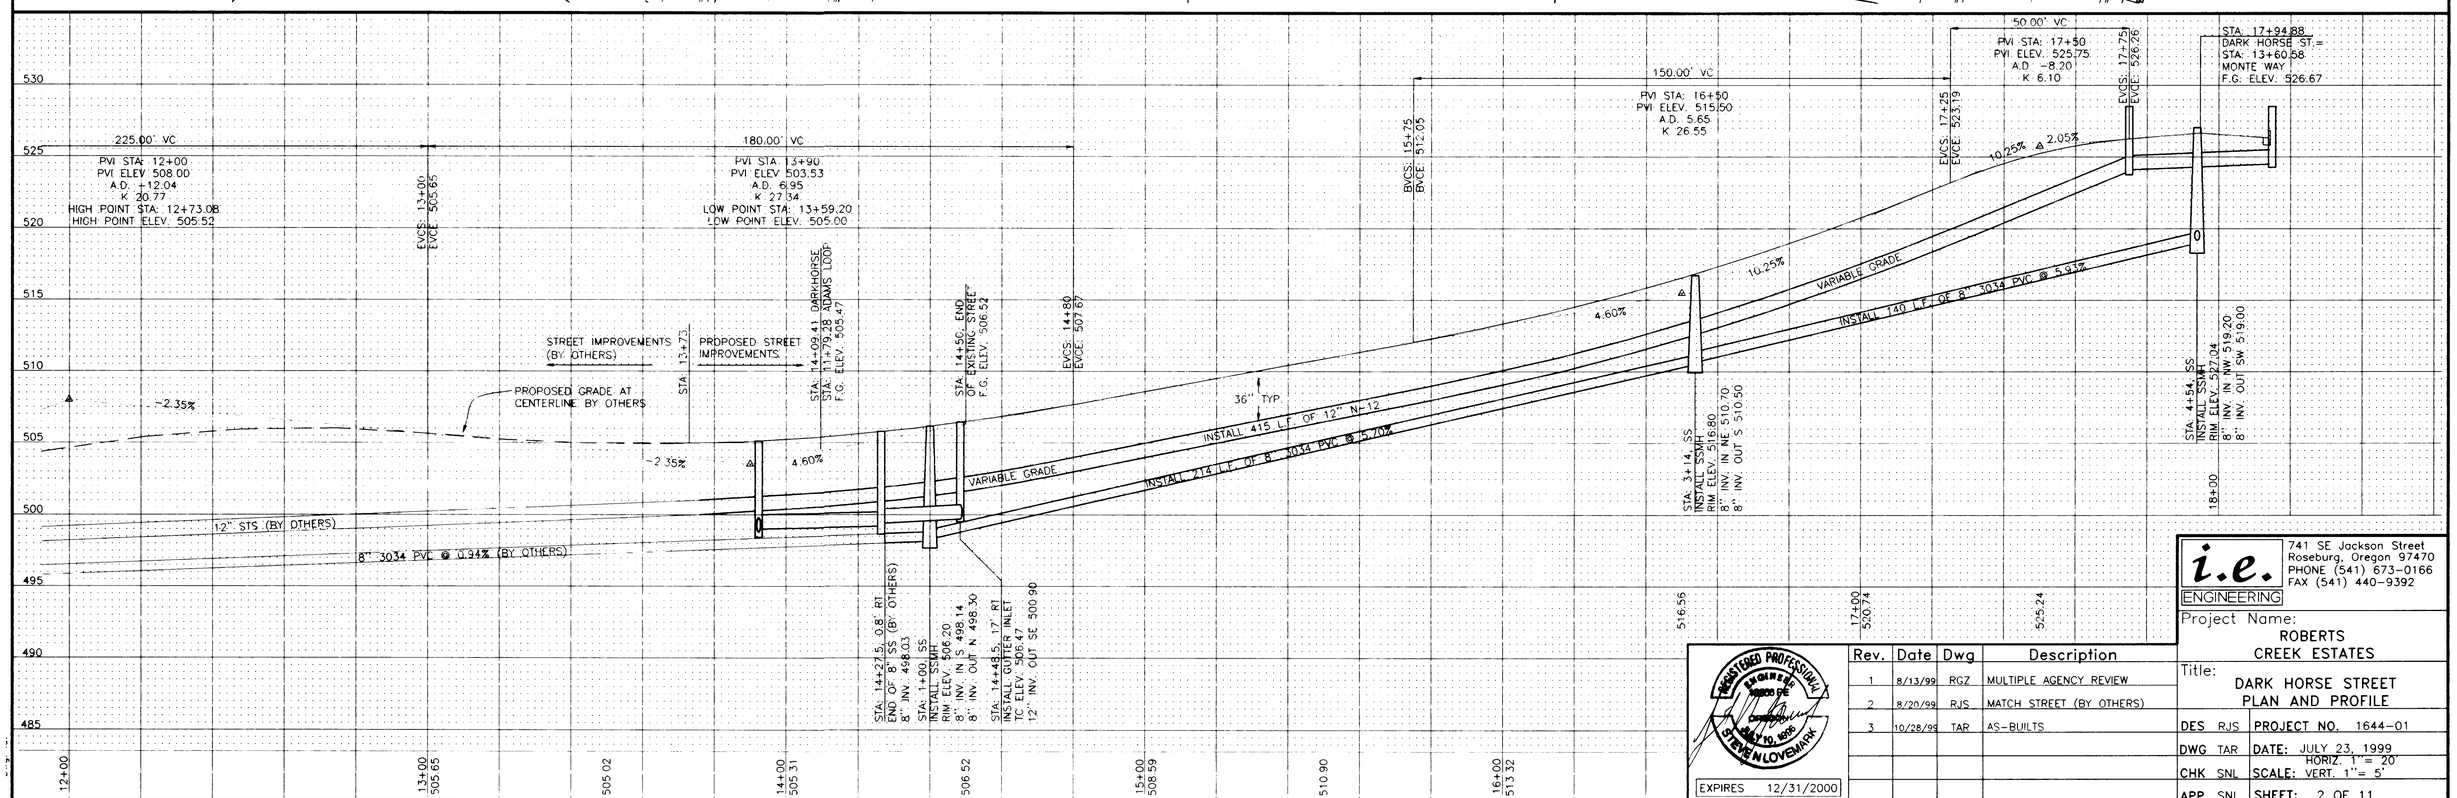

REGISTERED PROFESSIONAL ENGINEER 14000 OR STEVEN LOVEMARK JULY 10, 1998
EXPIRES 12/31/2000

Rev.	Date	Dwg	Description
1	8/13/99	RGZ	MULTIPLE AGENCY REVIEW
2	8/20/99	RJS	MATCH STREET (BY OTHERS)
3	10/28/99	TAR	AS-BUILTS

i.e. ENGINEERING
741 SE Jackson Street
Roseburg, Oregon 97470
PHONE (541) 673-0166
FAX (541) 440-9392

Project Name: ROBERTS CREEK ESTATES

Title: DARK HORSE STREET PLAN AND PROFILE

DES RJS | PROJECT NO. 1644-01
DWG TAR | DATE: JULY 23, 1999
CHK SNL | SCALE: HORIZ. 1" = 20' VERT. 1" = 5'
APP SNL | SHEET: 2 OF 11

DO NOT DUPLICATE

CO. RD. # 404

Co. Rd. # 404

00230034