FILED
Date: 5/19/2000 By: JP
This survey consists of:
Map: _____
Narrative: _____
Corner Rpt: _____
DOUGLAS COUNTY SURVEYOR

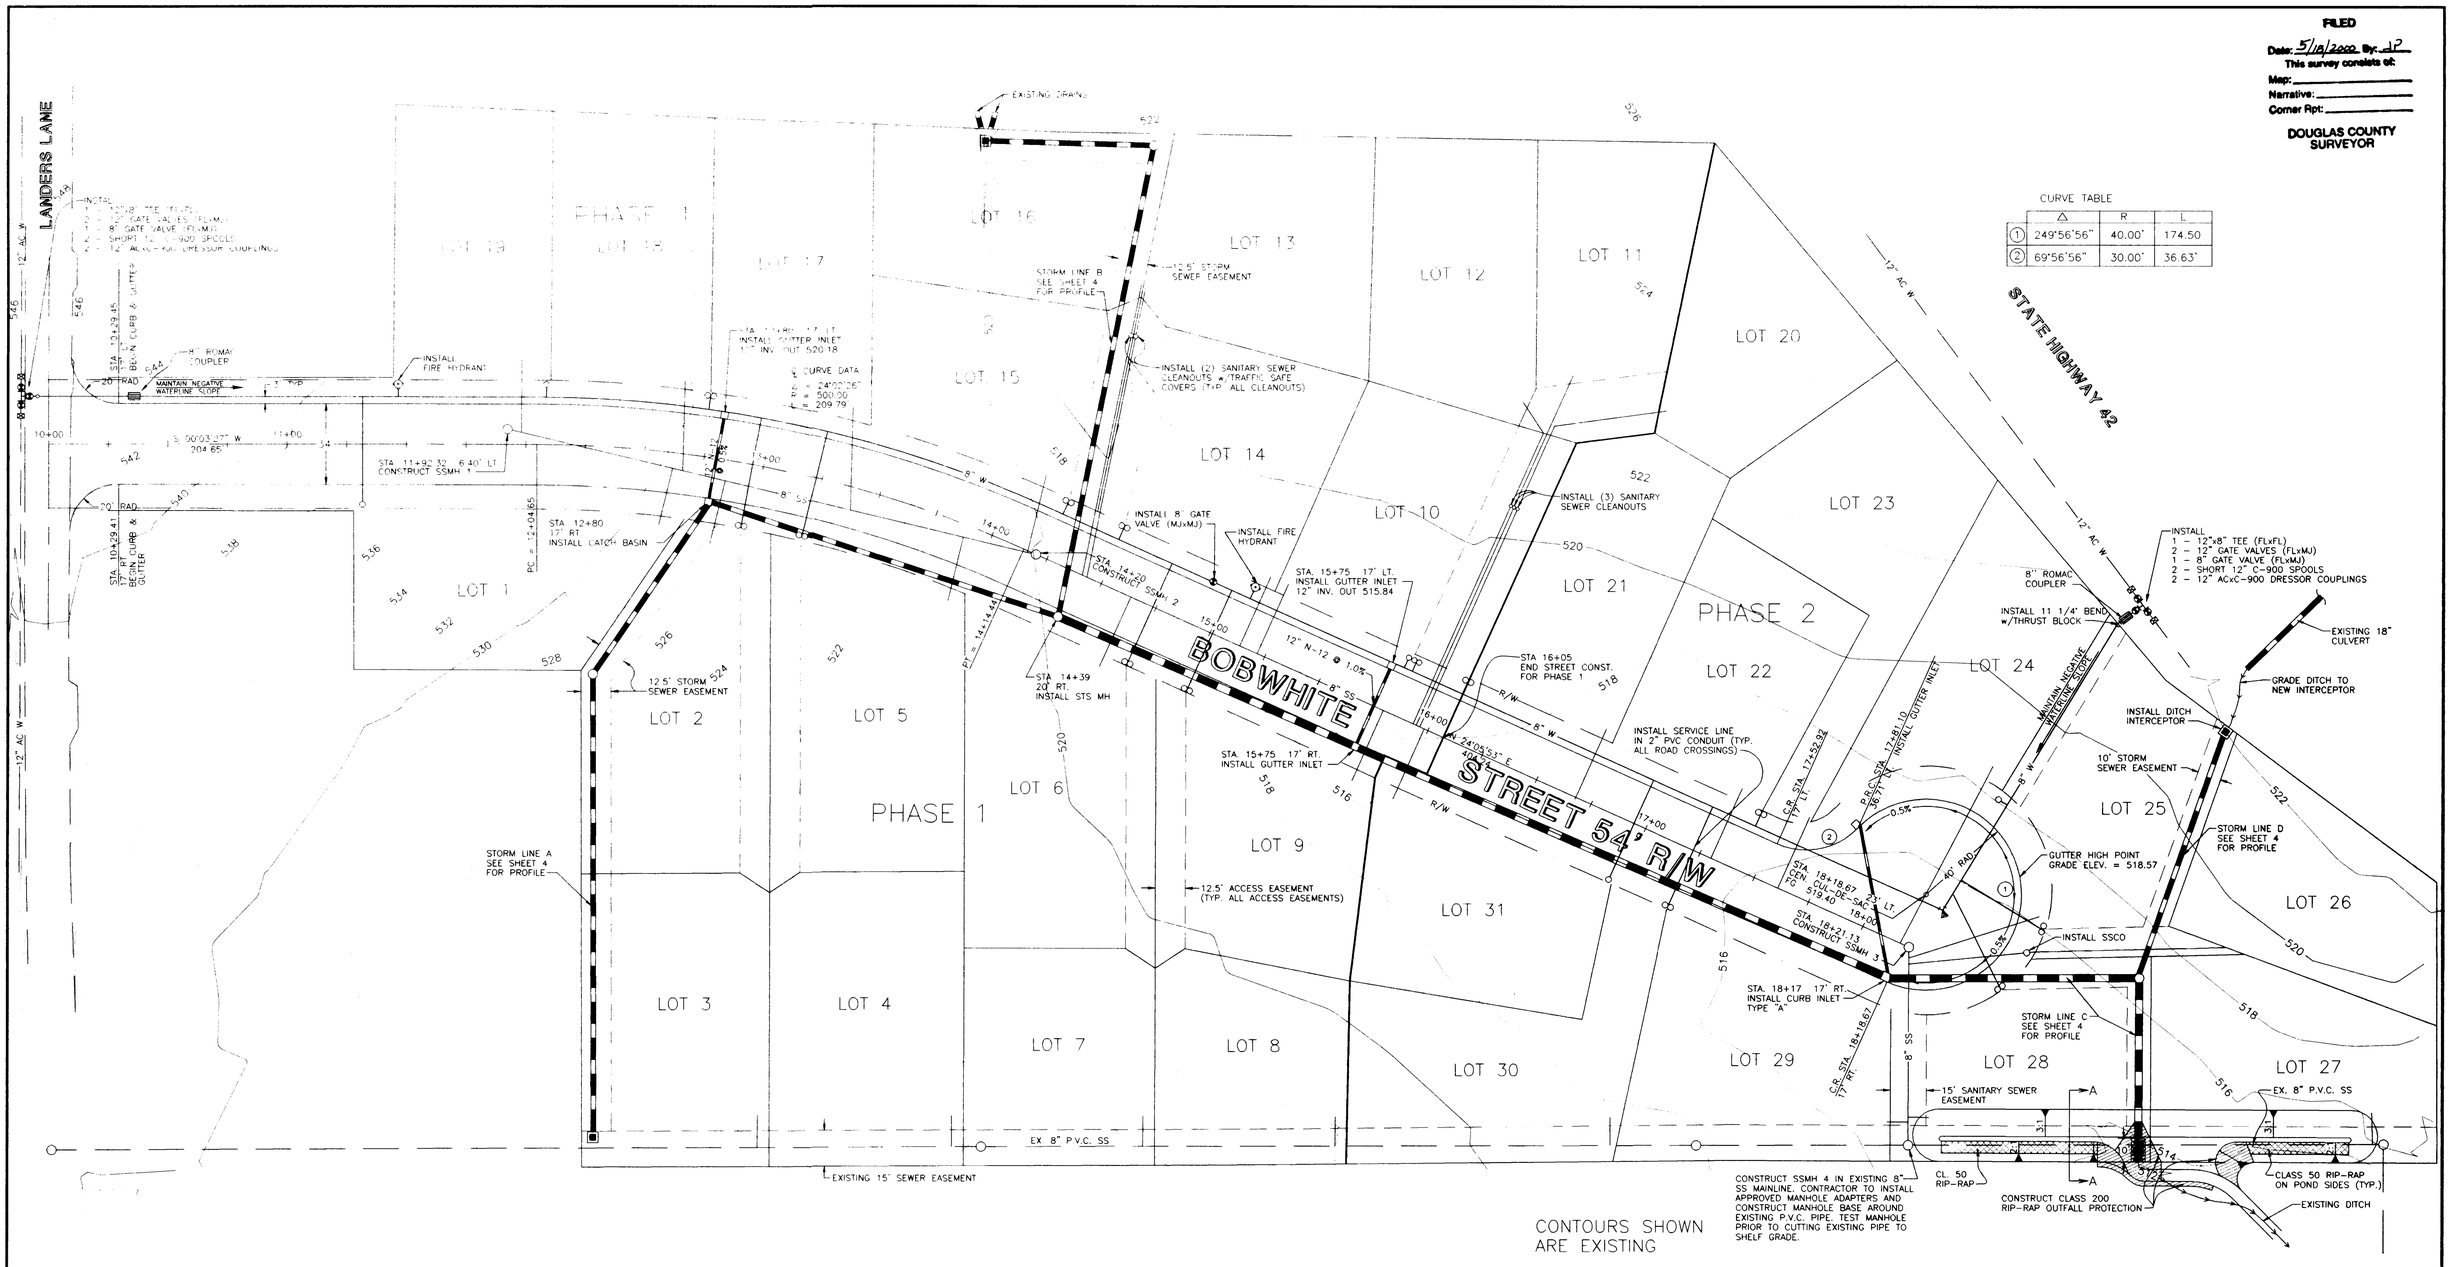

CURVE TABLE

	Δ	R	L
1	249°56'56"	40.00'	174.50
2	69°56'56"	30.00'	36.63'

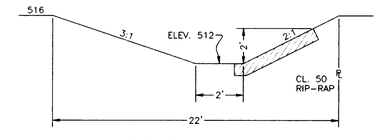

SECTION A-A

SCALE: 1" = 30'

Rev.	Date	Dwg	Description
1	4/16/96	DAF	GREEN SANITARY DISTRICT REVIEW
2	4/16/96	DAF	DOUGLAS COUNTY REVIEW
3	4/25/96	DAF	ROBERTS CREEK WATER DIST. COMMENTS
4	5/8/96	DAF	DOUGLAS COUNTY COMMENTS
5	10/16/98	TAR	AS-BUILTS

EXPIRES 12/31/96

i.e. ENGINEERING
548 SE Jackson Street
Roseburg, Oregon 97470
PHONE (541) 673-0166
FAX (541) 440-9392

Project Name: QUAIL HOLLOW SUBDIVISION

Title: UTILITY PLAN

DES	RJS	PROJECT NO.	1155-01
DWG	DAF	DATE:	MARCH, 1996
CHK	CW	SCALE:	AS SHOWN
APP	MAP	SHEET	2 OF 6

DO NOT DUPLICATE

RD405UTL

CO. RD. # 405