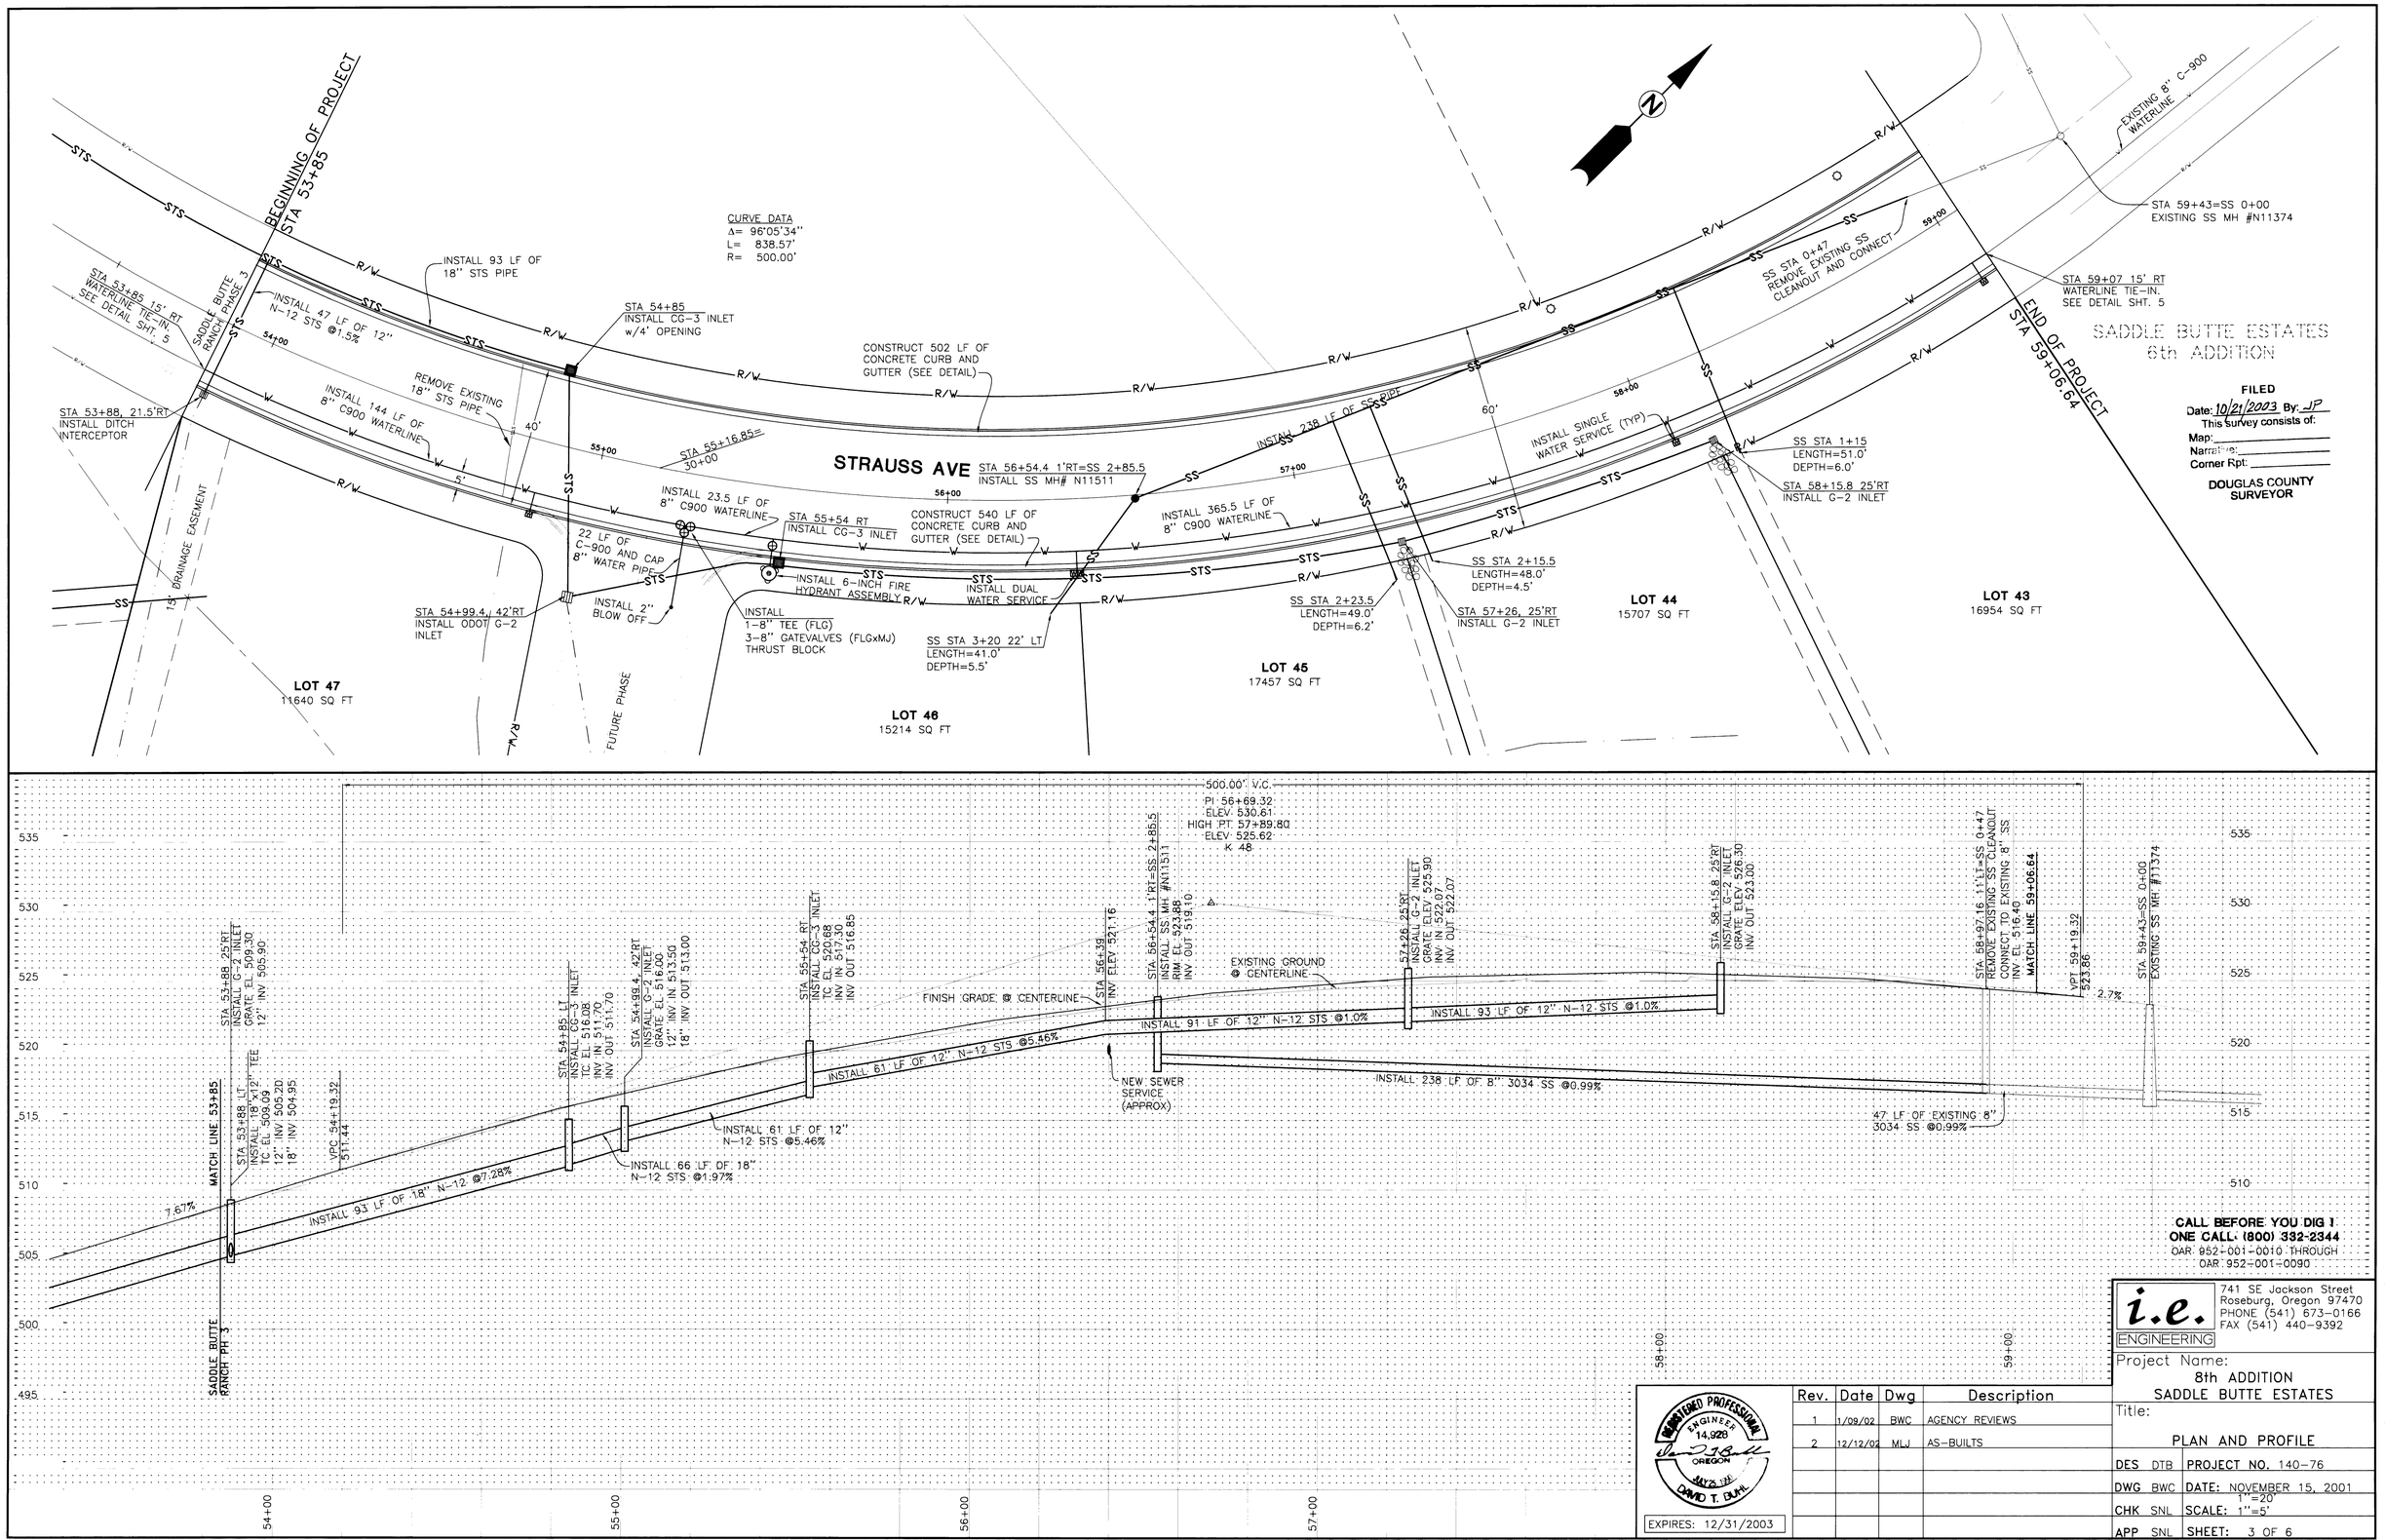

Rev.	Date	Dwg	Description
1	1/09/02	BWC	AGENCY REVIEWS
2	12/12/02	MLJ	AS-BUILTS

Co. Rd. # 901A M.P. ~ 0.35 - 0.48

CO. RD. #901A PLAN & PROFILE