NOTES:
1. CONTRACTOR SHALL CLEAN AND REMOVE ALL ROCK AND OTHER DEBRIS FROM BOTH EXISTING CATCH BASINS LOCATED AT APPROXIMATELY STATION 9+50 ALONG STRAUSS AVENUE BEFORE FINAL ACCEPTANCE OF WORK.
2. ALL CURB AND GUTTER ALONG THE HIGH SIDE OF STRAUSS AVE. (ALONG SOUTH SIDE) SHALL BE CONSTRUCTED WITH A NORMAL LIP WITH A 1" DROP, PER STANDARD DETAIL.
3. THE LOWER PRESSURE ZONE IS THE STANDARD CITY OF ROSEBURG WATER PRESSURE ZONE. ALL FINISHED FLOOR ELEVATIONS MUST BE LESS THAN 620 FEET. ALL LOTS IN THE UPPER WATER PRESSURE ZONE WILL BE SERVED OFF THE PUMP STATION AND WILL HAVE FINISHED FLOORS ABOVE 620 FEET.
4. ALL THRUST BLOCKS SHALL BE INSTALLED PER DETAIL.

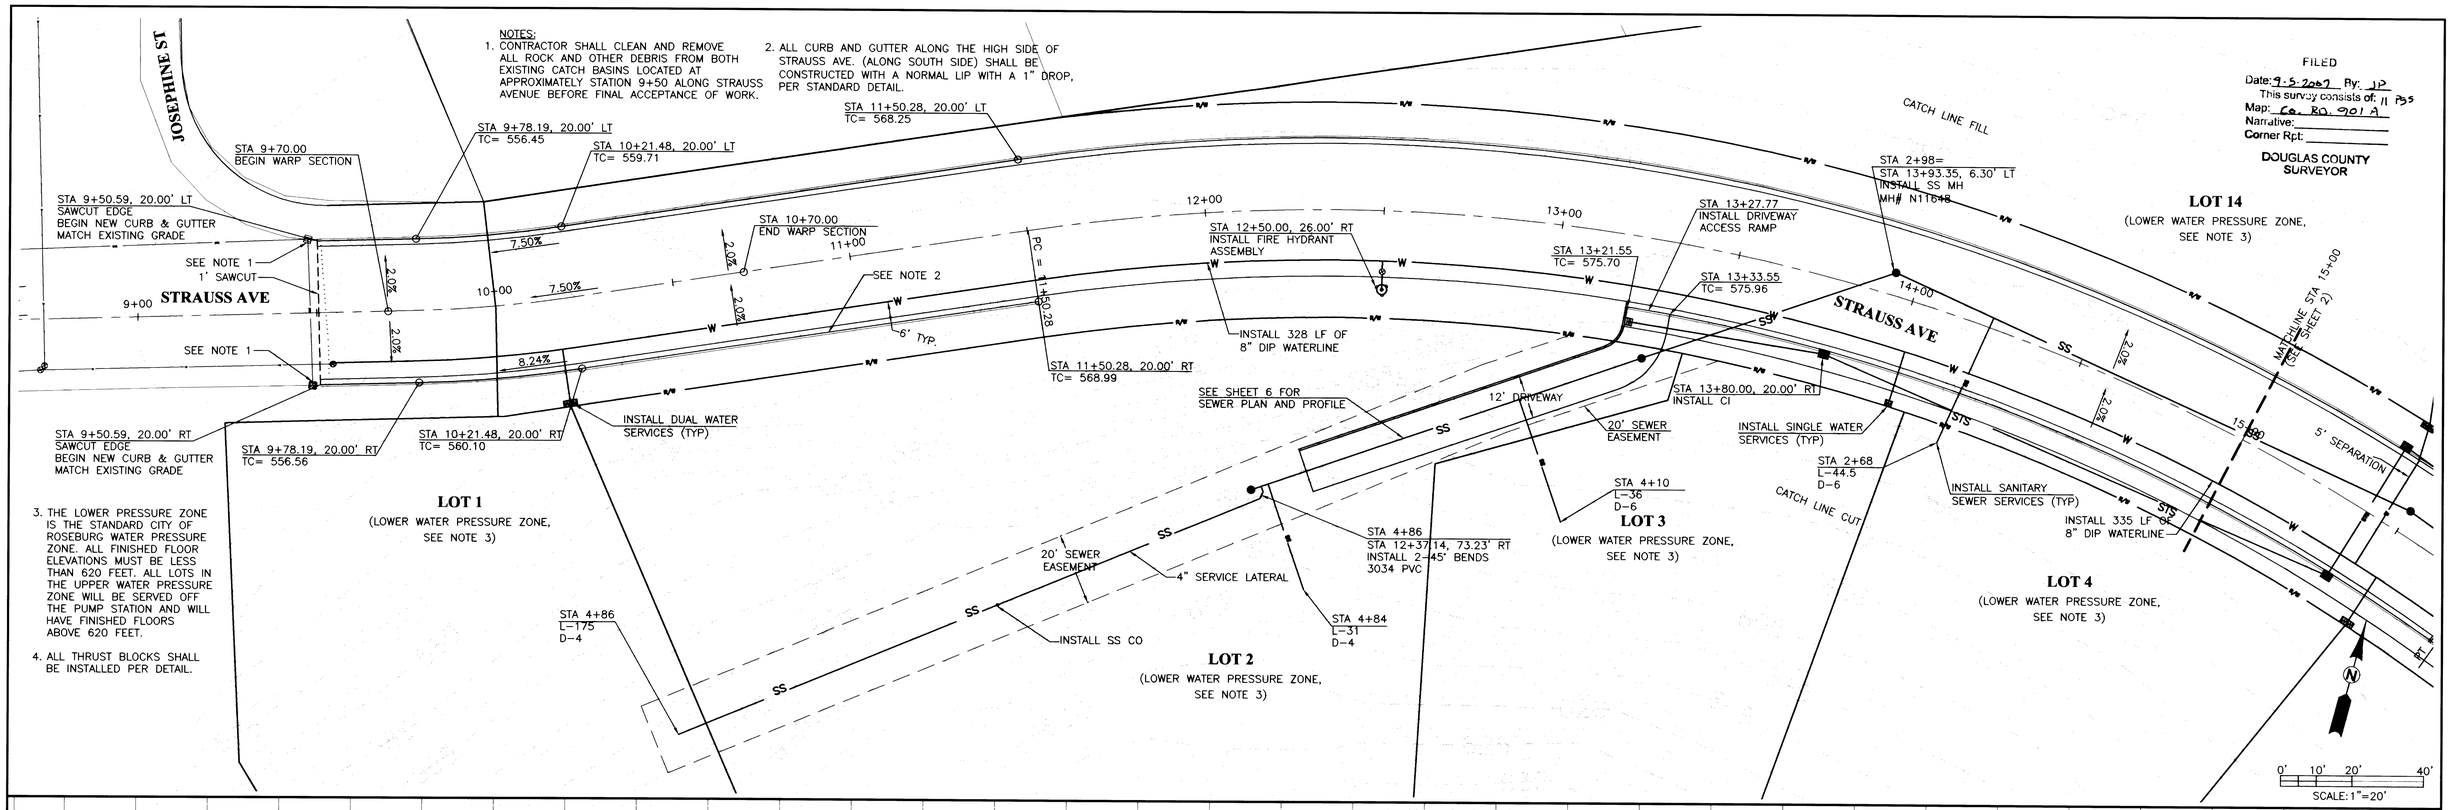

FILED
Date: 9-5-2007 By: JP
This survey consists of: 11 PGS
Map: Co. Rd. 901 A
Narrative:
Corner Rpt:
DOUGLAS COUNTY SURVEYOR

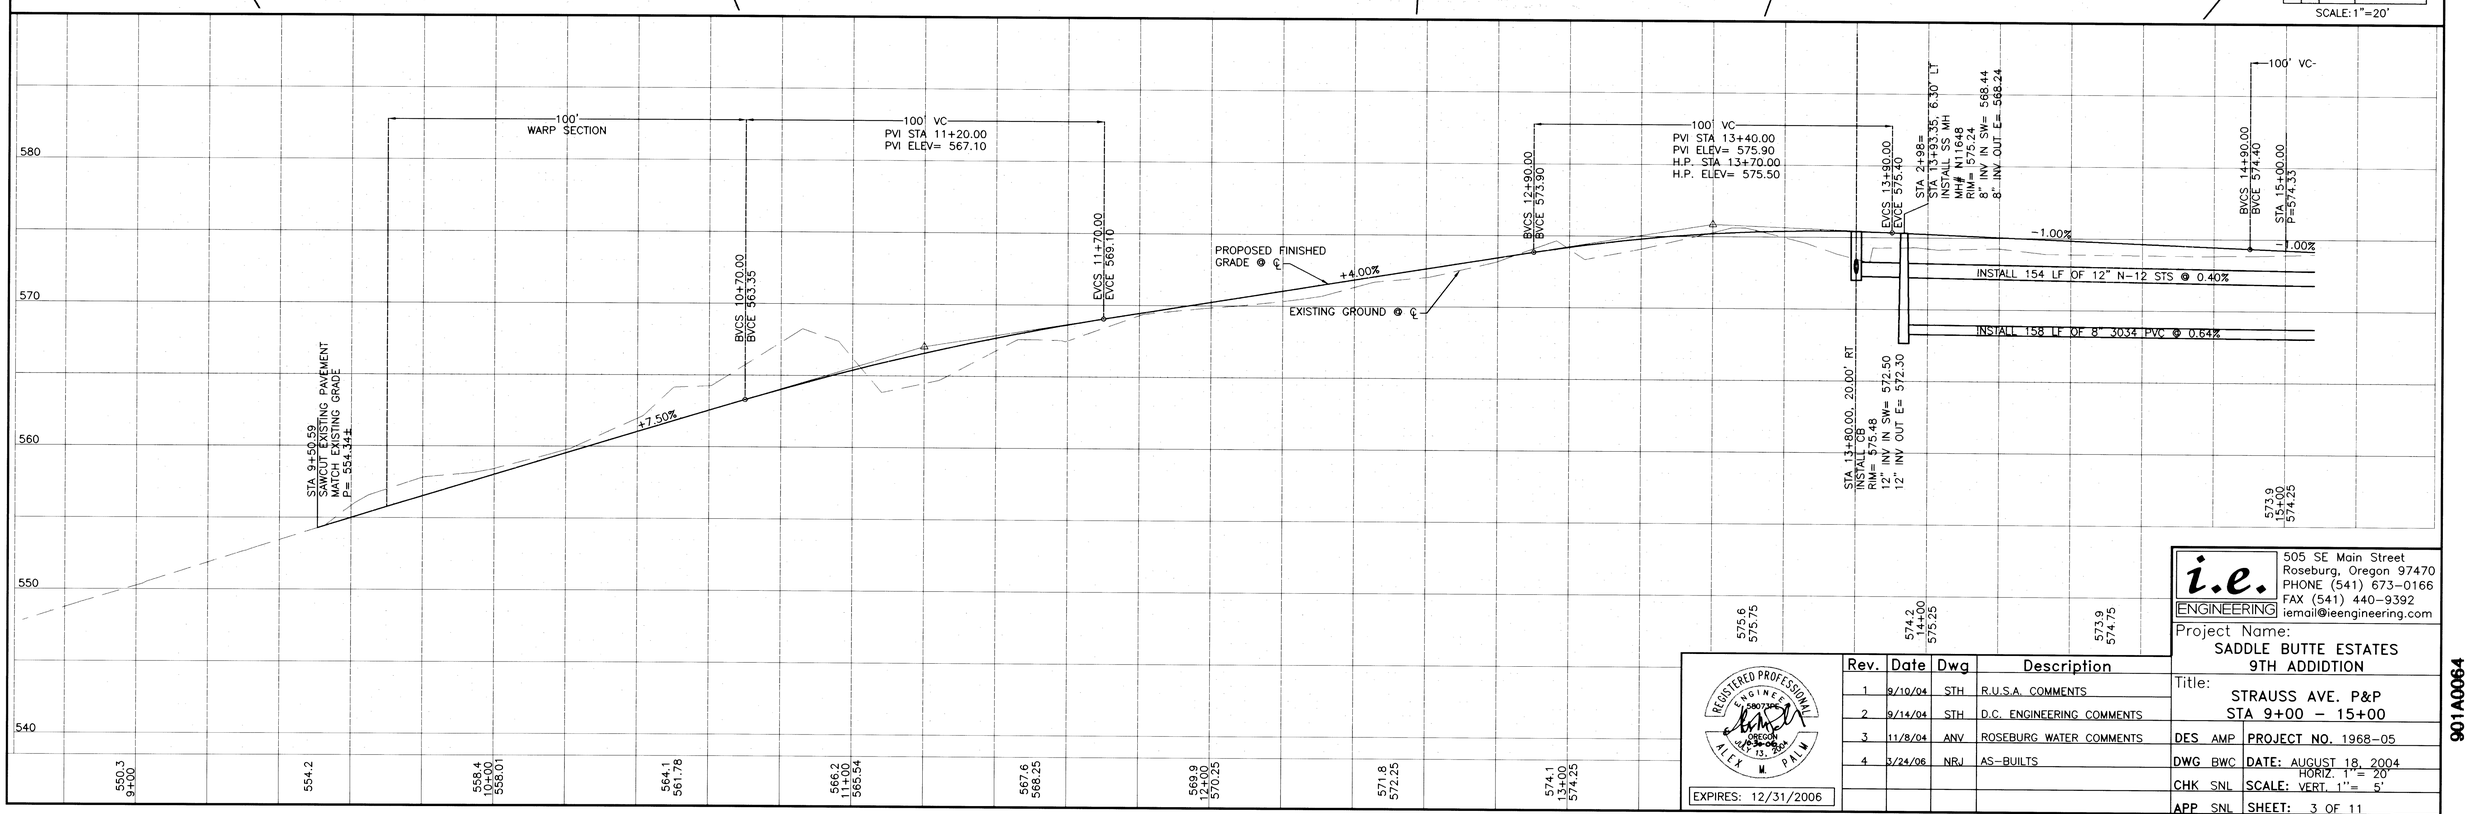

EXPIRES: 12/31/2006

Rev.	Date	Dwg	Description
1	9/10/04	STH	R.U.S.A. COMMENTS
2	9/14/04	STH	D.C. ENGINEERING COMMENTS
3	11/8/04	ANV	ROSEBURG WATER COMMENTS
4	3/24/06	NRJ	AS-BUILTS

i.e. ENGINEERING
505 SE Main Street
Roseburg, Oregon 97470
PHONE (541) 673-0166
FAX (541) 440-9392
iemail@ieengineering.com

Project Name: SADDLE BUTTE ESTATES 9TH ADDIDTION
Title: STRAUSS AVE. P&P STA 9+00 – 15+00

DES	AMP	PROJECT NO.	1968-05
DWG	BWC	DATE:	AUGUST 18, 2004
CHK	SNL	SCALE:	HORIZ. 1" = 20' VERT. 1" = 5'
APP	SNL	SHEET:	3 OF 11

DO NOT DUPLICATE

901A0064

Co. Rd. # 901A M.P. 0.64 – 0.74

CO. RD. #901A PLAN & PROFILE