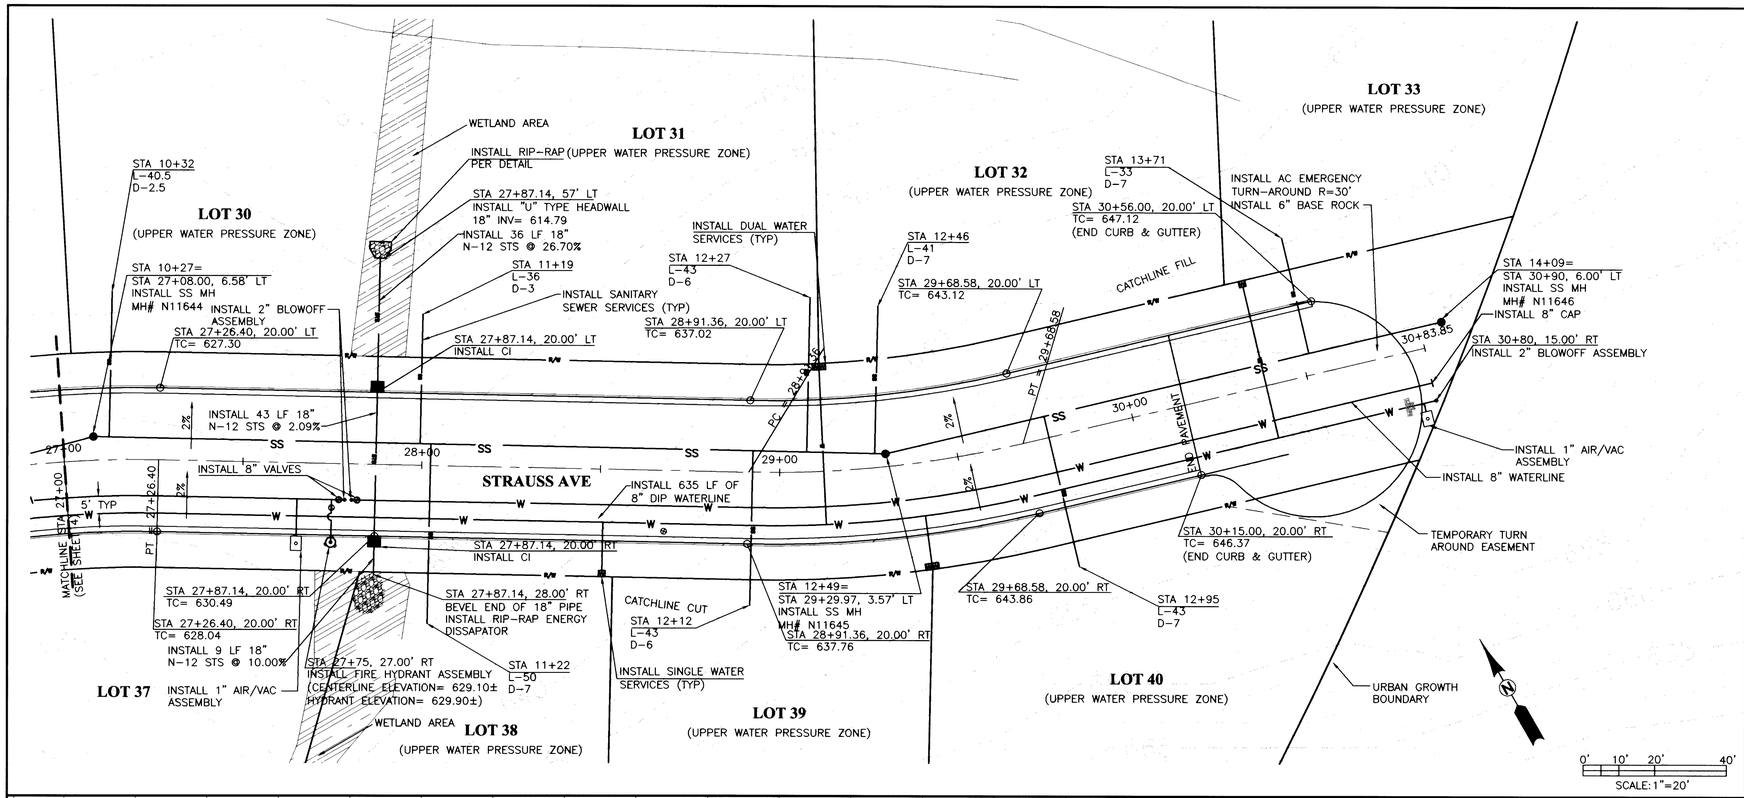

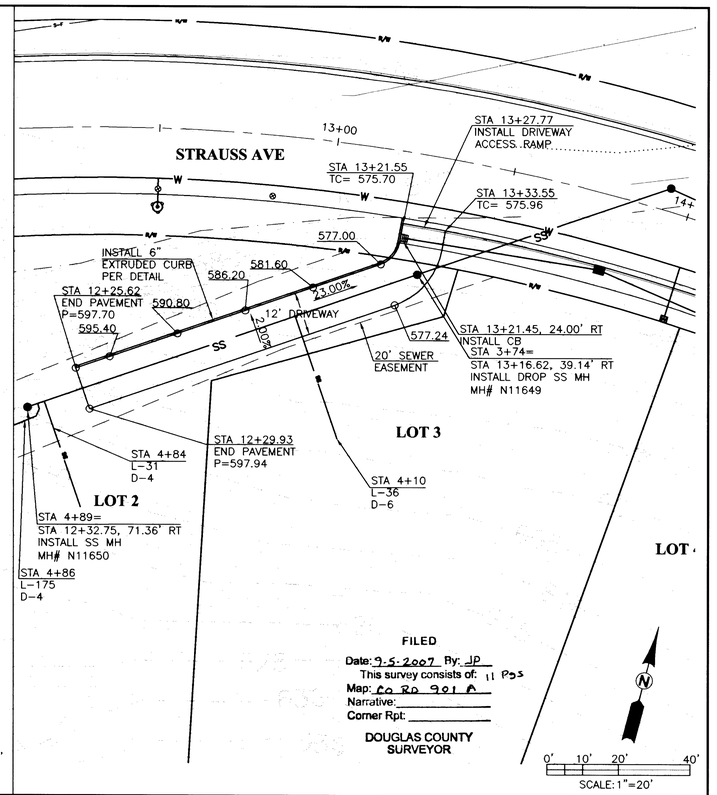

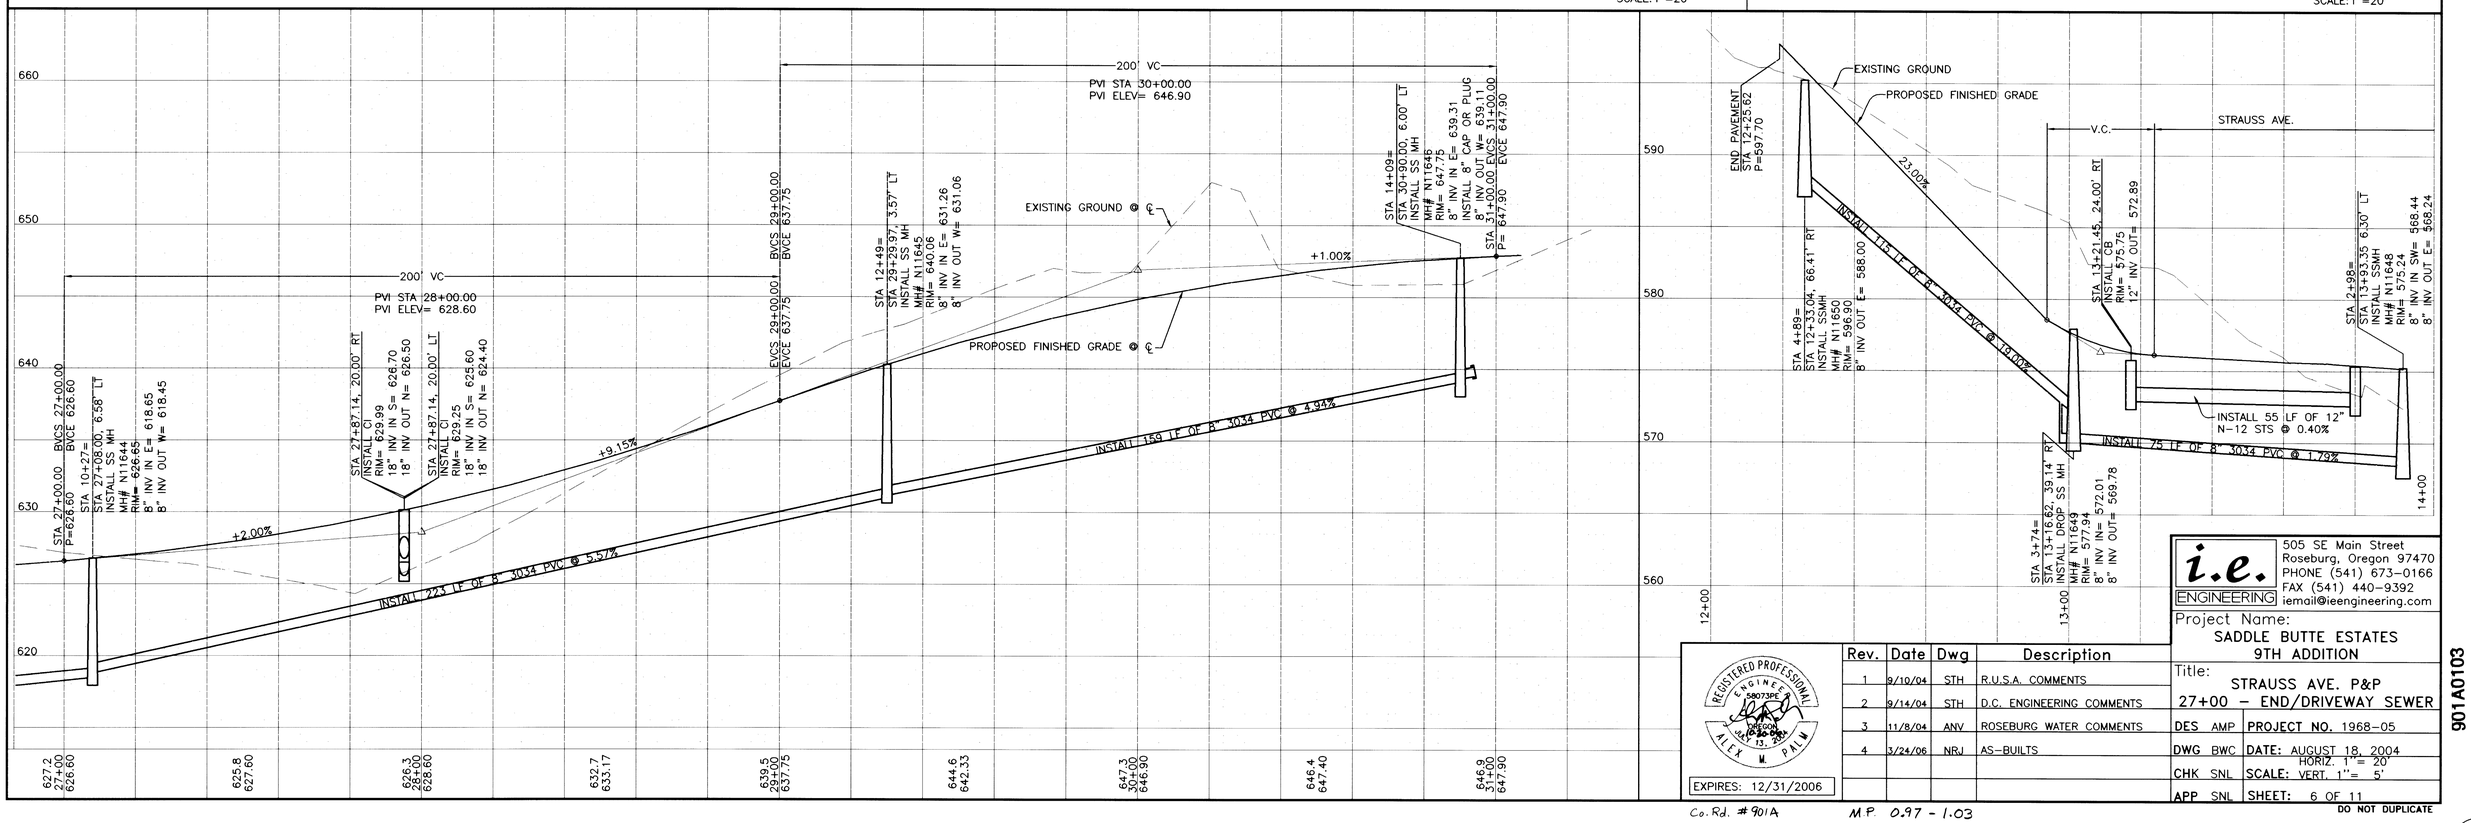

i.e. ENGINEERING
505 SE Main Street
Roseburg, Oregon 97470
PHONE (541) 673-0166
FAX (541) 440-9392
iemail@ieengineering.com

Project Name:
SADDLE BUTTE ESTATES
9TH ADDITION

Title:
STRAUSS AVE. P&P
27+00 – END/DRIVEWAY SEWER

Rev.	Date	Dwg	Description
1	9/10/04	STH	R.U.S.A. COMMENTS
2	9/14/04	STH	D.C. ENGINEERING COMMENTS
3	11/8/04	ANV	ROSEBURG WATER COMMENTS
4	3/24/06	NRJ	AS-BUILTS

DES AMP | PROJECT NO. 1968-05
DWG BWC | DATE: AUGUST 18, 2004
CHK SNL | SCALE: HORIZ. 1" = 20' VERT. 1" = 5'
APP SNL | SHEET: 6 OF 11

REGISTERED PROFESSIONAL ENGINEER 58073PE OREGON ALEX M. PALM
EXPIRES: 12/31/2006

DO NOT DUPLICATE

901A0103

Co. Rd. #901A M.P. 0.97 - 1.03

CO. RD. #901A PLAN & PROFILE