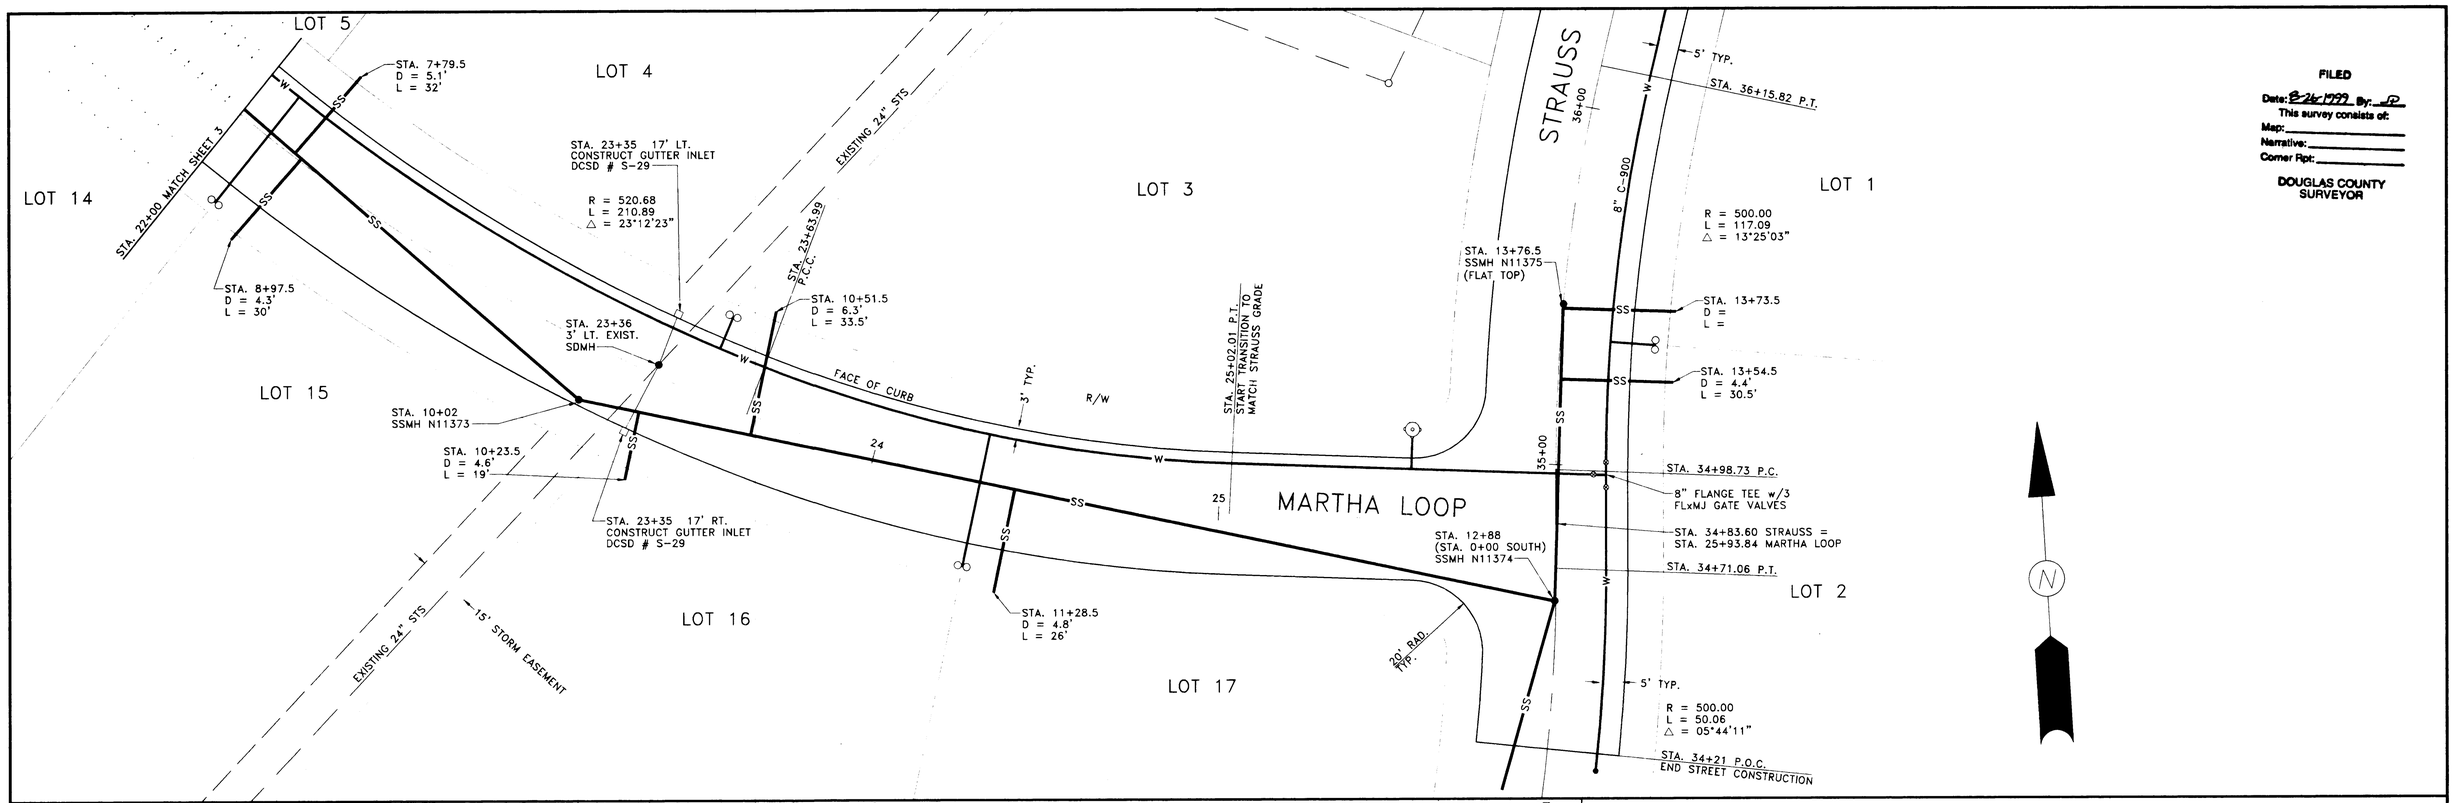

FILED
Date: 8-26-1999 By: R
This survey consists of:
Map:
Narrative:
Corner Rpt:
DOUGLAS COUNTY SURVEYOR

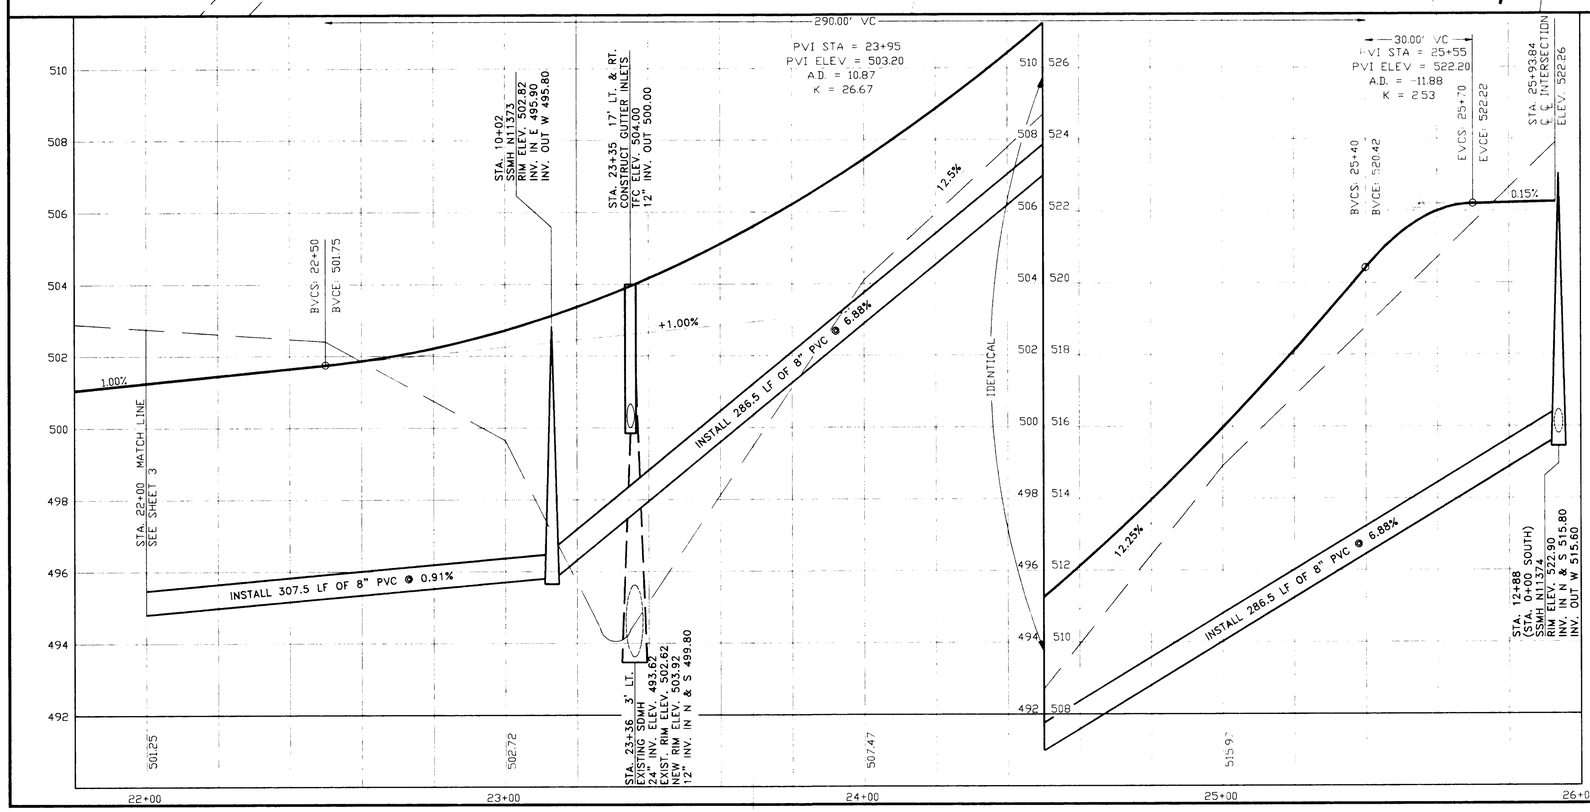

STAMP MUST BE SEALED
REGISTERED PROFESSIONAL ENGINEER
OREGON
JULY 17, 1987
MIKE A. PARKER
EXPIRES 12/31/96

Rev.	Date	Dwg	Description
1	7/10/95		AGENCY REVIEWS
2	12/27/95		AS-BUILTS

i.e. ENGINEERING
548 SE Jackson Street
Roseburg, Oregon 97470
PHONE (503) 673-0166
FAX (503) 440-9392

Project Name:
SADDLE BUTTE ESTATES
6TH ADDITION

Title:
PLAN AND PROFILE

DES	SNL	PROJECT NO.	140-14
DWG	DAF	DATE:	JUNE, 1995
CHK	MAP	SCALE:	1" = 20'
APP	MAP	SHEET	4 OF 8

901CPROF

901CPROJ
CO. RD. # 901 C