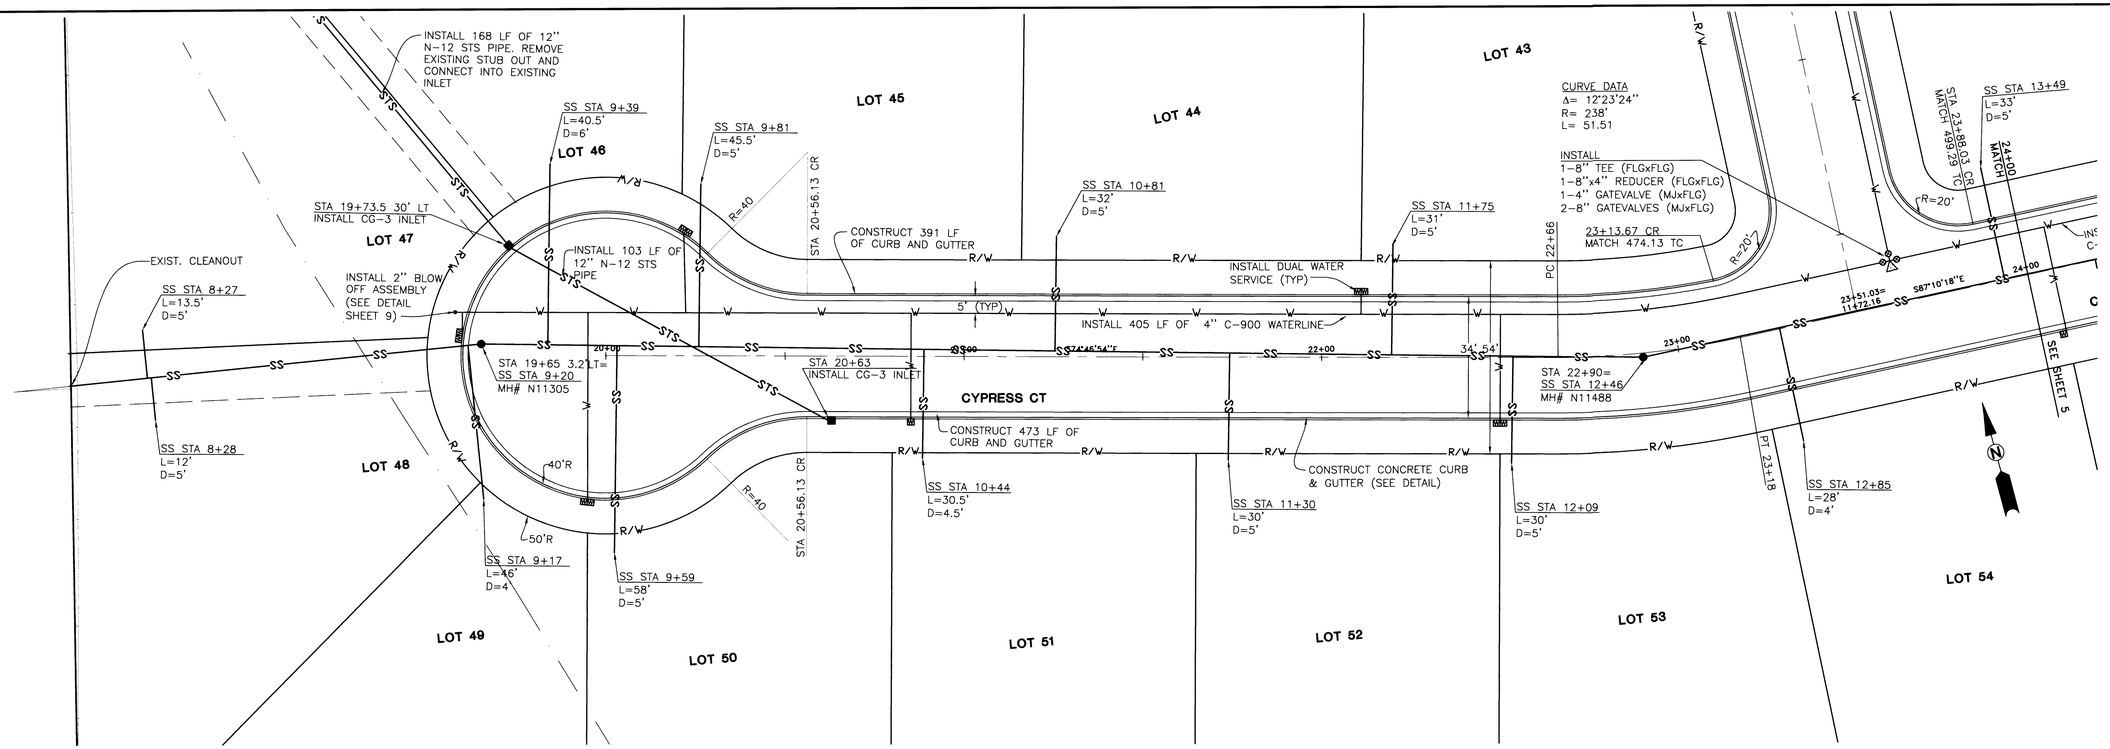

FILED
Date: 1/2/2003 By: JP
This survey consists of:
Map: ____
Narrative: ____
Corner Rpt: ____
DOUGLAS COUNTY SURVEYOR

CALL BEFORE YOU DIG !
ONE CALL: (800) 332-2344
OAR 952-001-0010 THROUGH
OAR 952-001-0090

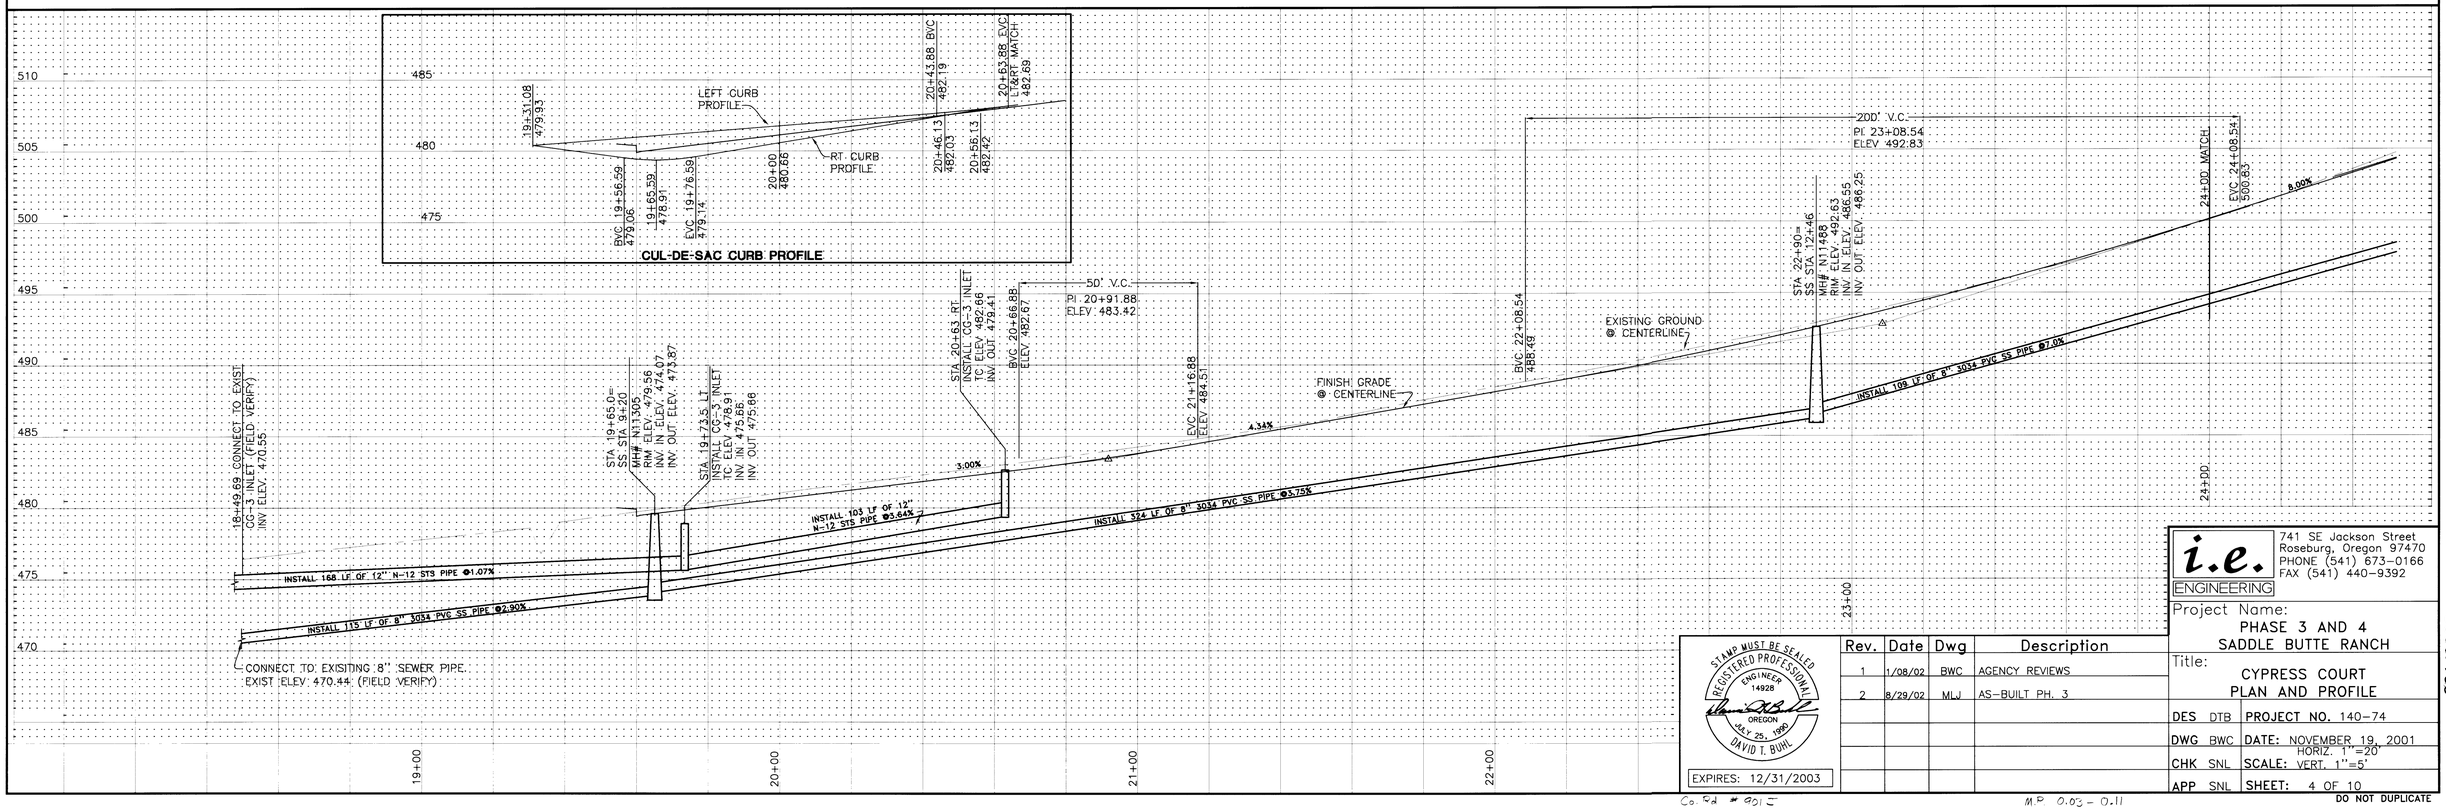

Rev.	Date	Dwg	Description
1	1/08/02	BWC	AGENCY REVIEWS
2	8/29/02	MLJ	AS-BUILT PH. 3

STAMP MUST BE SEALED
REGISTERED PROFESSIONAL ENGINEER 14928 OREGON JULY 25, 1990 DAVID T. BUHL
EXPIRES: 12/31/2003

i.e. ENGINEERING
741 SE Jackson Street
Roseburg, Oregon 97470
PHONE (541) 673-0166
FAX (541) 440-9392

Project Name:
PHASE 3 AND 4
SADDLE BUTTE RANCH

Title:
CYPRESS COURT
PLAN AND PROFILE

DES DTB	PROJECT NO. 140-74
DWG BWC	DATE: NOVEMBER 19, 2001
CHK SNL	SCALE: HORIZ. 1"=20' VERT. 1"=5'
APP SNL	SHEET: 4 OF 10

DO NOT DUPLICATE

901J0003

Co. Rd. # 901J M.P. 0.03 - 0.11

CO. RD. # 901J, PLAN & PROFILE