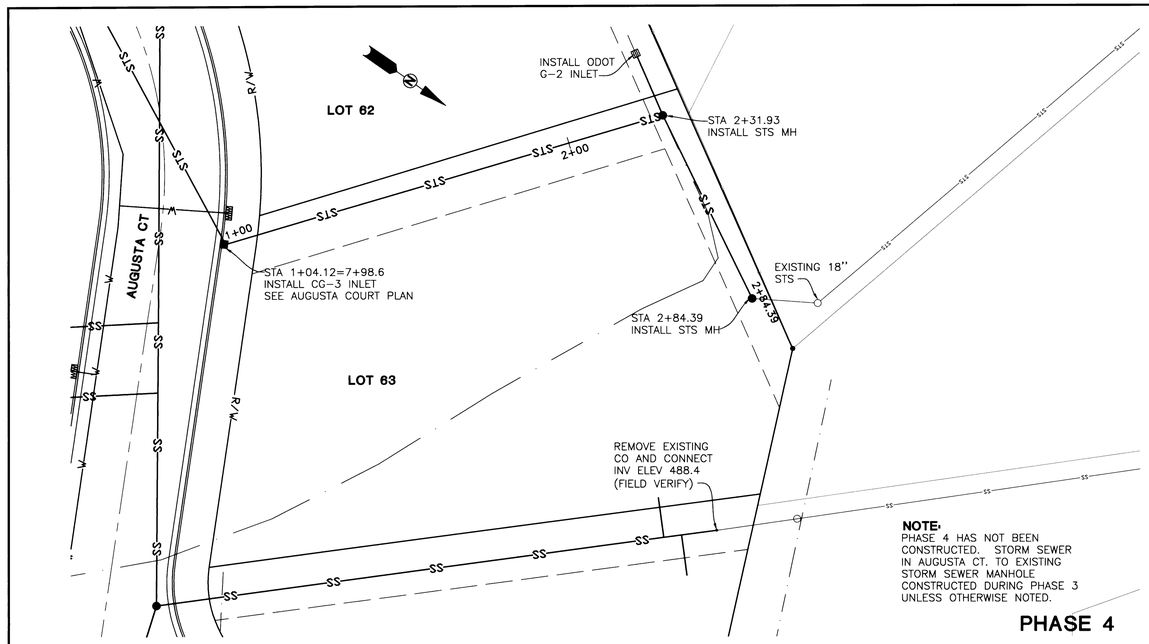

NOTE:
PHASE 4 HAS NOT BEEN CONSTRUCTED. STORM SEWER IN AUGUSTA CT. TO EXISTING STORM SEWER MANHOLE CONSTRUCTED DURING PHASE 3 UNLESS OTHERWISE NOTED.

PHASE 4

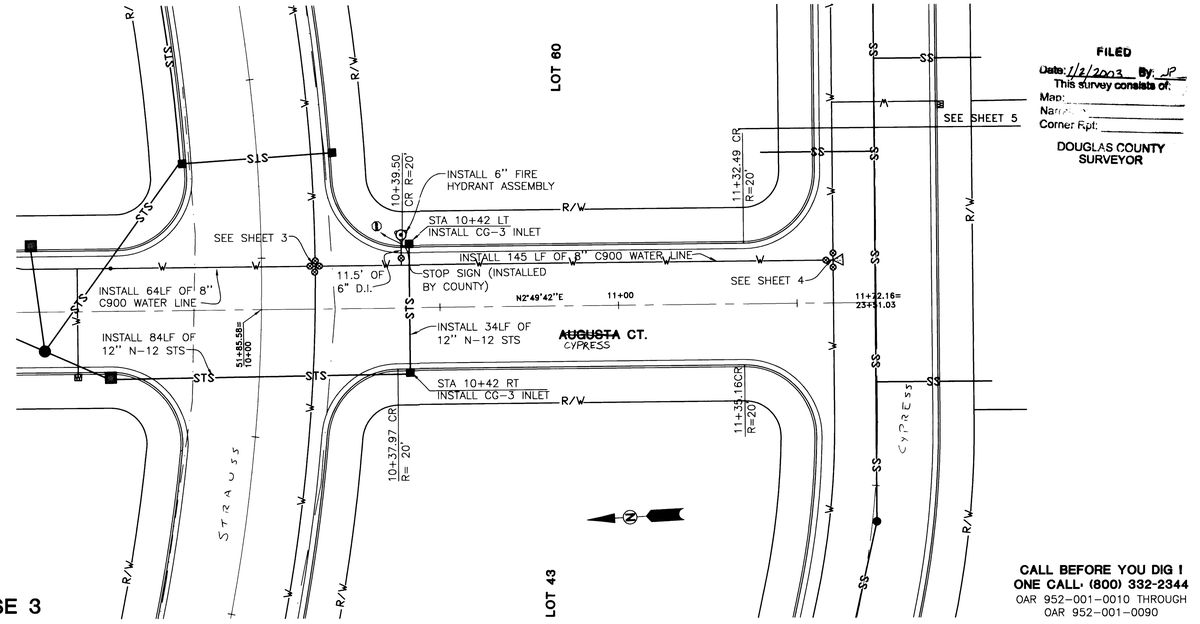

PHASE 3

FILED
Date: 1/2/2003 By: JP
This survey consists of:
Map:
Narr:
Corner Rpt:
DOUGLAS COUNTY SURVEYOR

CALL BEFORE YOU DIG !
ONE CALL· (800) 332-2344
OAR 952-001-0010 THROUGH
OAR 952-001-0090

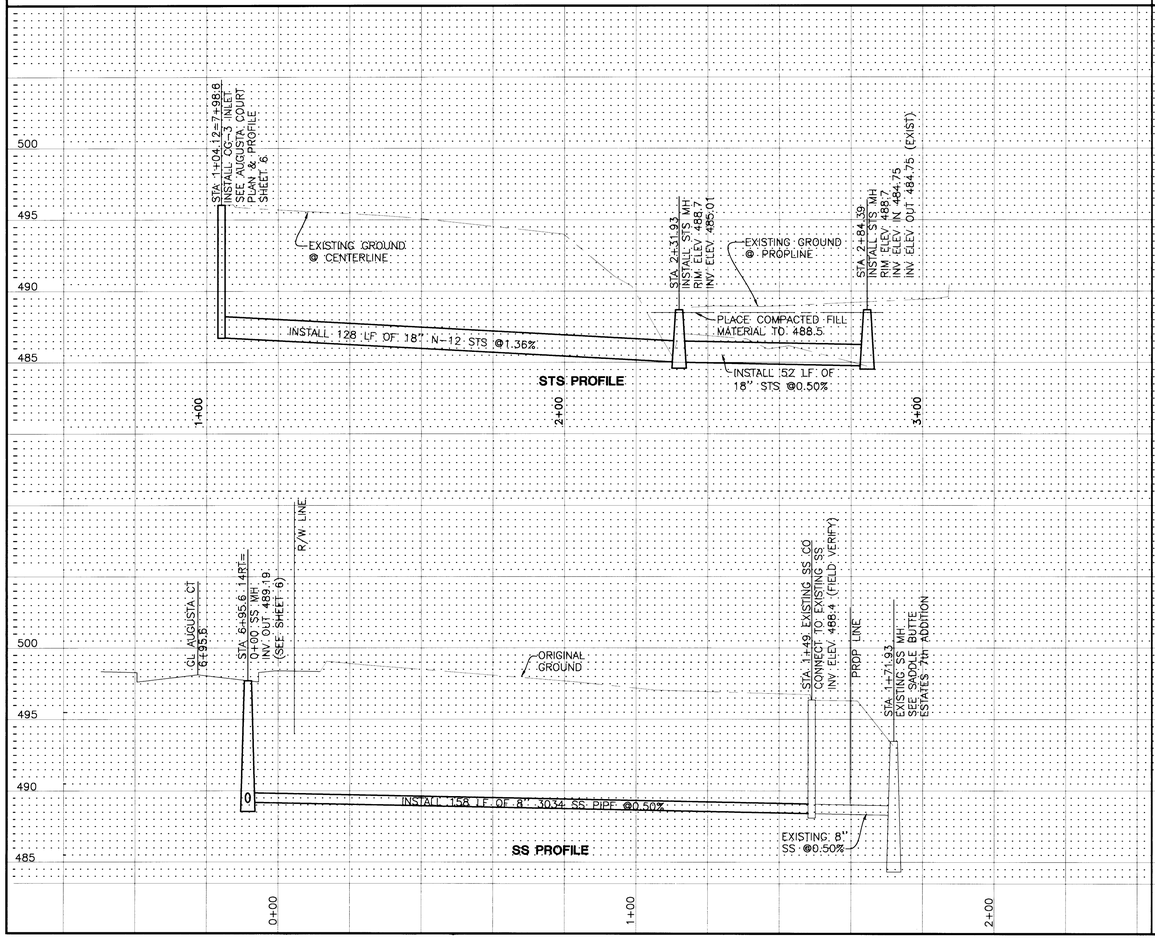

STS PROFILE

SS PROFILE

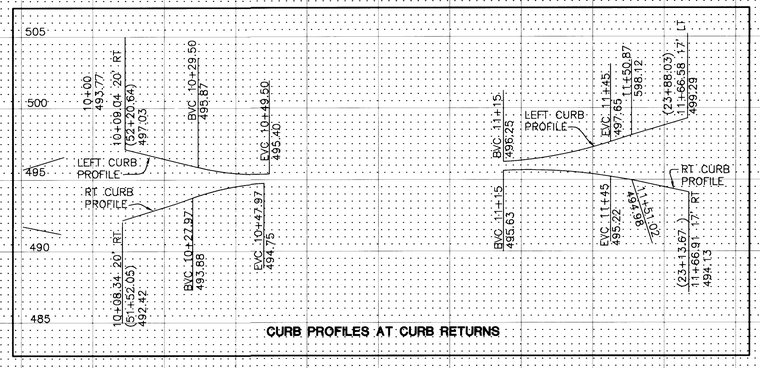

CURB PROFILES AT CURB RETURNS

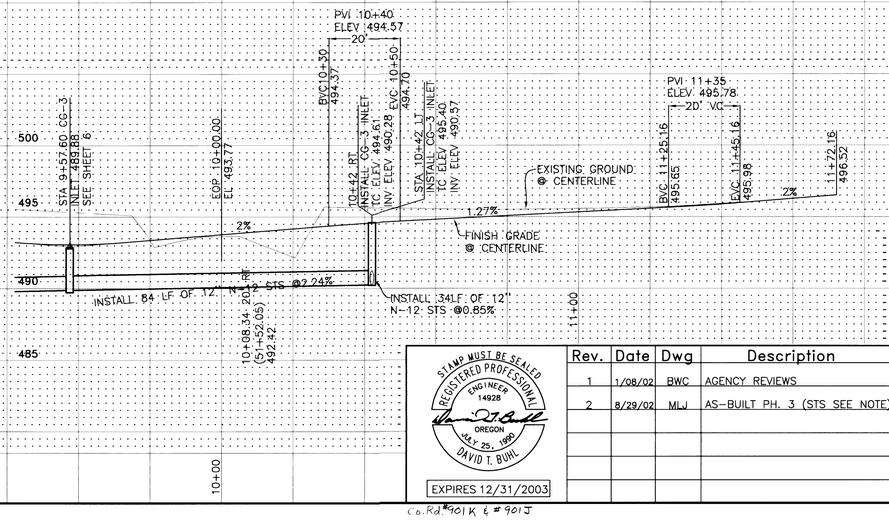

STAMP MUST BE SEALED
REGISTERED PROFESSIONAL ENGINEER
14928
OREGON
JULY 25, 1990
DAVID T. BUHL
EXPIRES 12/31/2003

Rev.	Date	Dwg	Description
1	1/08/02	BWC	AGENCY REVIEWS
2	8/29/02	MLJ	AS-BUILT PH. 3 (STS SEE NOTE)

i.e. ENGINEERING
741 SE Jackson Street
Roseburg, Oregon 97470
PHONE (541) 673-0166
FAX (541) 440-9392

Project Name:
PHASE 3 AND 4
SADDLE BUTTE RANCH

Title:
AUGUSTA COURT SOUTH
PLAN AND PROFILE

DES	DTB	PROJECT NO.	140-74
DWG	BWC	DATE:	NOVEMBER 19, 2001
CHK	SNL	SCALE:	HORIZ. 1"= 20 VERT. 1"= 5
APP	SNL	SHEET	7 OF 10

DO NOT DUPLICATE

901JKSEW

Co.Rd.#901K & #901J

CO. RD. # 901K & #901J PLAN & PROFILE