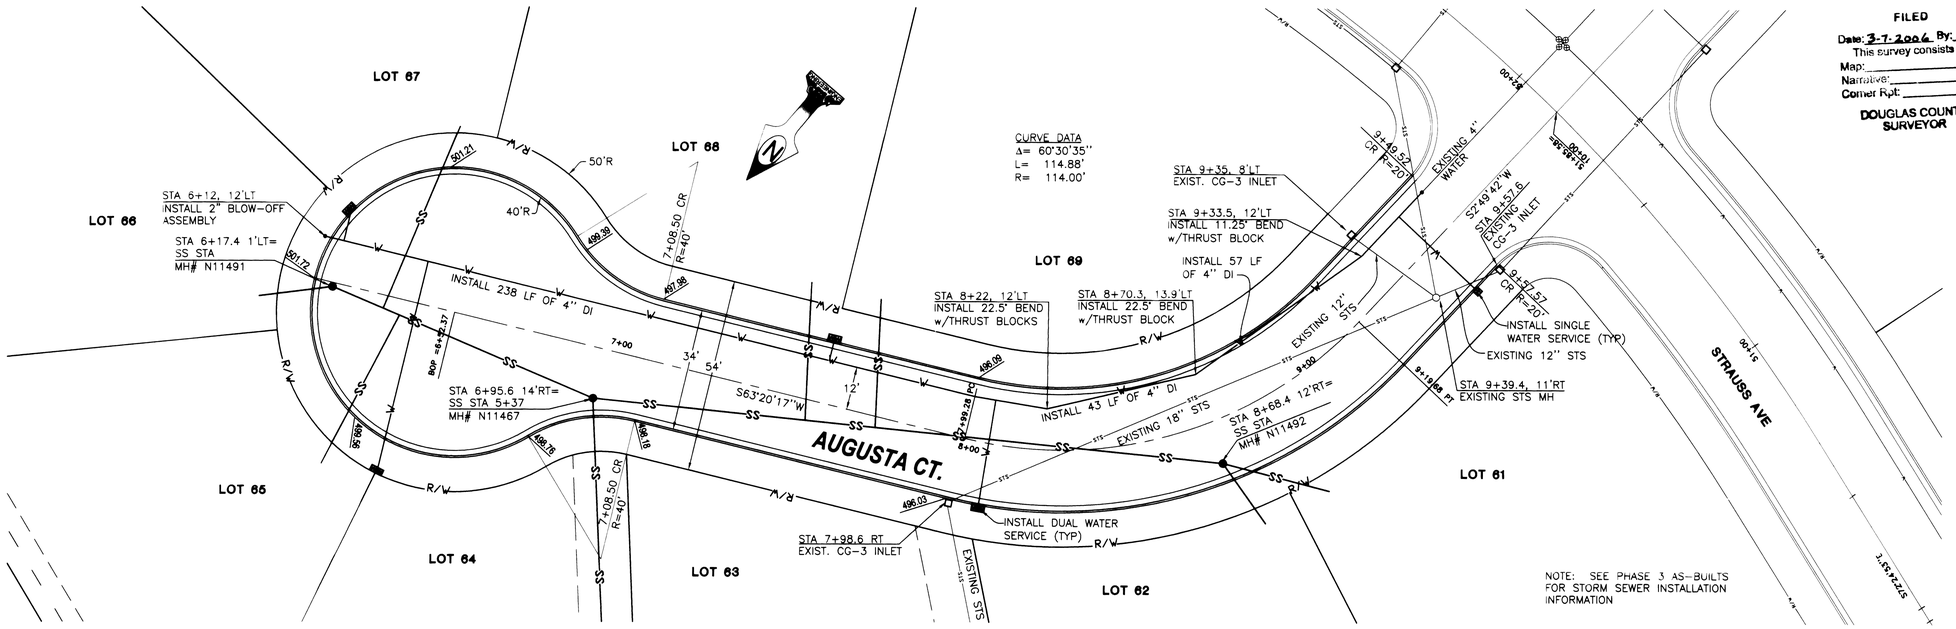

FILED
Date: 3-7-2006 By: JP
This survey consists of:
Map: ____
Narrative: ____
Corner Rpt: ____
DOUGLAS COUNTY SURVEYOR

NOTE: SEE PHASE 3 AS-BUILTS FOR STORM SEWER INSTALLATION INFORMATION

THESE DRAWINGS REPRESENT THE ACTUAL CONSTRUCTION OF ***SADDLE BUTTE PHASE 4 AUGUSTA COURT*** DESIGNED BY i.e. ENGINEERING, INC. NOVEMBER 2001.
WE HERE BY CERTIFY THAT, TO THE BEST OF OUR KNOWLEDGE, THE WORK WAS PERFORMED IN ACCORDANCE WITH THE PLANS & SPECIFICATIONS.

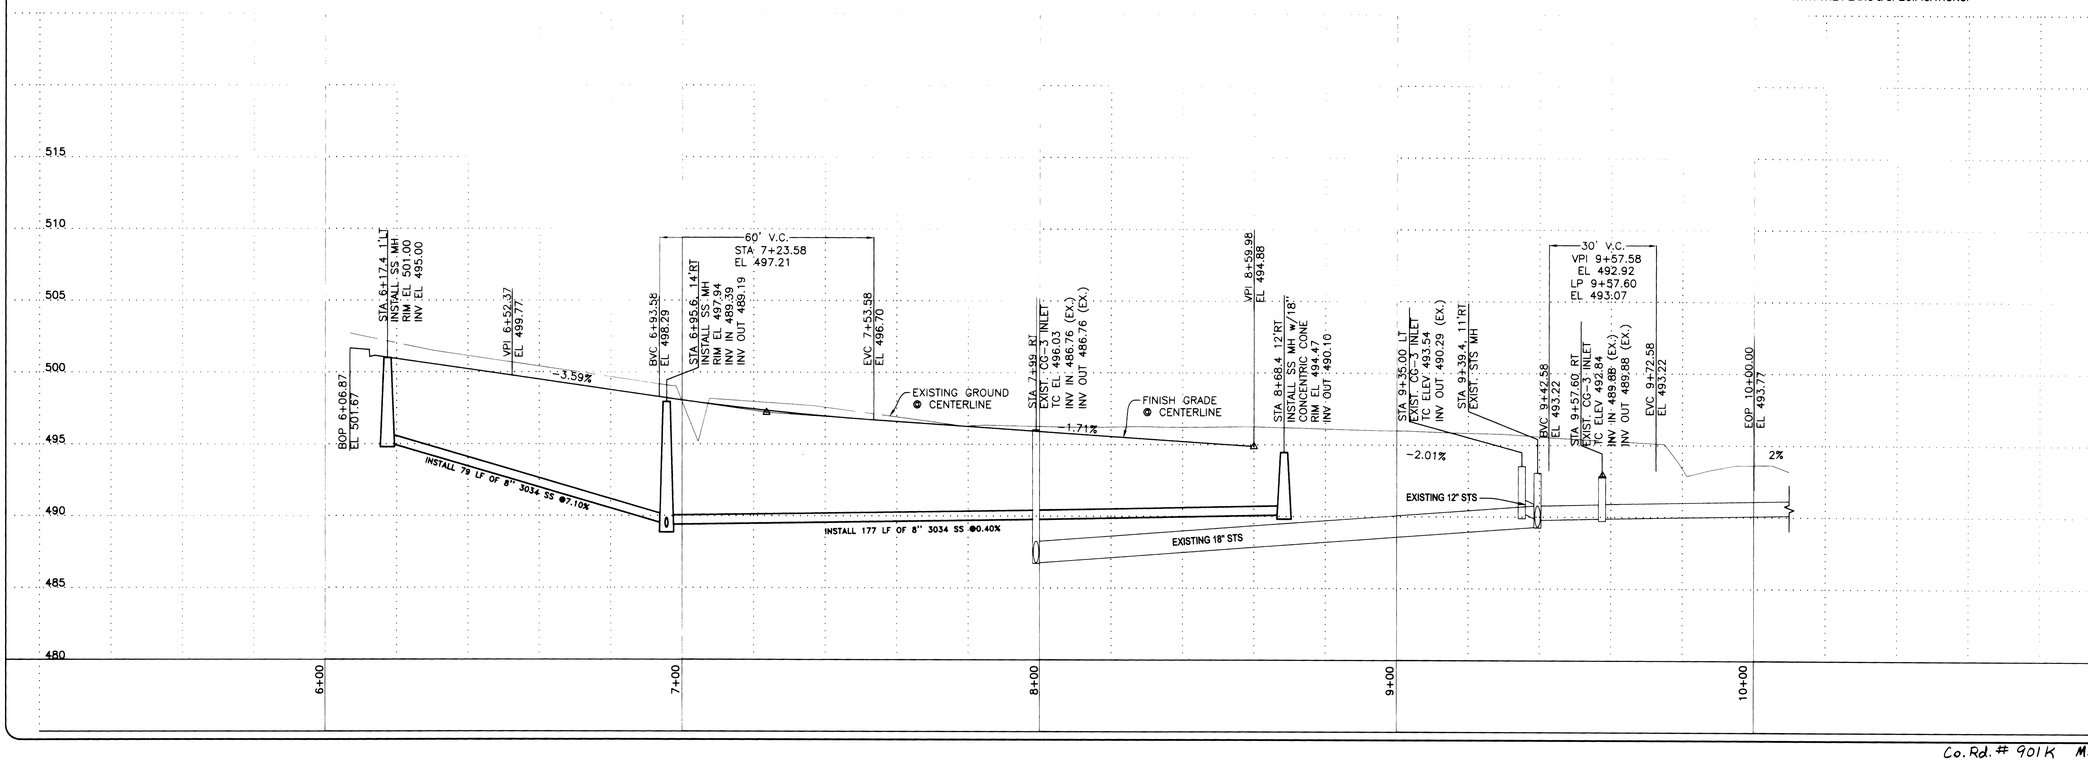

STAMP MUST BE SEALED
REGISTERED PROFESSIONAL ENGINEER
11304
OREGON
JULY 17, 1997
MIKE A. PARKER
EXPIRATION DATE: 12/31/04

MAP Engineering, Inc.
740 MAIN STREET
ROSEBURG, OREGON 97470
PHONE: (541) 229-0365 FAX: (541) 229-0353
EMAIL: info@mapengineeringinc.com

PROJECT NAME: **SADDLE BUTTE PHASE 4 AUGUSTA COURT**

DRAWING TITLE: **PLAN & PROFILE RECORD DRAWINGS**

PROJECT NO.: 152-01 DWG SCALE: 1"= 20' DATE: OCTOBER 2004 DESIGNER: N/A DRAFTER: N/A APPROVAL: N/A

REVISION #:	BY:	DATE:

SHEET: 2 OF: 3

00000007

Co. Rd. # 901K M.P. 0.00 - 0.07