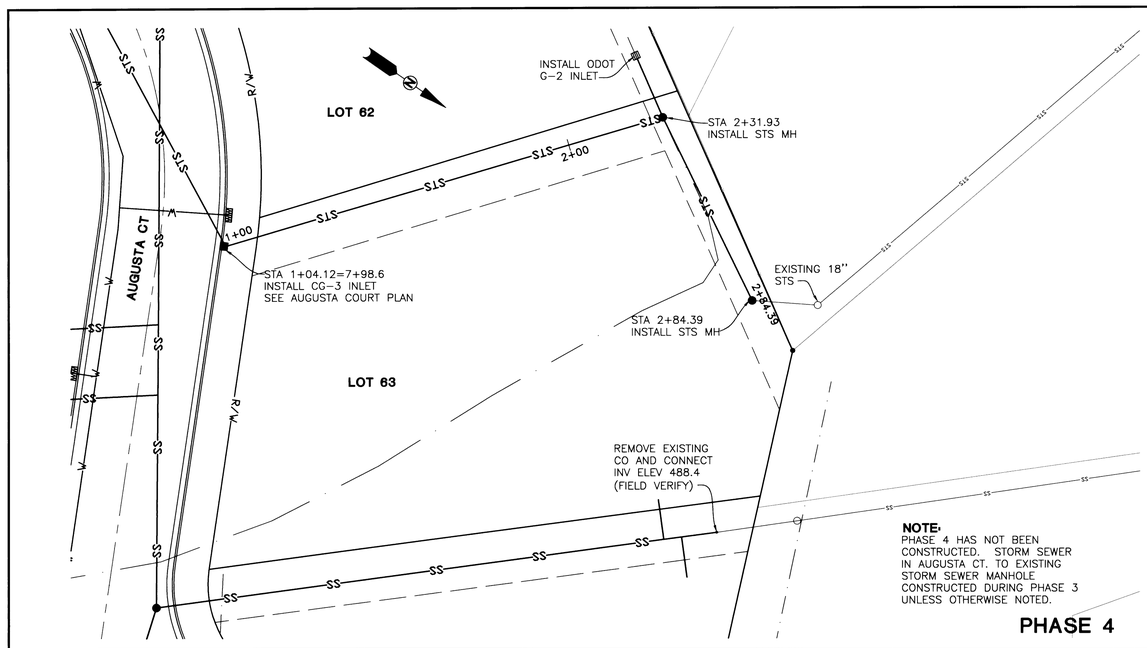

PHASE 4

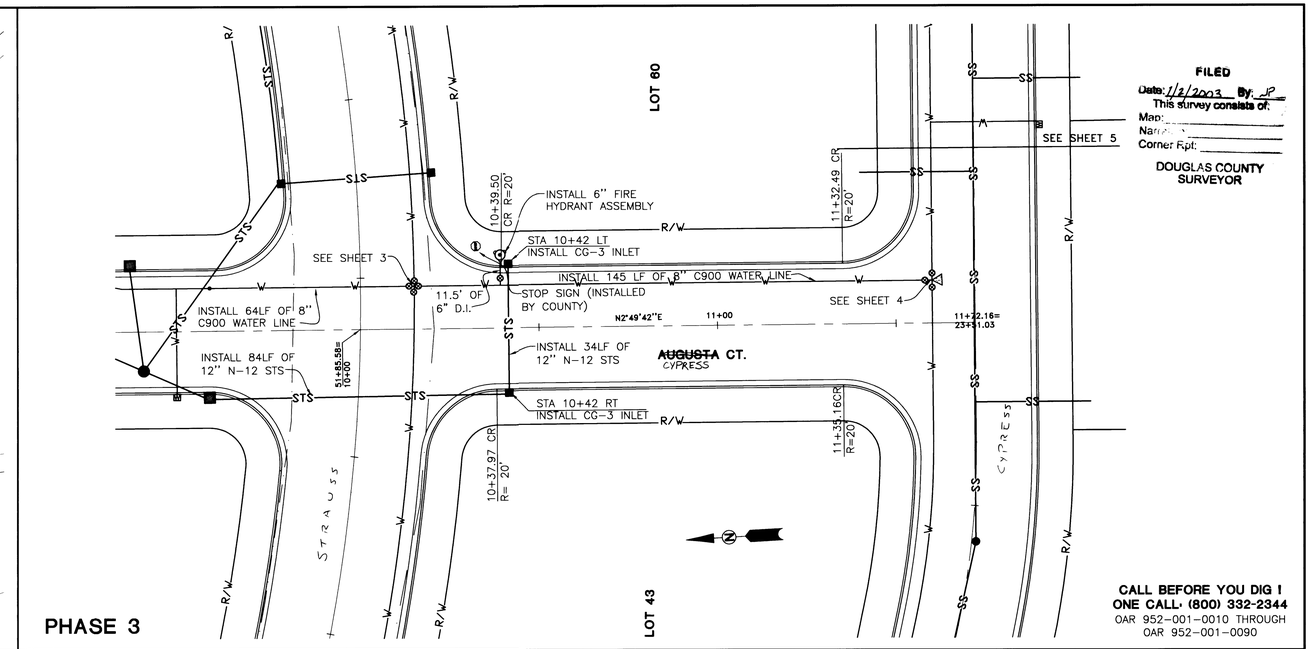

PHASE 3

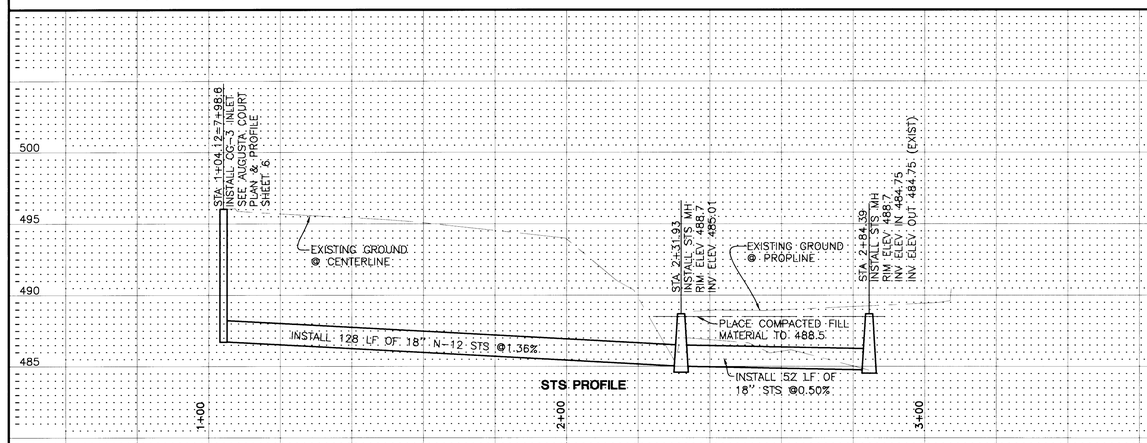

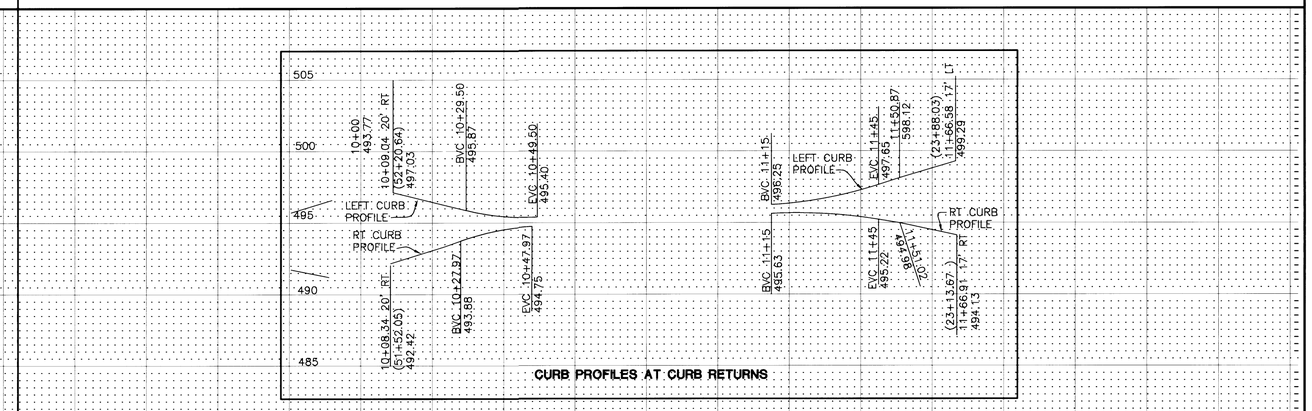

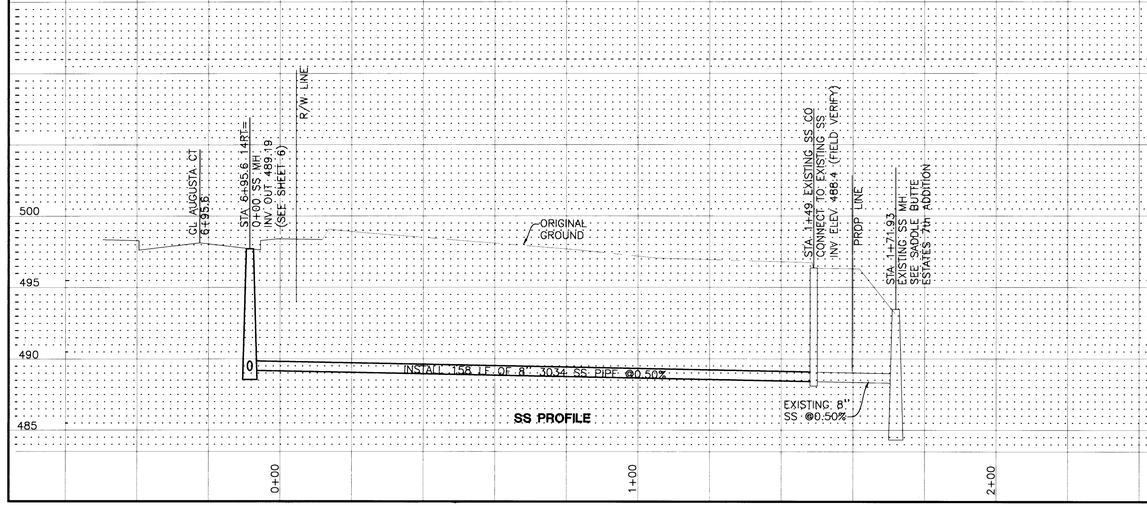

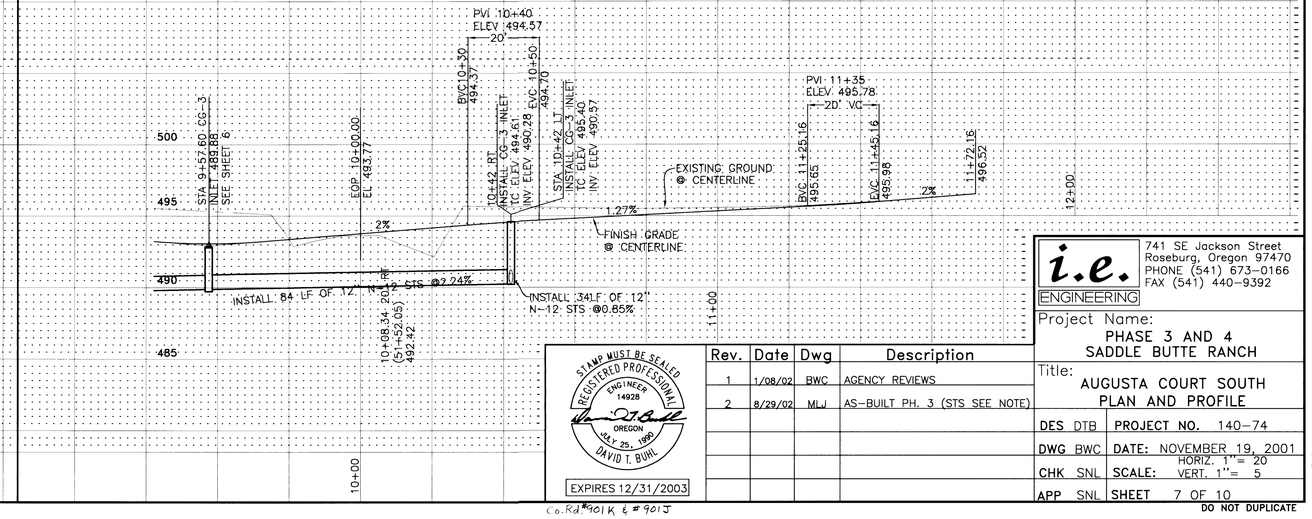

STAMP MUST BE SEALED
REGISTERED PROFESSIONAL ENGINEER 14928 OREGON MAY 25, 1990 DAVID T. BUHL
EXPIRES 12/31/2003

Rev.	Date	Dwg	Description
1	1/08/02	BWC	AGENCY REVIEWS
2	8/29/02	MLJ	AS-BUILT PH. 3 (STS SEE NOTE)

i.e. ENGINEERING
741 SE Jackson Street
Roseburg, Oregon 97470
PHONE (541) 673-0166
FAX (541) 440-9392

Project Name: PHASE 3 AND 4 SADDLE BUTTE RANCH

Title: AUGUSTA COURT SOUTH PLAN AND PROFILE

DES DTB | PROJECT NO. 140-74
DWG BWC | DATE: NOVEMBER 19, 2001
CHK SNL | SCALE: HORIZ. 1"= 20 VERT. 1"= 5
APP SNL | SHEET 7 OF 10

DO NOT DUPLICATE

901JKSEW

Co.Rd #901K & #901J

CO. RD. # 901K & #901J PLAN & PROFILE