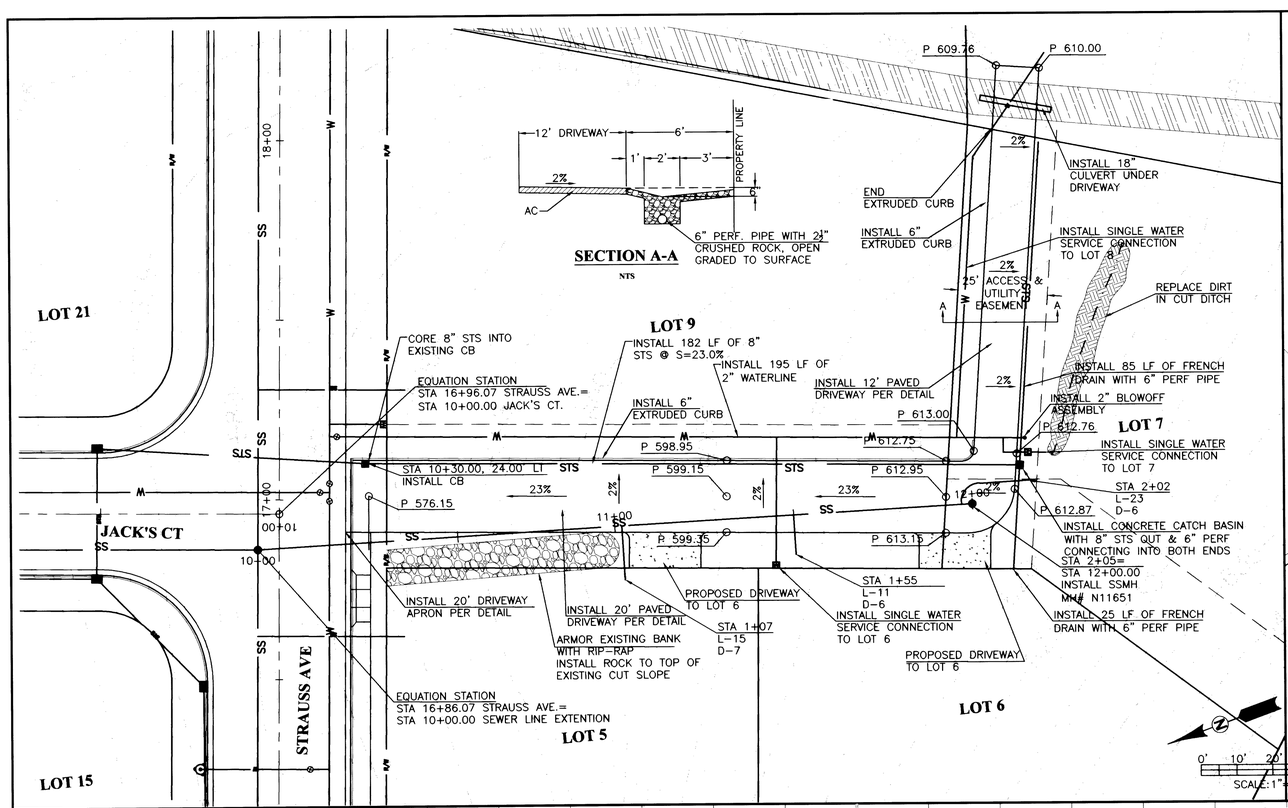


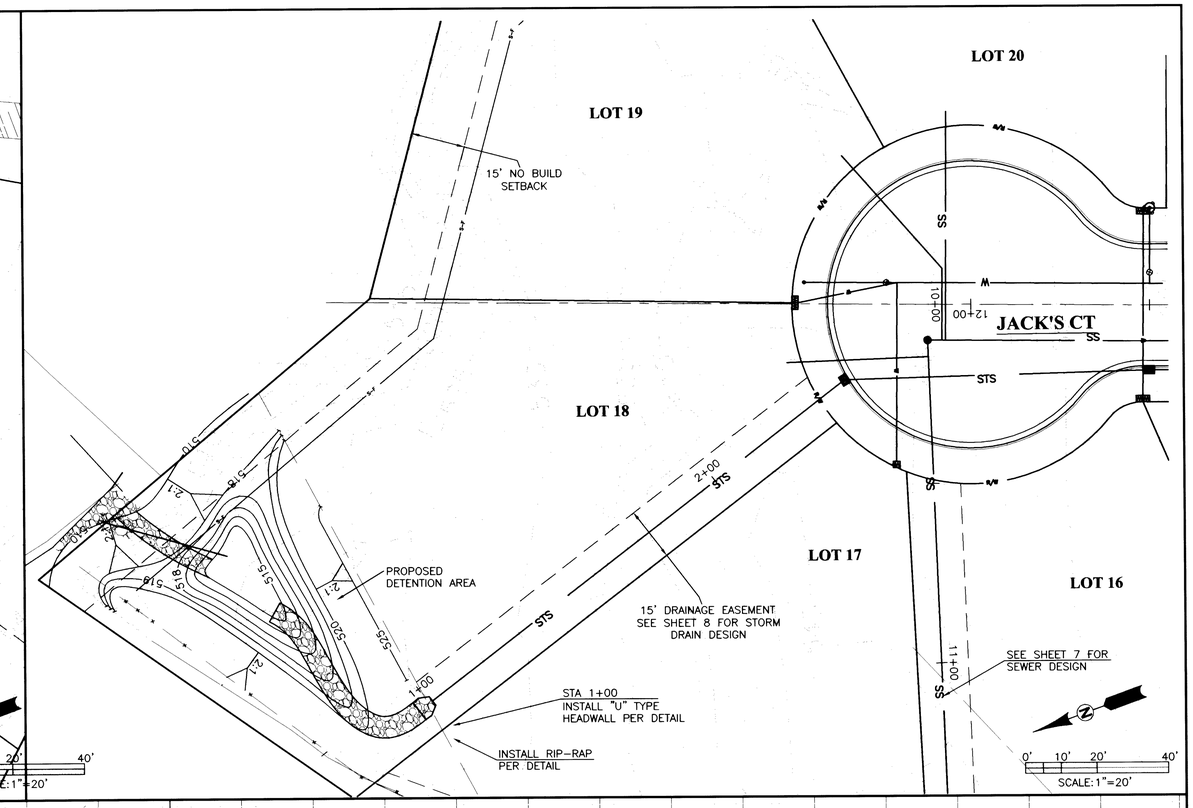


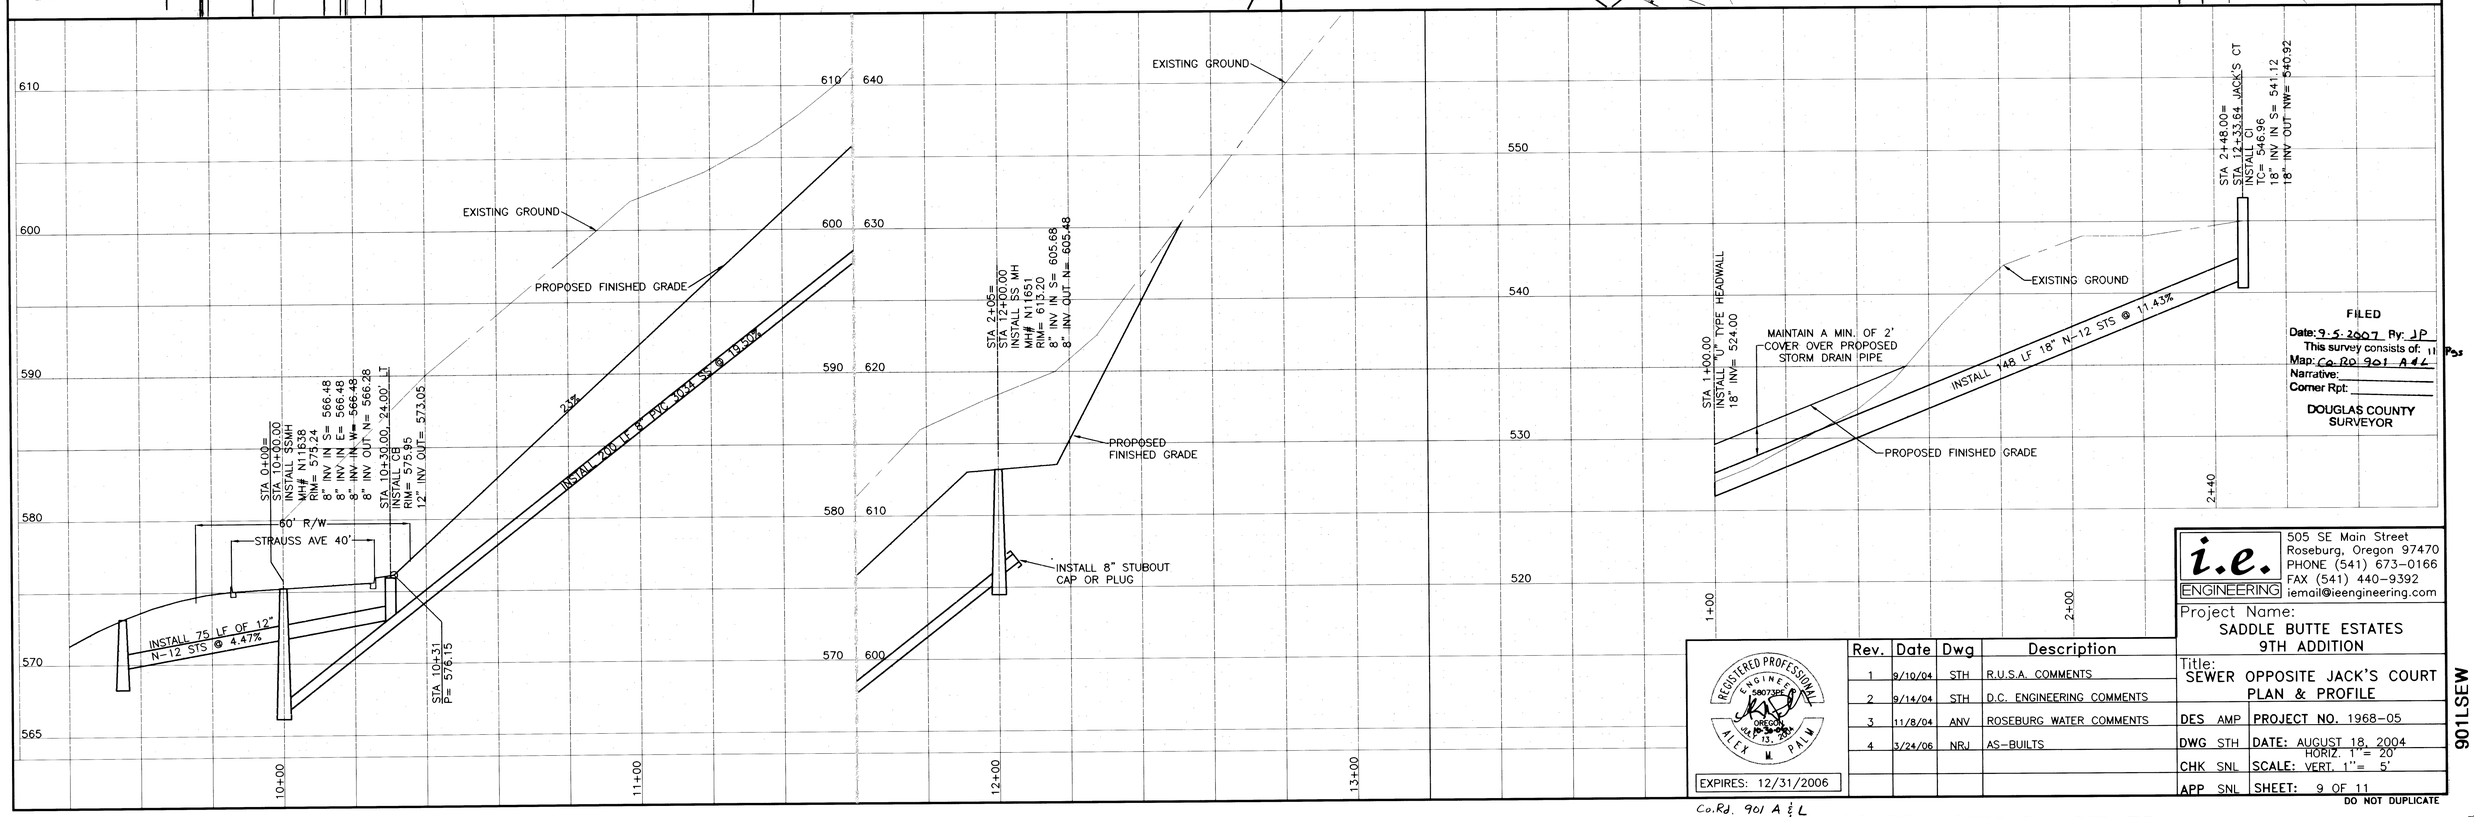


FILED
Date: 9-5-2007 By: JP
This survey consists of: 11
Map: Co. Rd. 901 A & L
Narrative:
Corner Rpt:
DOUGLAS COUNTY SURVEYOR


i.e. ENGINEERING
505 SE Main Street
Roseburg, Oregon 97470
PHONE (541) 673-0166
FAX (541) 440-9392
iemail@ieengineering.com


REGISTERED PROFESSIONAL ENGINEER 58073PE OREGON 10-13-2006 ALEX M. PAIN
EXPIRES: 12/31/2006

| Rev. | Date | Dwg | Description |
|---|---|---|---|
| 1 | 9/10/04 | STH | R.U.S.A. COMMENTS |
| 2 | 9/14/04 | STH | D.C. ENGINEERING COMMENTS |
| 3 | 11/8/04 | ANV | ROSEBURG WATER COMMENTS |
| 4 | 3/24/06 | NRJ | AS-BUILTS |

Project Name: SADDLE BUTTE ESTATES 9TH ADDITION

Title: SEWER OPPOSITE JACK'S COURT PLAN & PROFILE

DES AMP | PROJECT NO. 1968-05
DWG STH | DATE: AUGUST 18, 2004
CHK SNL | SCALE: HORIZ. 1" = 20' VERT. 1" = 5'
APP SNL | SHEET: 9 OF 11

DO NOT DUPLICATE

9O1LSEW

Co.Rd. 901 A & L

# CO. RD. #901A & L SEWER