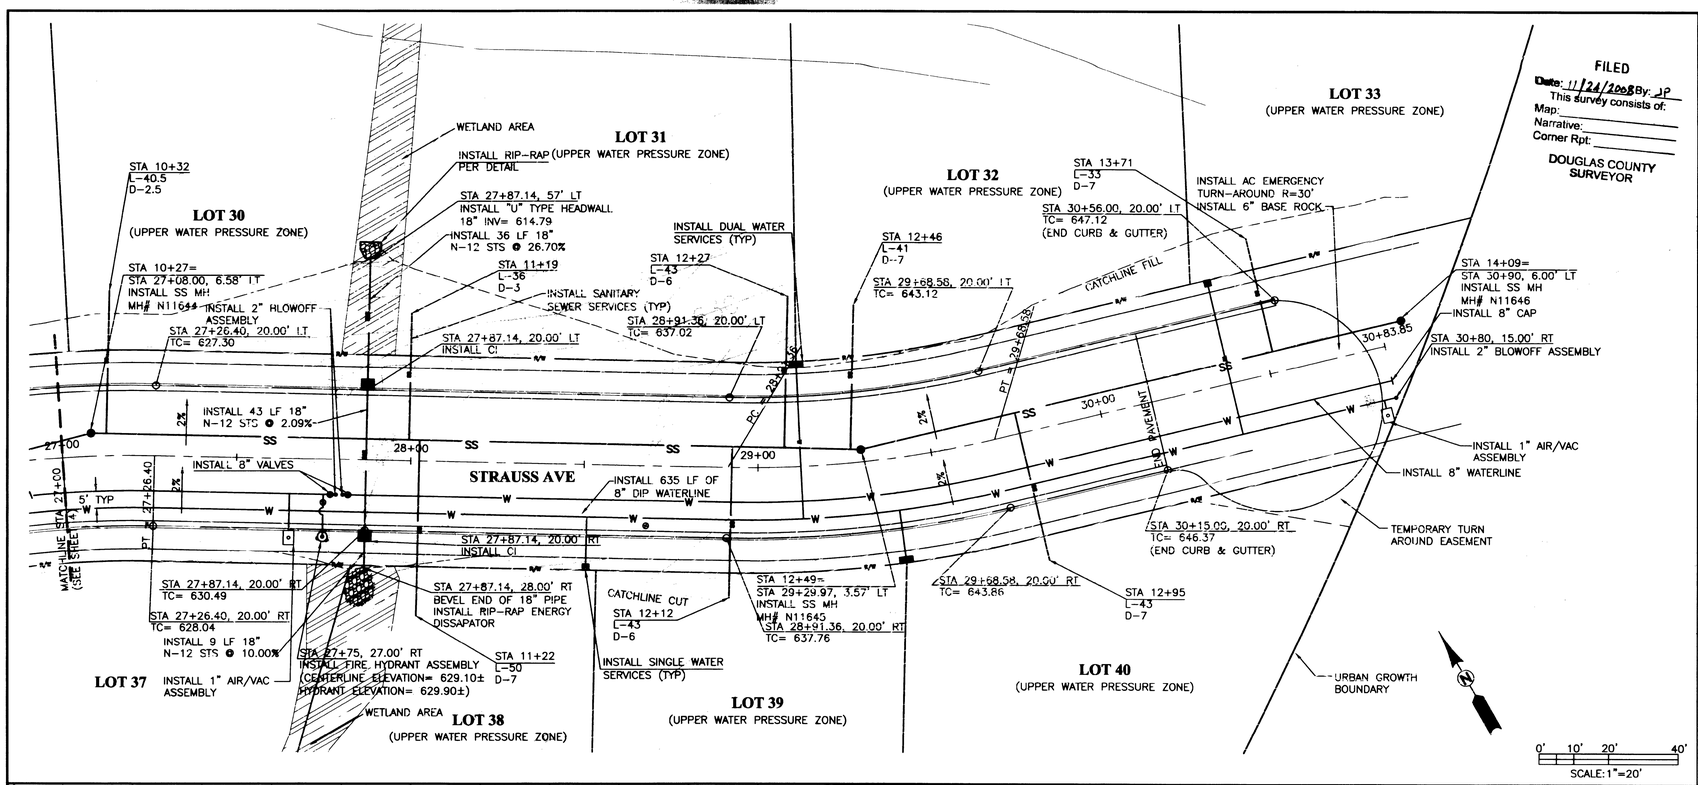

FILED
Date: 11/24/2008 By: JP
This survey consists of:
Map:
Narrative:
Corner Rpt:
DOUGLAS COUNTY SURVEYOR

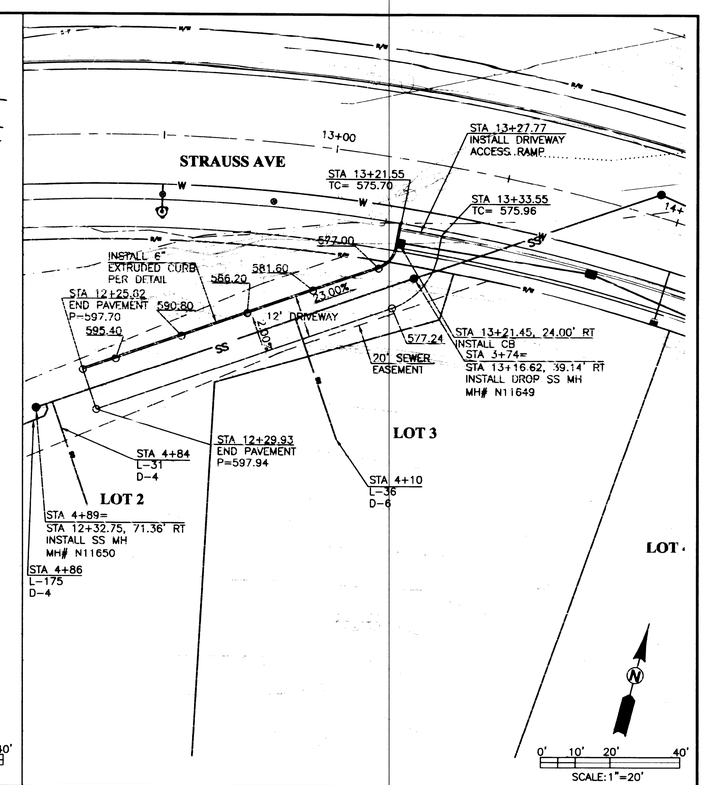

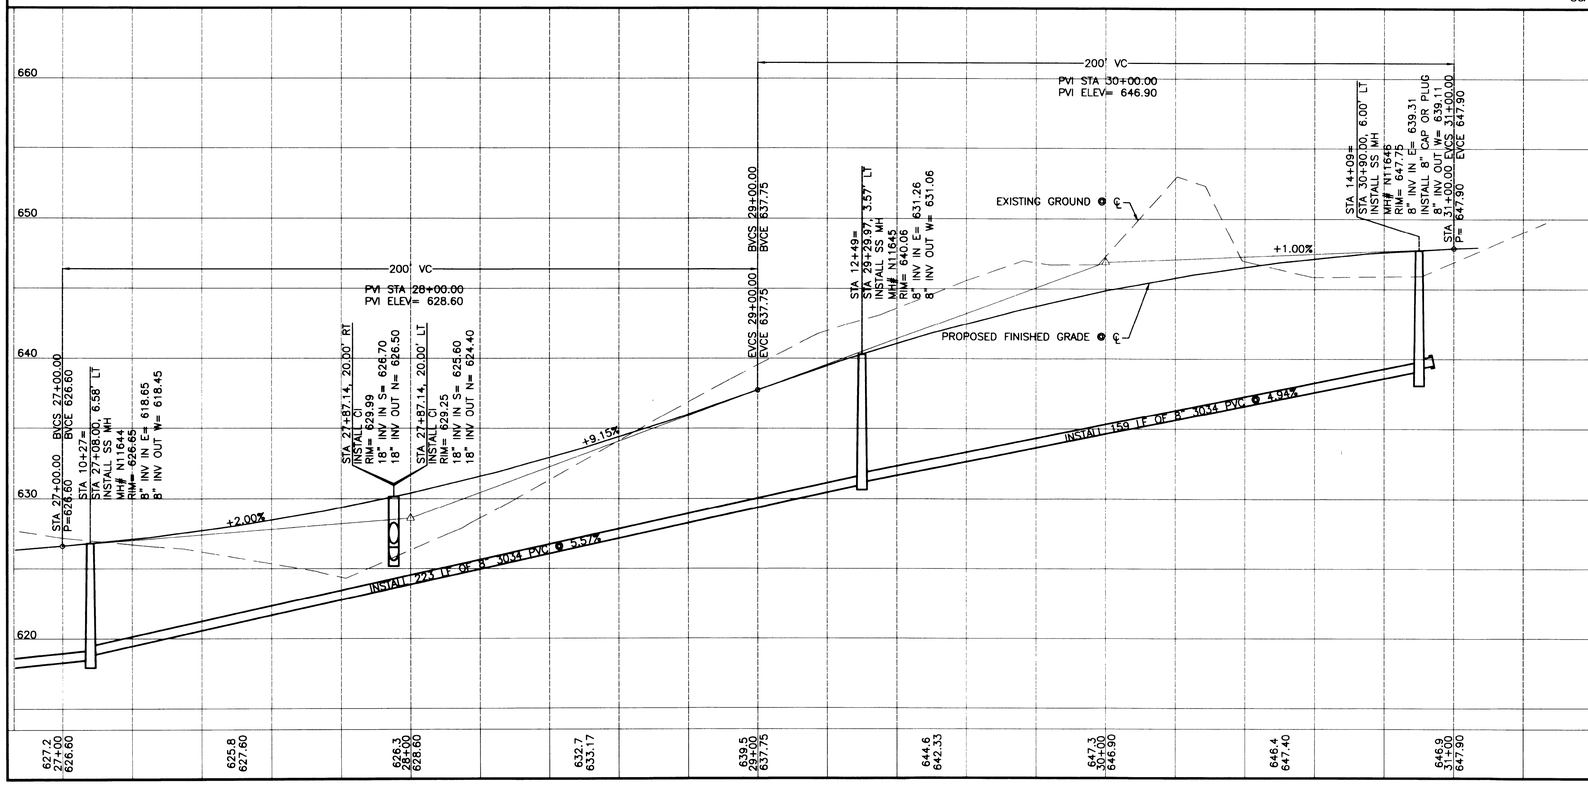

CITY OF ROSEBURG
Public Works Dept.
Development Plan Review
☐ Approved for Development ☐ Approved with Conditions
By
Date

REGISTERED PROFESSIONAL ENGINEER
58073PE
OREGON
MAY 13, 2004
ALEX M. PALM
EXPIRES: 12/31/2006

Rev.	Date	Dwg	Description
1	9/10/04	STH	R.U.S.A. COMMENTS
2	9/14/04	STH	D.C. ENGINEERING COMMENTS
3	11/8/04	ANV	ROSEBURG WATER COMMENTS
4	3/24/06	NRJ	AS-BUILTS

i.e. ENGINEERING
505 SE Main Street
Roseburg, Oregon 97470
PHONE (541) 673-0166
FAX (541) 440-9392
iemail@ieengineering.com

Project Name:
SADDLE BUTTE ESTATES
9TH ADDITION

Title:
STRAUSS AVE. P&P
27+00 - END/DRIVEWAY SEWER

DES	AMP	PROJECT NO. 1968-05
DWG	BWC	DATE: AUGUST 18, 2004
CHK	SNL	SCALE: HORIZ. 1" = 20' VERT. 1" = 5'
APP	SNL	SHEET: 6 OF 11

DO NOT DUPLICATE

00980105

Co. Rd. # 901A

MP 0.98 - 1.05

CO. RD. 901A PLAN & PROFILE

901/48