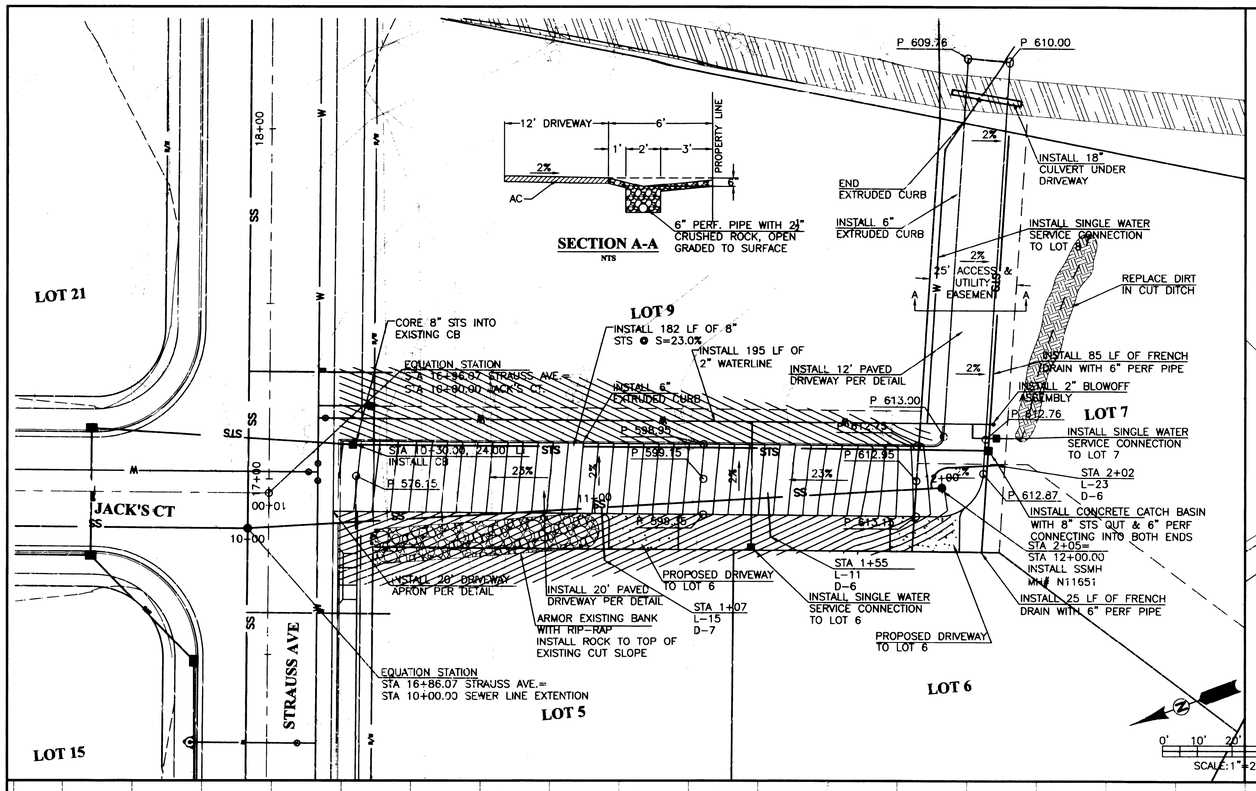

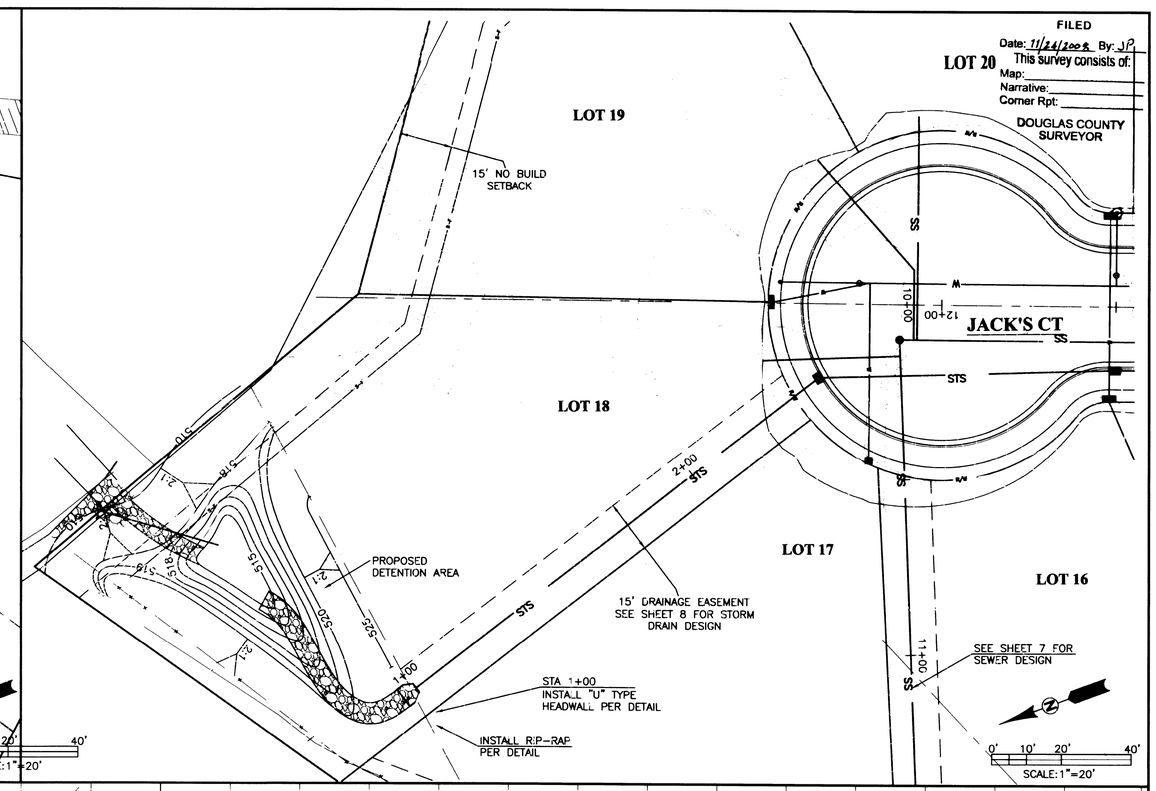

FILED
Date: 11/24/2008 By: JP
This survey consists of:
Map:
Narrative:
Corner Rpt:
DOUGLAS COUNTY SURVEYOR

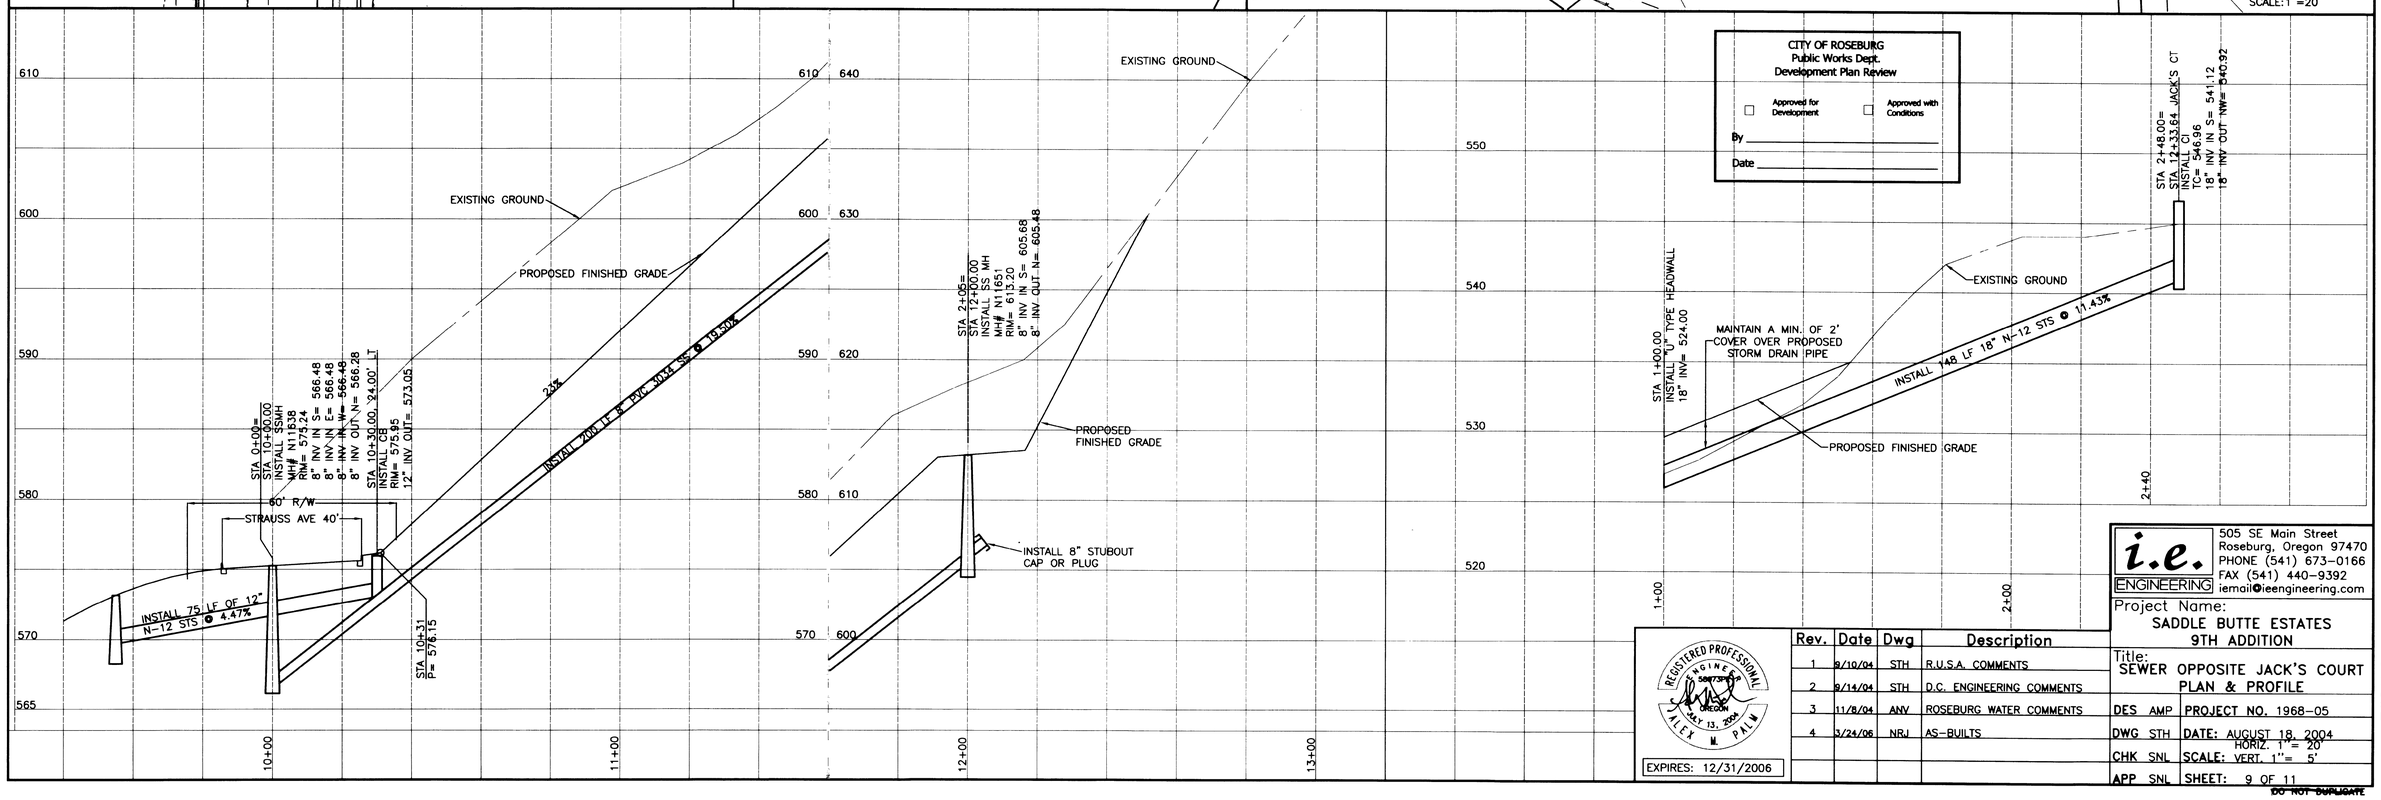

CITY OF ROSEBURG
Public Works Dept.
Development Plan Review

☐ Approved for Development ☐ Approved with Conditions

By _____

Date _____

REGISTERED PROFESSIONAL ENGINEER
OREGON
JULY 13, 2004
ALEX M. PALM
EXPIRES: 12/31/2006

Rev.	Date	Dwg	Description
1	9/10/04	STH	R.U.S.A. COMMENTS
2	9/14/04	STH	D.C. ENGINEERING COMMENTS
3	11/8/04	ANV	ROSEBURG WATER COMMENTS
4	3/24/06	NRJ	AS-BUILTS

i.e. ENGINEERING
505 SE Main Street
Roseburg, Oregon 97470
PHONE (541) 673-0166
FAX (541) 440-9392
iemail@ieengineering.com

Project Name:
SADDLE BUTTE ESTATES
9TH ADDITION

Title:
SEWER OPPOSITE JACK'S COURT
PLAN & PROFILE

DES AMP | PROJECT NO. 1968-05
DWG STH | DATE: AUGUST 18, 2004
CHK SNL | SCALE: HORIZ. 1"= 20' VERT. 1"= 5'
APP SNL | SHEET: 9 OF 11

DO NOT DUPLICATE

R901LSEW

CO. RD. 901A & 901L SEWER

901
51