FILED
Date: 6-28-2005 By: JF
This survey consists of:
Map: ____
Narrative: ____
Corner Rpt: ____
DOUGLAS COUNTY SURVEYOR

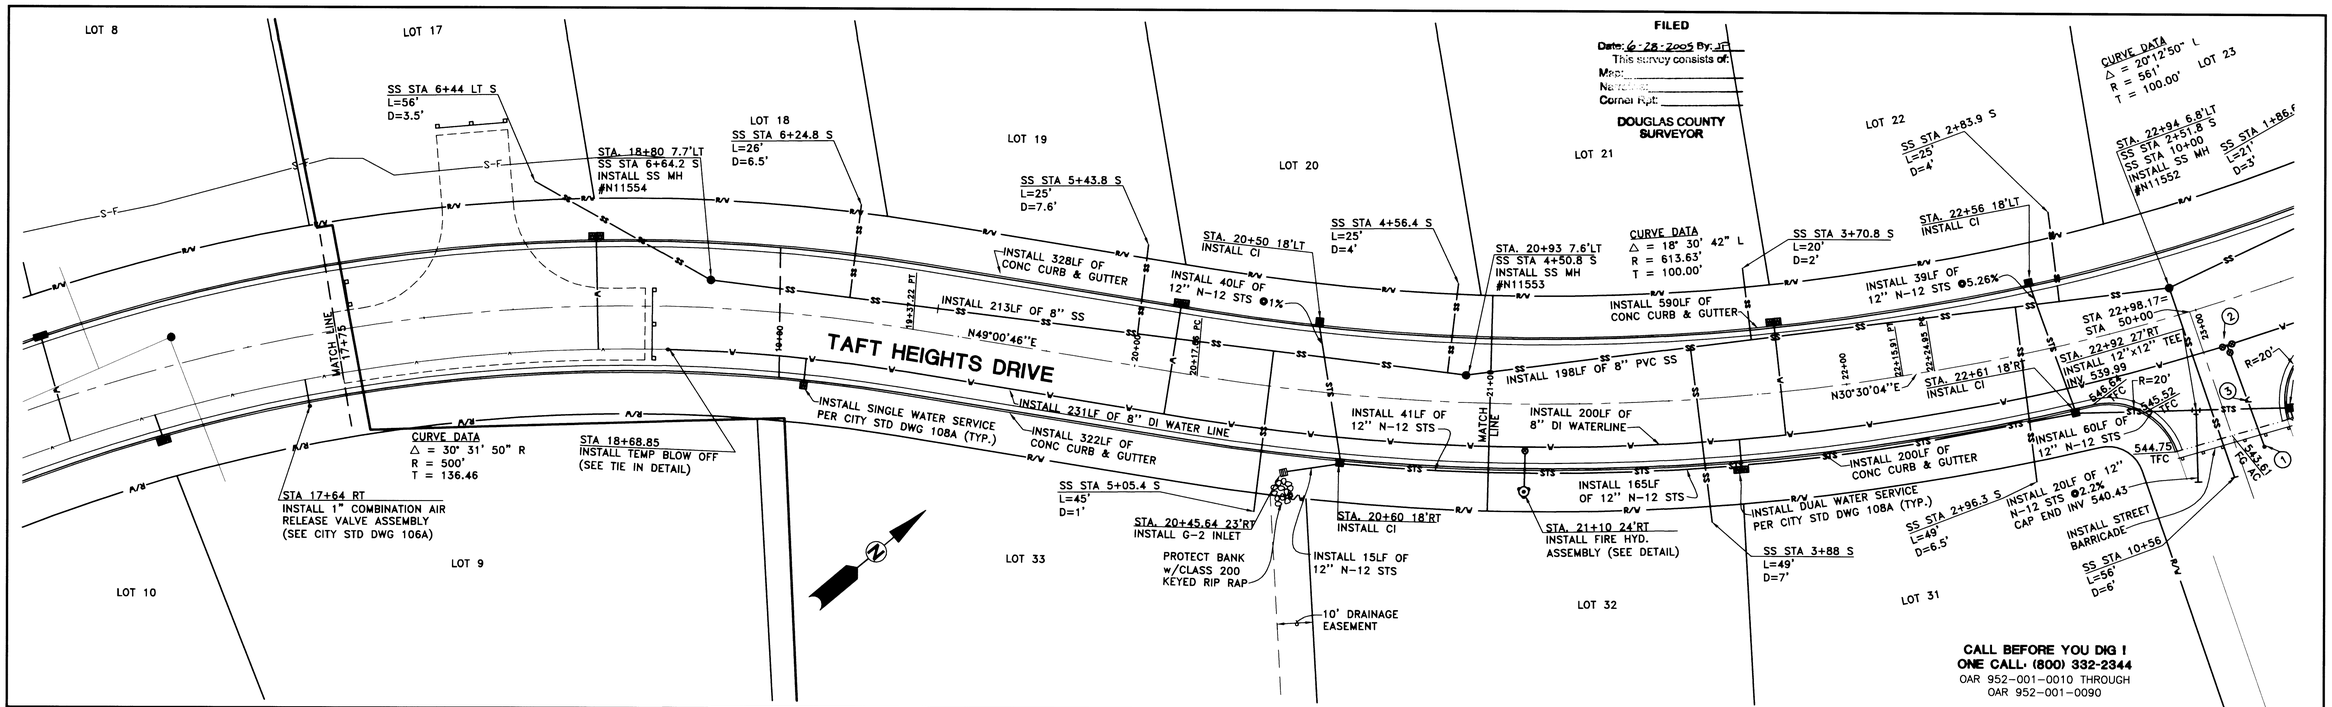

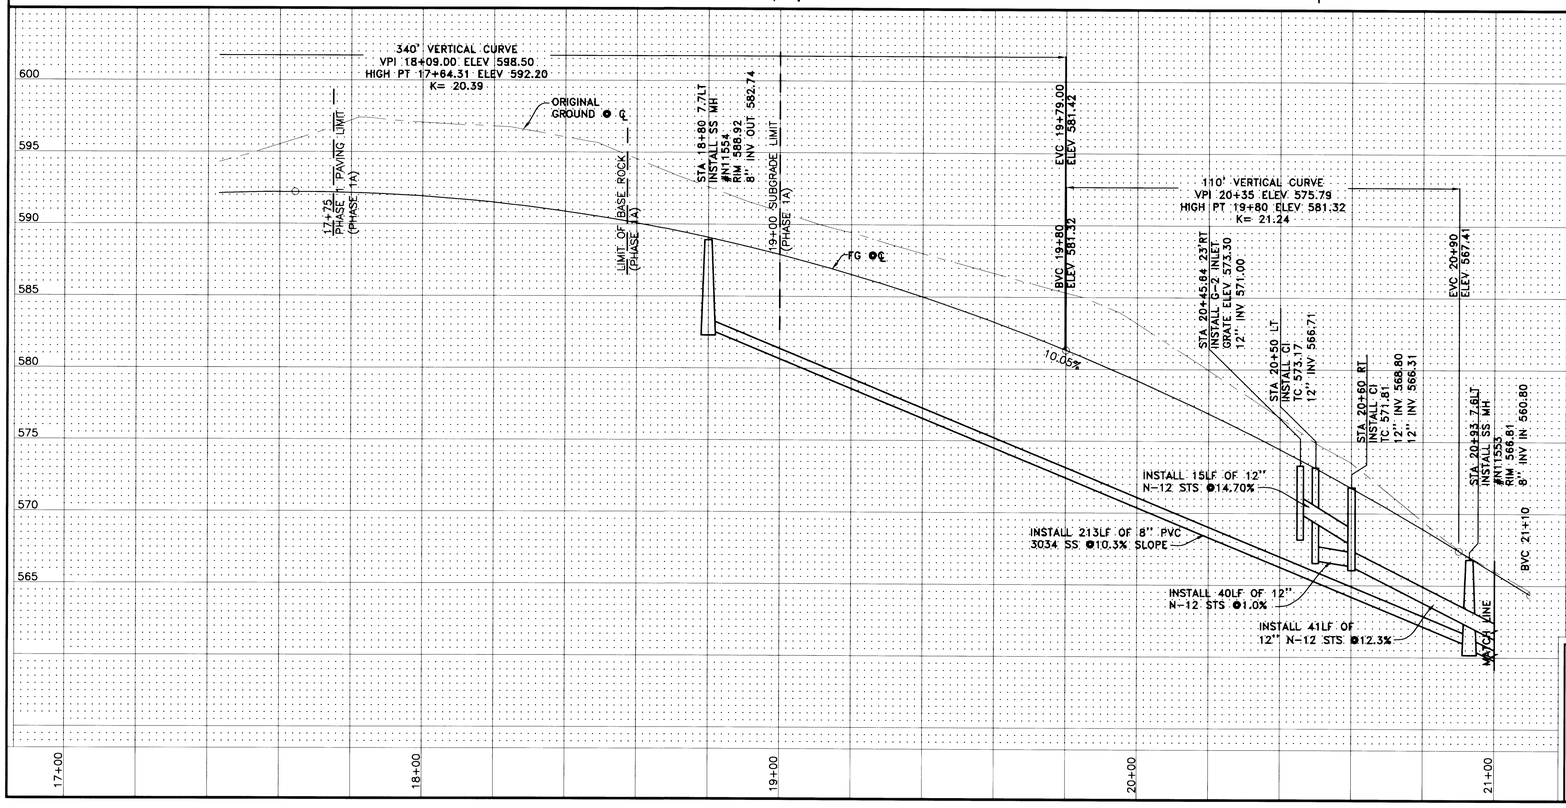

REGISTERED PROFESSIONAL ENGINEER 14928 OREGON JULY 25, 1990 DAVID T. BUHL
EXPIRES: 12/31/2005

Rev.	Date	Dwg	Description
1	4/23/03	BWC	AGENCY REVIEWS
2	8/10/04	ANV	AS-BUILT

i.e. ENGINEERING
741 SE Jackson Street
Roseburg, Oregon 97470
PHONE (541) 673-0166
FAX (541) 440-9392
iemail@ieengineering.com

Project Name: PHASE 2 TAFT SUBDIVISION

Title: PLAN & PROFILE STA 17+75 TO 21+00

DES DTB | PROJECT NO. 140-7812
DWG FLB | DATE: MARCH 27, 2003
CHK SNL | SCALE: HORIZ. 1"= 20' VERT. 1"= 5'
APP DTB | SHEET: 4 OF 13

DO NOT DUPLICATE

00170025

Co. Rd. # 908 M.P. 0.17 - 0.25

CO. RD. #908 PLAN & PROFILE